


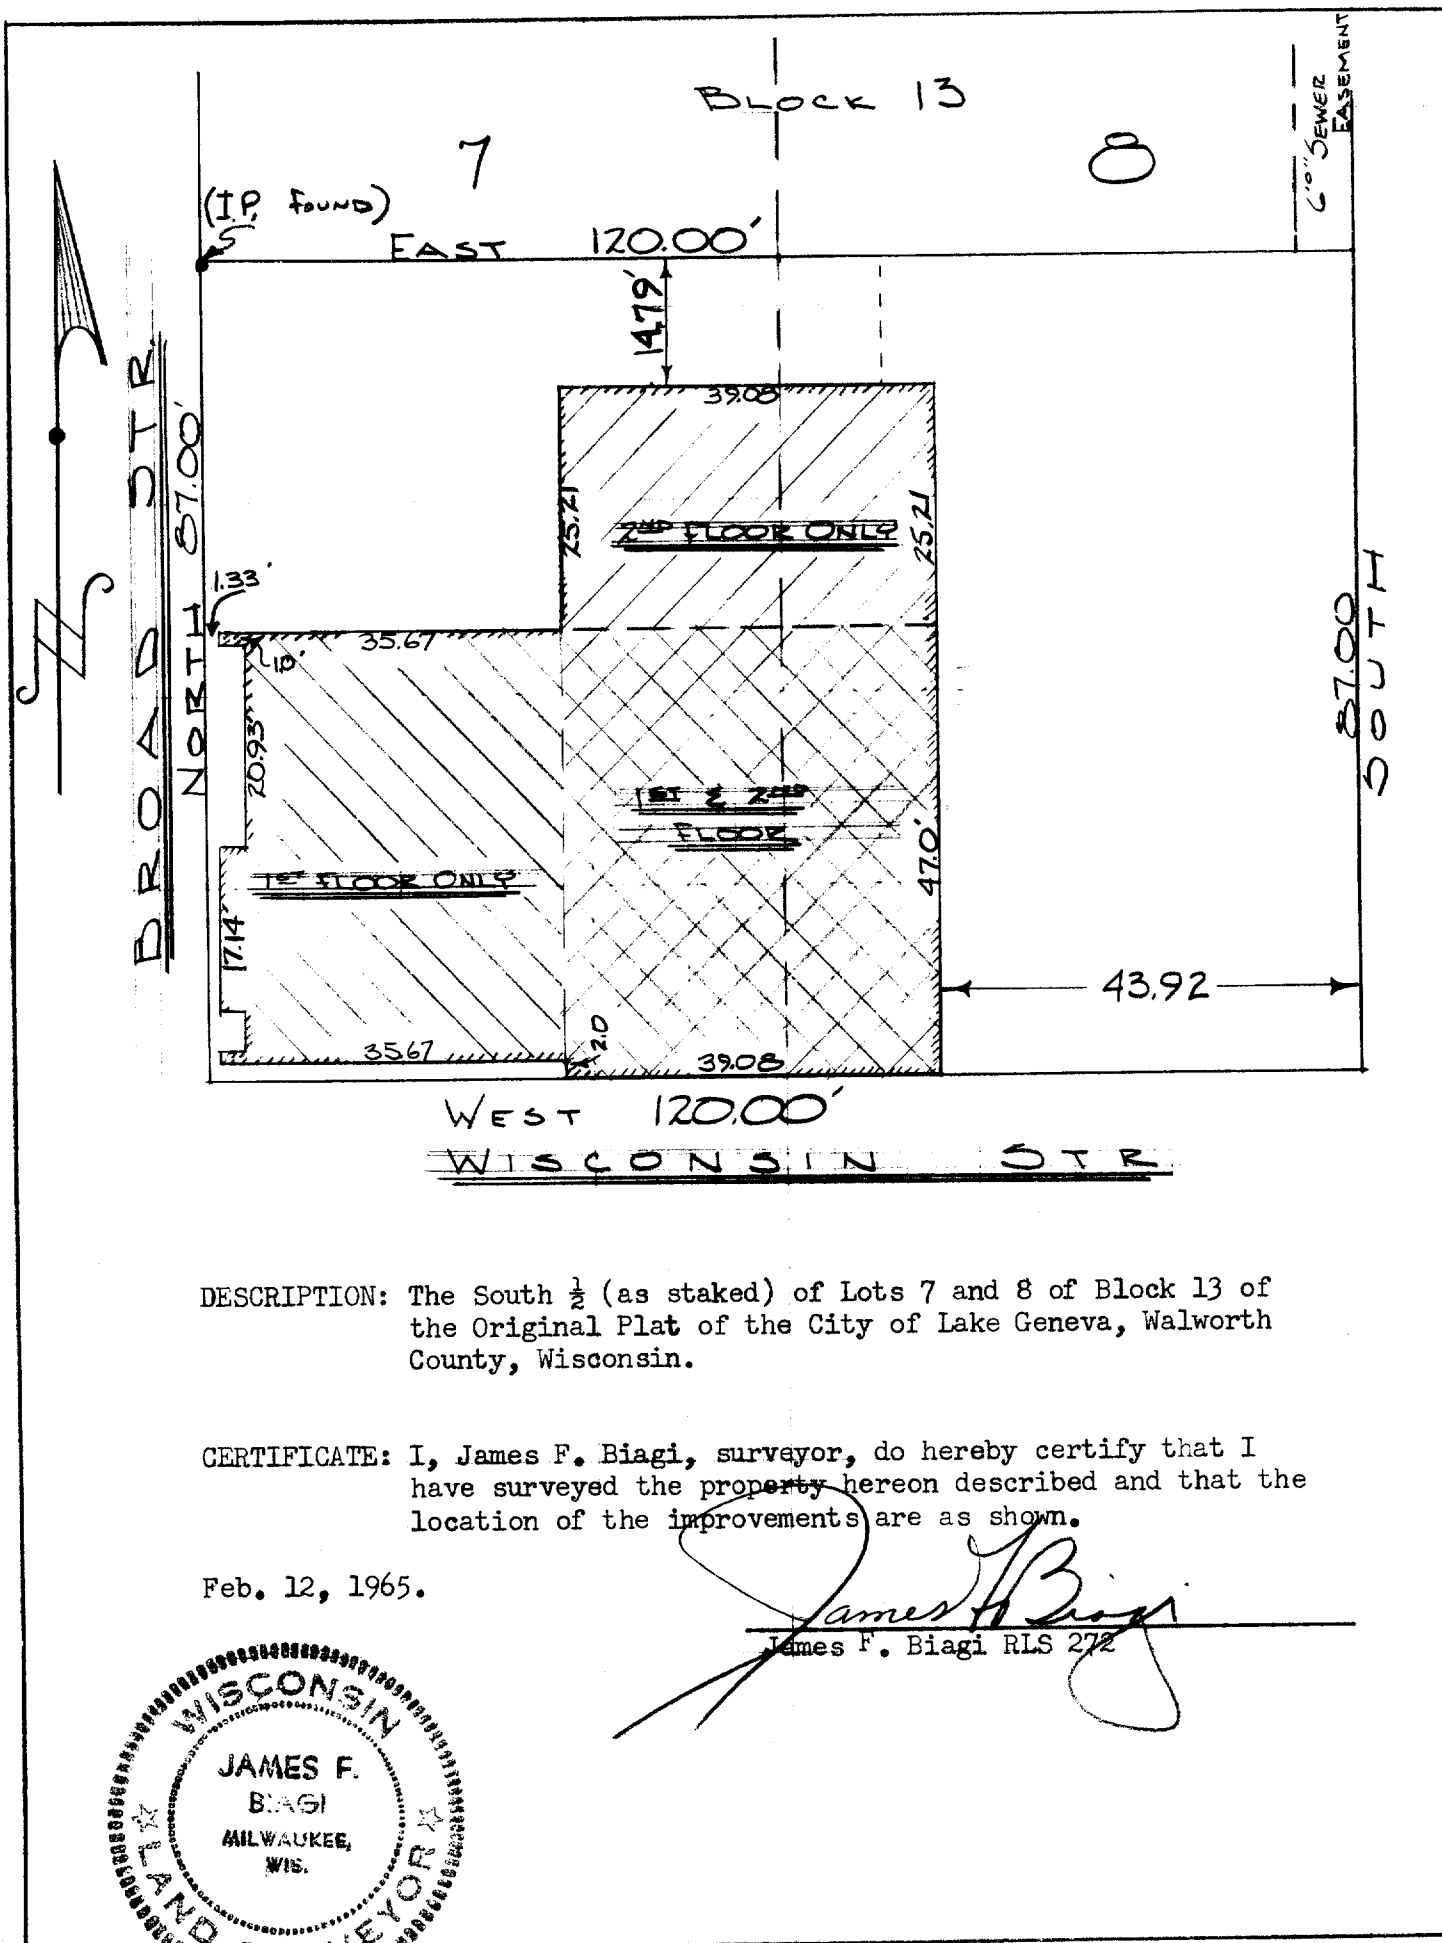

DESCRIPTION: The South $\frac{1}{2}$ (as staked) of Lots 7 and 8 of Block 13 of the Original Plat of the City of Lake Geneva, Walworth County, Wisconsin.

CERTIFICATE: I, James F. Biagi, surveyor, do hereby certify that I have surveyed the property hereon described and that the location of the improvements are as shown.

Feb. 12, 1965.

James F. Biagi RLS 272

