



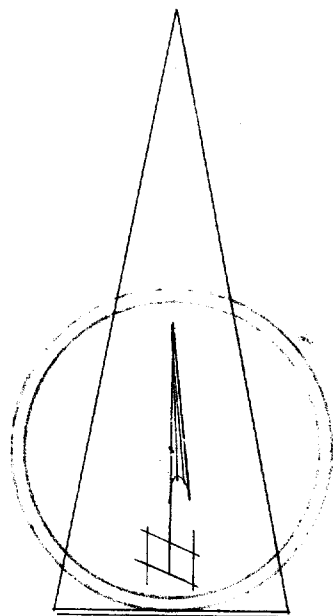

O-INDICATES IRON PIPE

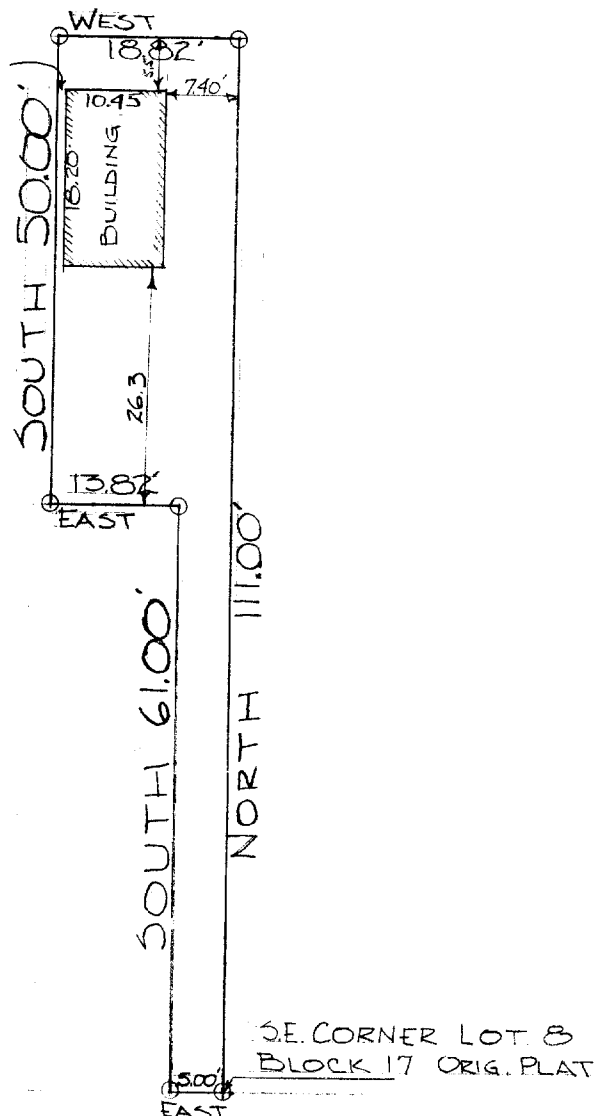

GENEVA STREET

DESCRIPTION: Commencing at the S.E. corner of Lot 8, Block 17 of the Original Plat of the City of Lake Geneva, Walworth County, Wisconsin; thence North 111.00 feet along the east line of said Lot 8, to an iron stake, thence West 18.82 feet to an iron stake, thence South 50.00 feet to an iron stake, thence East 13.82 feet to an iron stake, thence South 61.00 feet to an iron stake in the south line of the aforesaid Block 17; thence East along the south line of said Block 17; 5.00 feet to the place of beginning.

CERTIFICATE: I, James F. Biagi, Surveyor, do hereby certify that I, have surveyed the property hereon described and that the location of the improvements are as shown.

Signed and sealed this 31st day of August, 1963.

James F. Biagi, RLS 272
Elkhorn, Wisconsin.



OP-170A

7-184B