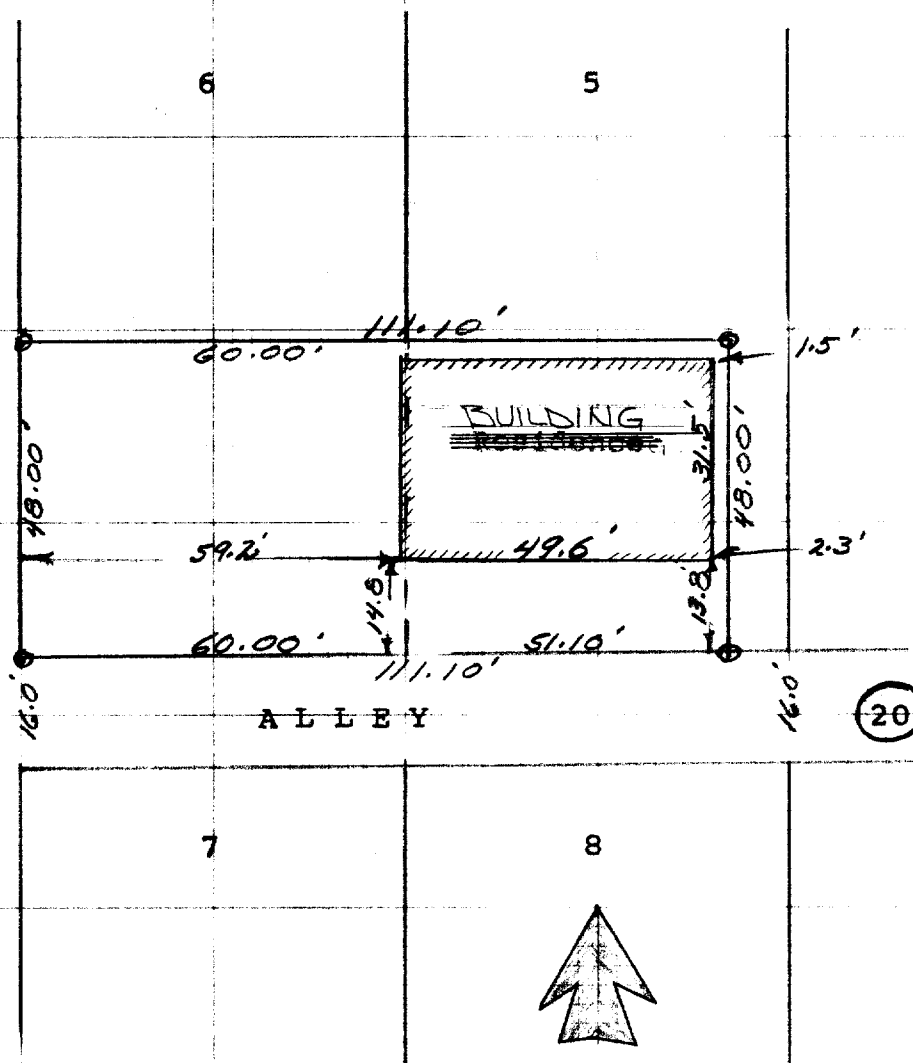


#80-67

STREET
MAXWELL

N O R T H


● Iron Pipe

DESCRIPTION: The South 48 feet of Lot 6 and the South 48 feet of the West 51.1 feet of Lot 5 of Block 20 of the Original Plat of the City of Lake Geneva, Walworth County, Wisconsin.

CERTIFICATE: I, James F. Biagi, surveyor do hereby certify that I have surveyed the property hereon described, on this the 26th day of May, 1967.

Date: May 27th 1967

James F. Biagi
James F. Biagi, RLS 272
Elkhorn, Wisconsin.

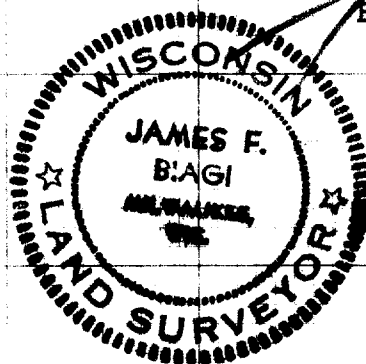

PP-190A

7-187B