
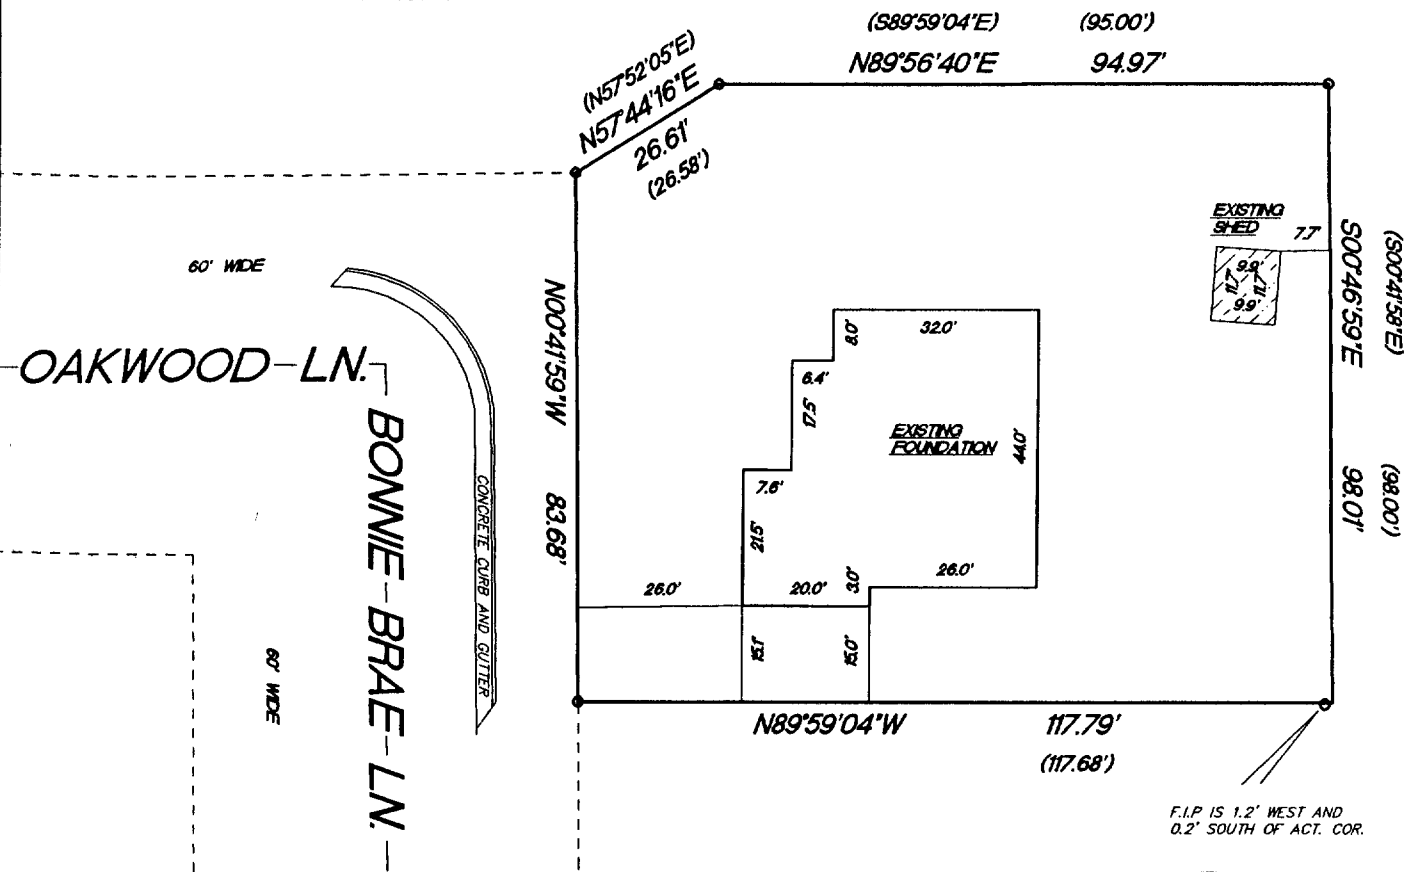



PLAT OF SURVEY

LOT 1, IN MERRILY-ON SUBDIVISION, located in the Northeast ¼ of the Northeast ¼ of Section 1, Town 1 North, Range 17 East, City of Lake Geneva, Walworth County, Wisconsin.

Surveyed for: Bielinski Bros. Builders/ Dorothy Philip

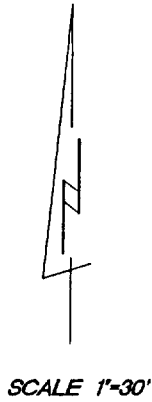


- FOUND 1" IRON PIPE
- () PLATTED AS DIMENSIONS

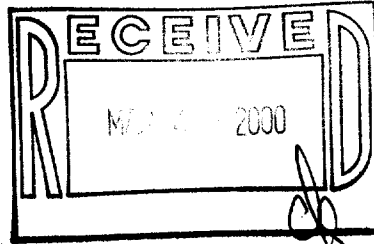

"I hereby certify that I have surveyed the above described property and that the above map is a true representation thereof and shows the size and location of the property, its exterior boundaries, the location of all visible structures and dimension of all principal buildings thereon, boundary fences, apparent easements, roadways and encroachments if any."

"This survey is made for the use of the present owners of the property, and also those who purchase, mortgage or guarantee the title thereto within one year from date hereof."

KETTLE MORaine SURVEYING
W356 S9050 Godfrey Lane
Eagle Wisconsin 53119
P.O. Box 357
(262) 594-3484
Terrance E. Pisarek R.L.S.

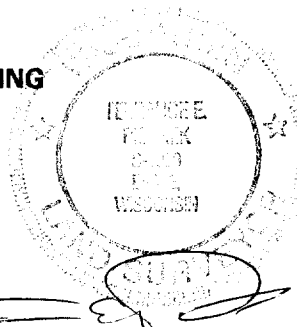

THIS IS NOT AN ORIGINAL SURVEY UNLESS THE SEAL IS RED.

REV. 2/21/00
1/4/00

DATE

TEP/DW

FIELD WORK BY

TEP

DRAWN BY

99306

JOB NUMBER

ZMERR-1

087-1884