

PLAT OF SURVEY



PATHFINDER SURVEYING
FORMERLY KOLB LAND CONSULTING
929 WILLIAMS ST. LAKE GENEVA, WI.
(262) 248-3697

ORDERED BY : ORION PARTNERS
P.O. BOX 1030
LAKE GENEVA, WI. 53147

DATE: 3-24-2000

DESCRIPTION: THE EAST 44.00 FEET OF LOTS 14 AND 15 OF BLOCK 3
OF GOODSSELL'S SUBDIVISION OF BLOCK 3 OF THE PLAT
OF THE VILLAGE OF GENEVA, NOW CITY OF LAKE GENEVA,
WALWORTH COUNTY, WISCONSIN.

THE WEST 65.00 FEET OF THE EAST 109.00' OF LOTS 14
AND 15 OF BLOCK 3 OF GOODSSELL'S SUBDIVISION OF
BLOCK 3 OF THE VILLAGE, NOW CITY OF LAKE GENEVA,
WALWORTH COUNTY, WISCONSIN.

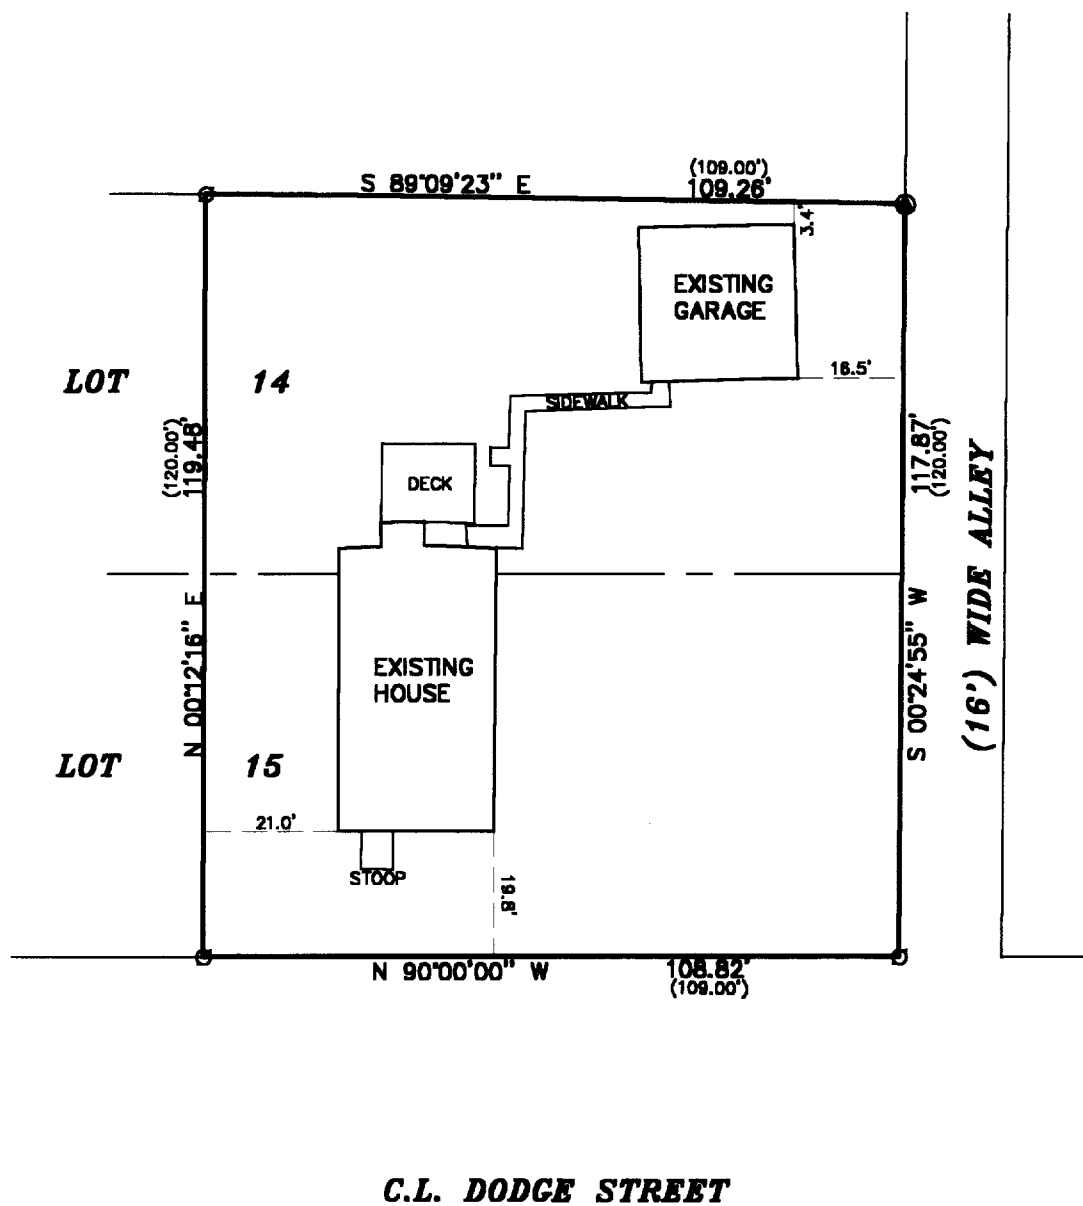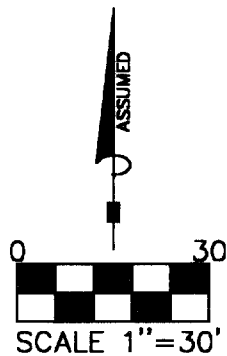

C.L. DODGE STREET



LEGEND

- FOUND IRON PIPE
- SET P.K. NAIL
- (XXXX) RECORDRD
- X— FENCE

THE ABOVE MAP IS A TRUE REPRESENTATION THEREOF AND
SHOWS THE SIZE AND LOCATION OF ALL THE PROPERTY,
EXTERIOR BOUNDARIES, THE LOCATION OF ALL VISIBLE
BOUNDARY FENCES, APPARENT EASEMENTS, ROADWAYS
AND VISIBLE ENCROACHMENTS, IF ANY.

THIS SURVEY IS MADE FOR THE USE OF THE PRESENT
OWNERS OF THE PROPERTY, AND ALSO THOSE WHO
PURCHASE, MORTGAGE OR GURANTEE TITLE THERETO
WITHIN ONE (1) YEAR FROM DATE HERETO.

John P. Krott
JOHN P. KROTT, R.L.S. 2258

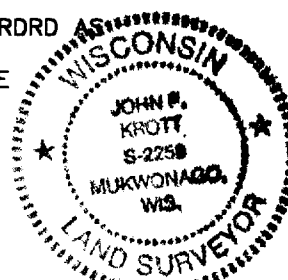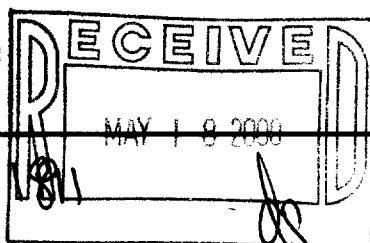

NOTE: THIS IS NOT A CERTIFIED COPY
UNLESS SEAL IS IN RED.
JOB NUMBER 00056 ZGD 12

ZGD-12

007-