


#116-63

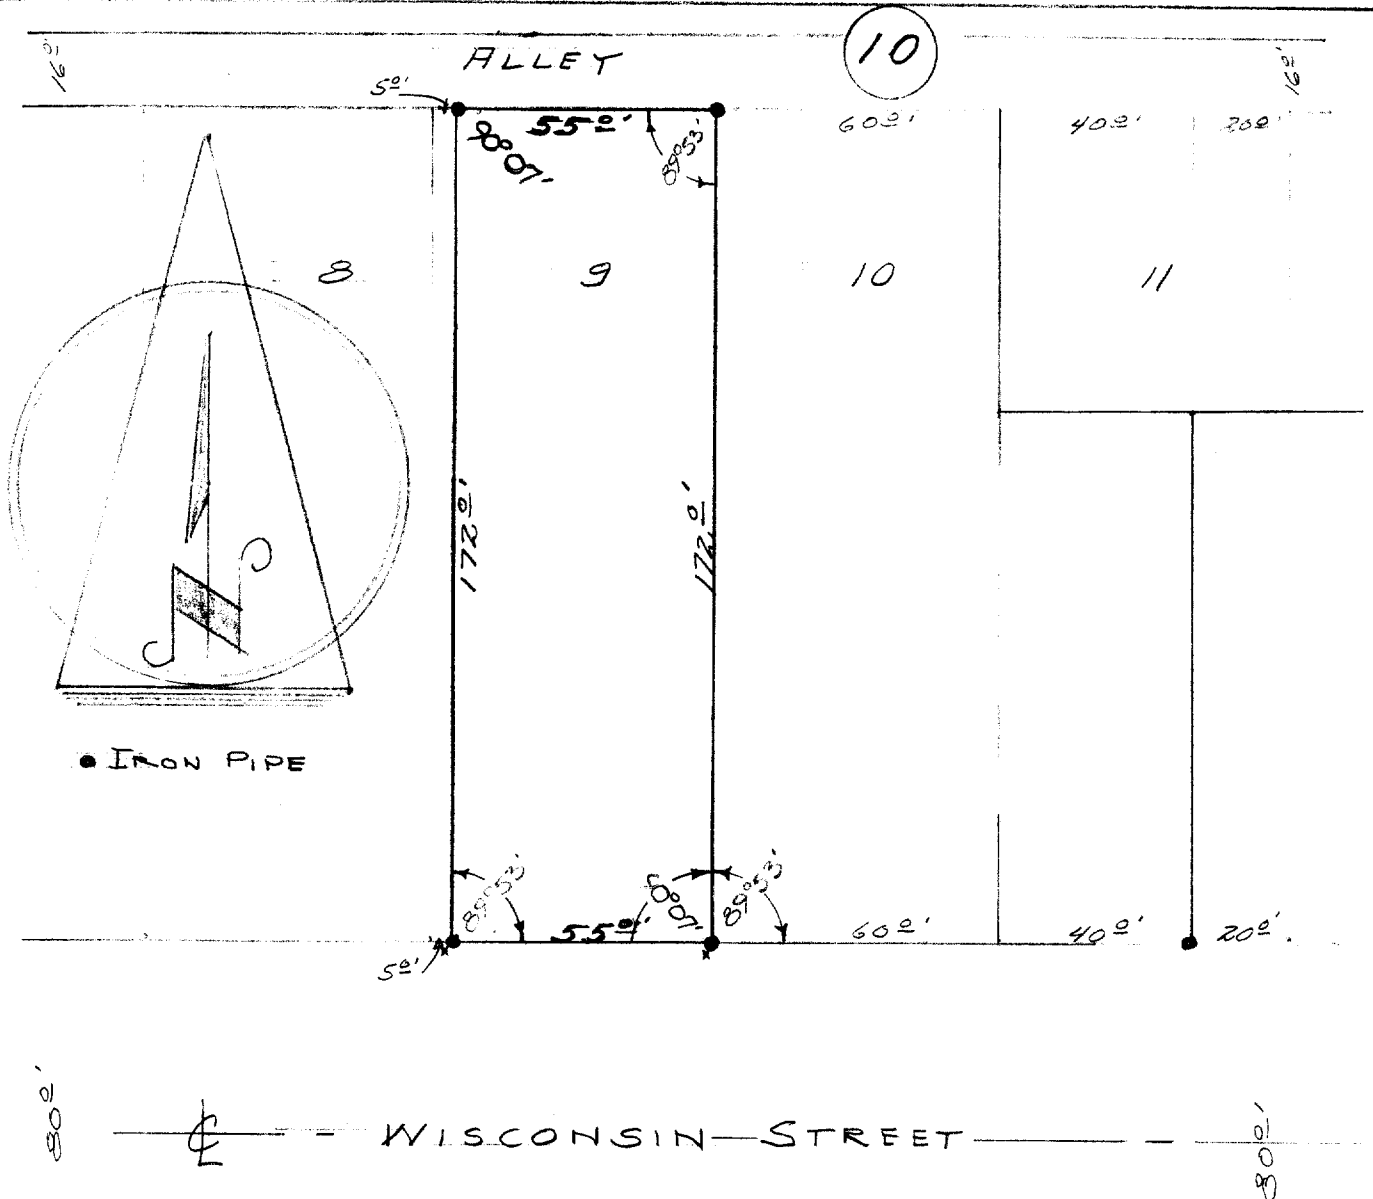


DESCRIPTION:

The East 55.00 feet of Lot 9, Block 10 of the Original Plat of the Village (now city) of Lake Geneva, Walworth County, Wisconsin.

CERTIFICATE:

I, James F. Biagi, surveyor, do hereby certify that I have surveyed the property hereon described.

September 25th 1963.

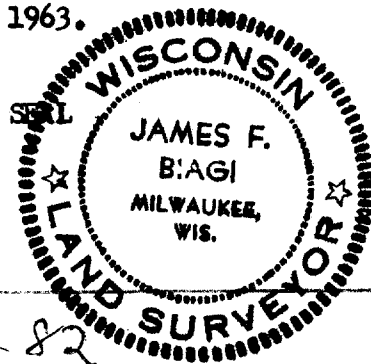

James F. Biagi. RLS 272
Elkhorn, Wisconsin.

6P-82

7-189B