

Note: All measurements on this Plat are taken from the East end of the Block and are substantiated by occupation lines to the east and west, however there exists an overrun in the Block of 13". This 13" is assumed to be all in the west end of Lot #6.

NO MARKER GAS MAIN

20.00

NO MARKER BECAUSE OF UNDERGROUND GAS MAIN

W 1/3 OF LOT 4

12" CONC. BLOCK WALL

WIDTH OF 12" CONC. BLK.
GARAGE IS 22'5" (LOT WIDTH
IS 21'6")

172.00'

13"

12" BRICK WALL

MILLAS PROP W 1/3 LOT 4

12" BRICK WALL

172.00'

12"

PROP. LINE IS 12 1/2"
EAST OF 12" WALL

20.00'


CROSS IN WALL

PROP. LINE IS 1/2" WEST
OF 12" BRICK WALL

Description: The West 20.00 feet of Lot 4 of Block 30 of the Original
Plat of the City of Lake Geneva, Walworth County, Wisconsin.

Plat of Survey April 3, 1965

by

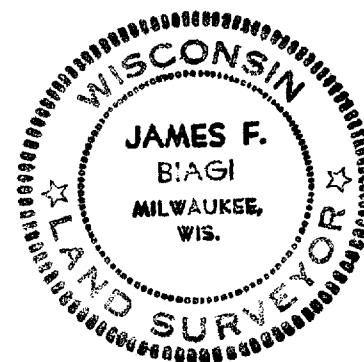

James F. Biagi RLS 272

