


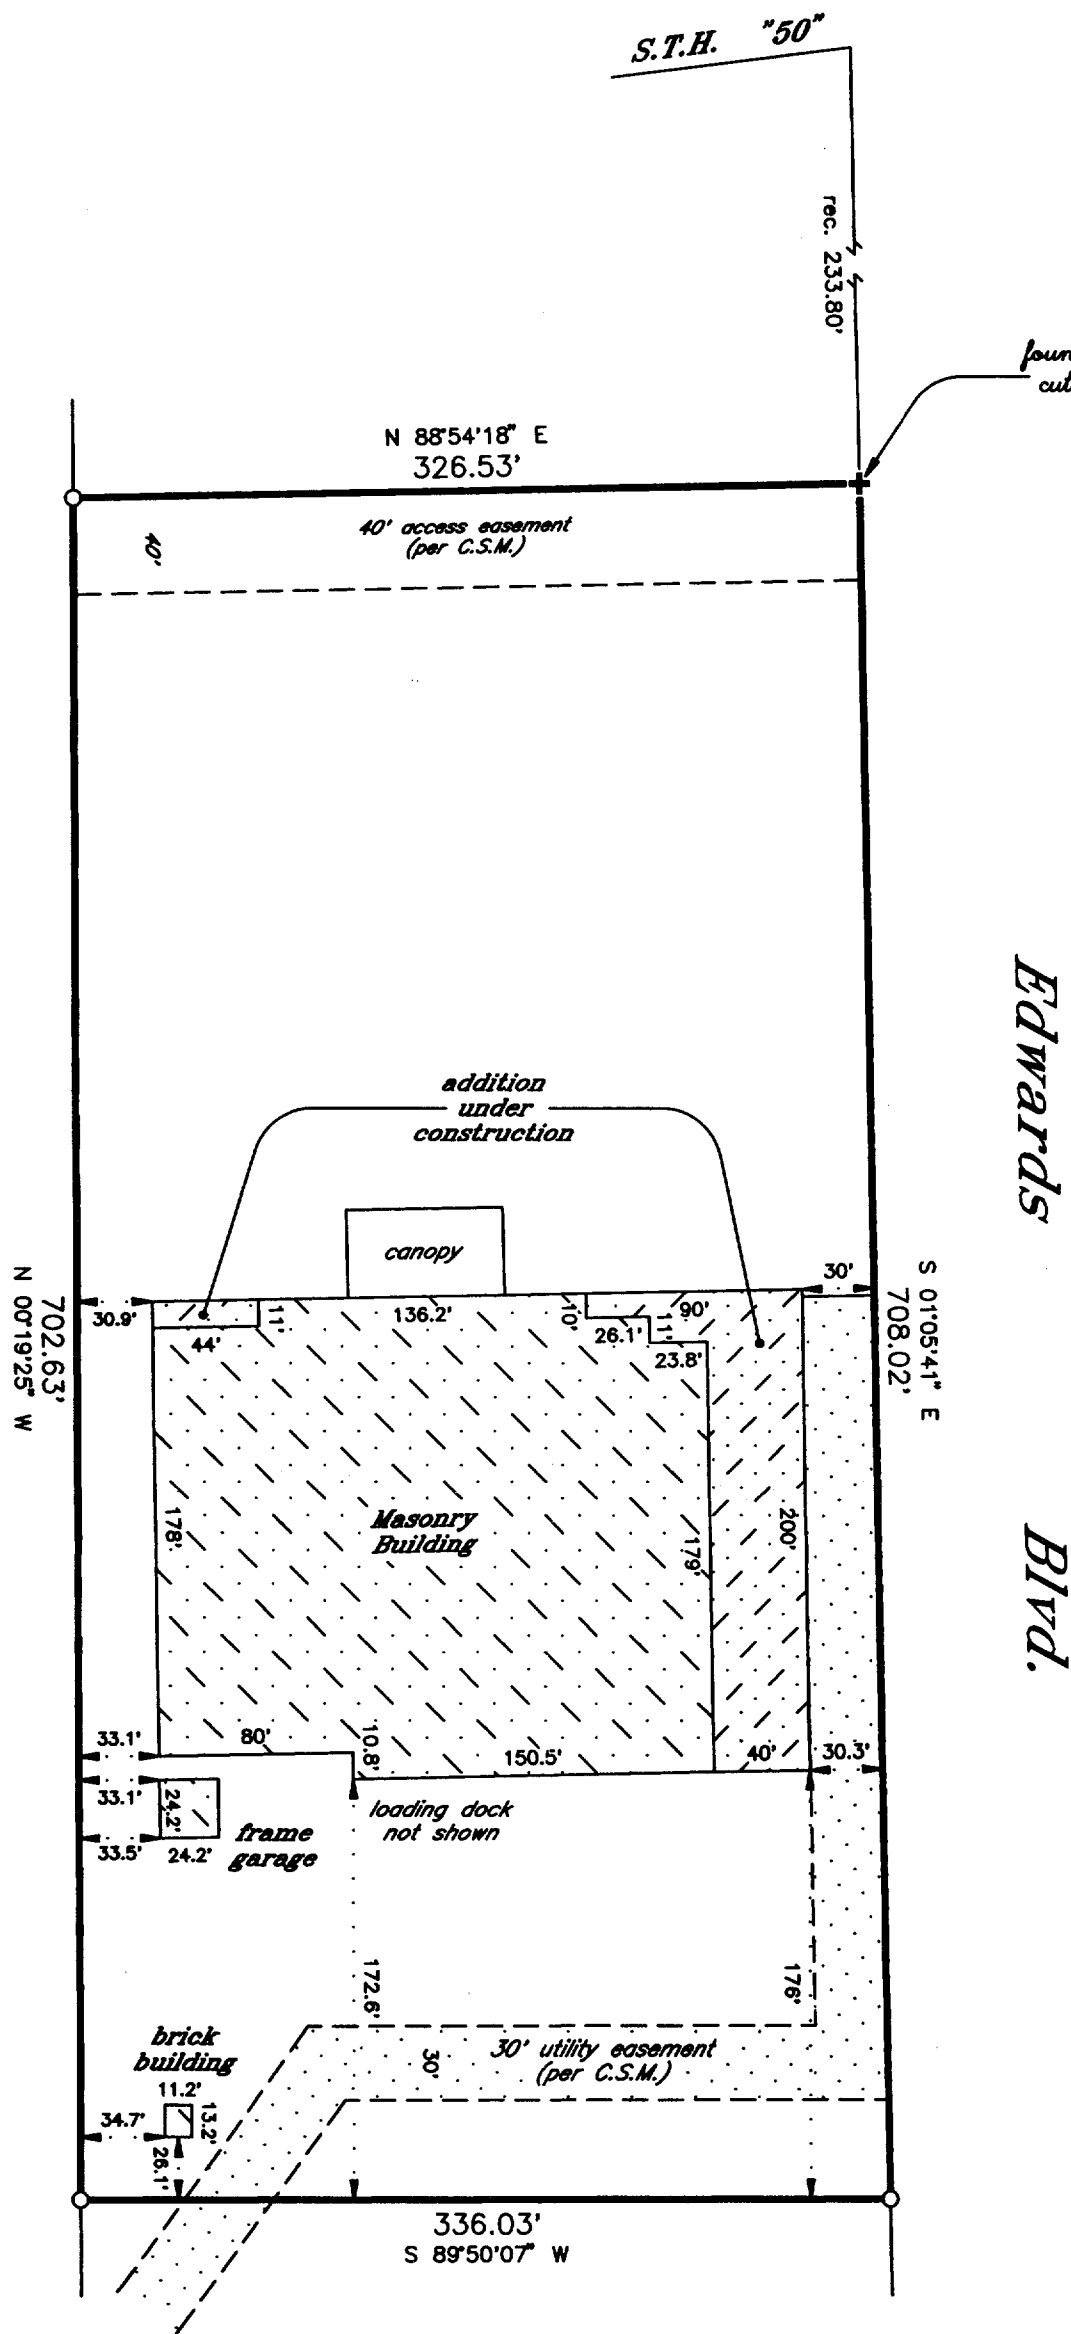


Plat of Survey of
LOT 1 OF
CERTIFIED SURVEY MAP NO. 1961
in NW1/4 Section 31-2-18

CITY OF LAKE GENEVA
WALWORTH COUNTY, WIS.


-for-
Central Contractors



Scale
1"=80'

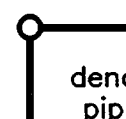


denotes iron
pipe found
(unless noted)

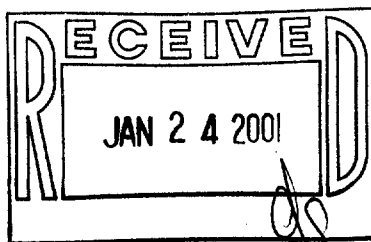

Refer to a current title report for a complete legal description and for easements and restrictions which may affect the use of this site.

J.K.R. SURVEYING, INC.
6100 75TH STREET SUITE 3
KENOSHA, WI 53142

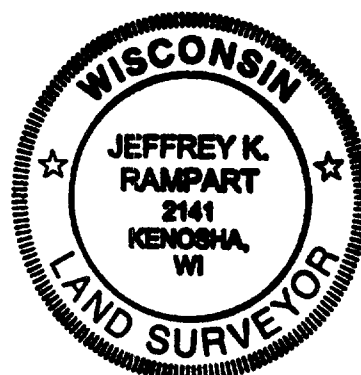

I hereby certify that
this property was
surveyed under my
direction and this
plat is a true re-
presentation thereof.

Jeffrey K. Rampart
Reg. Land Surveyor
January 22, 2001

007-1932
ZA-1961-1