


1761-4

57-15

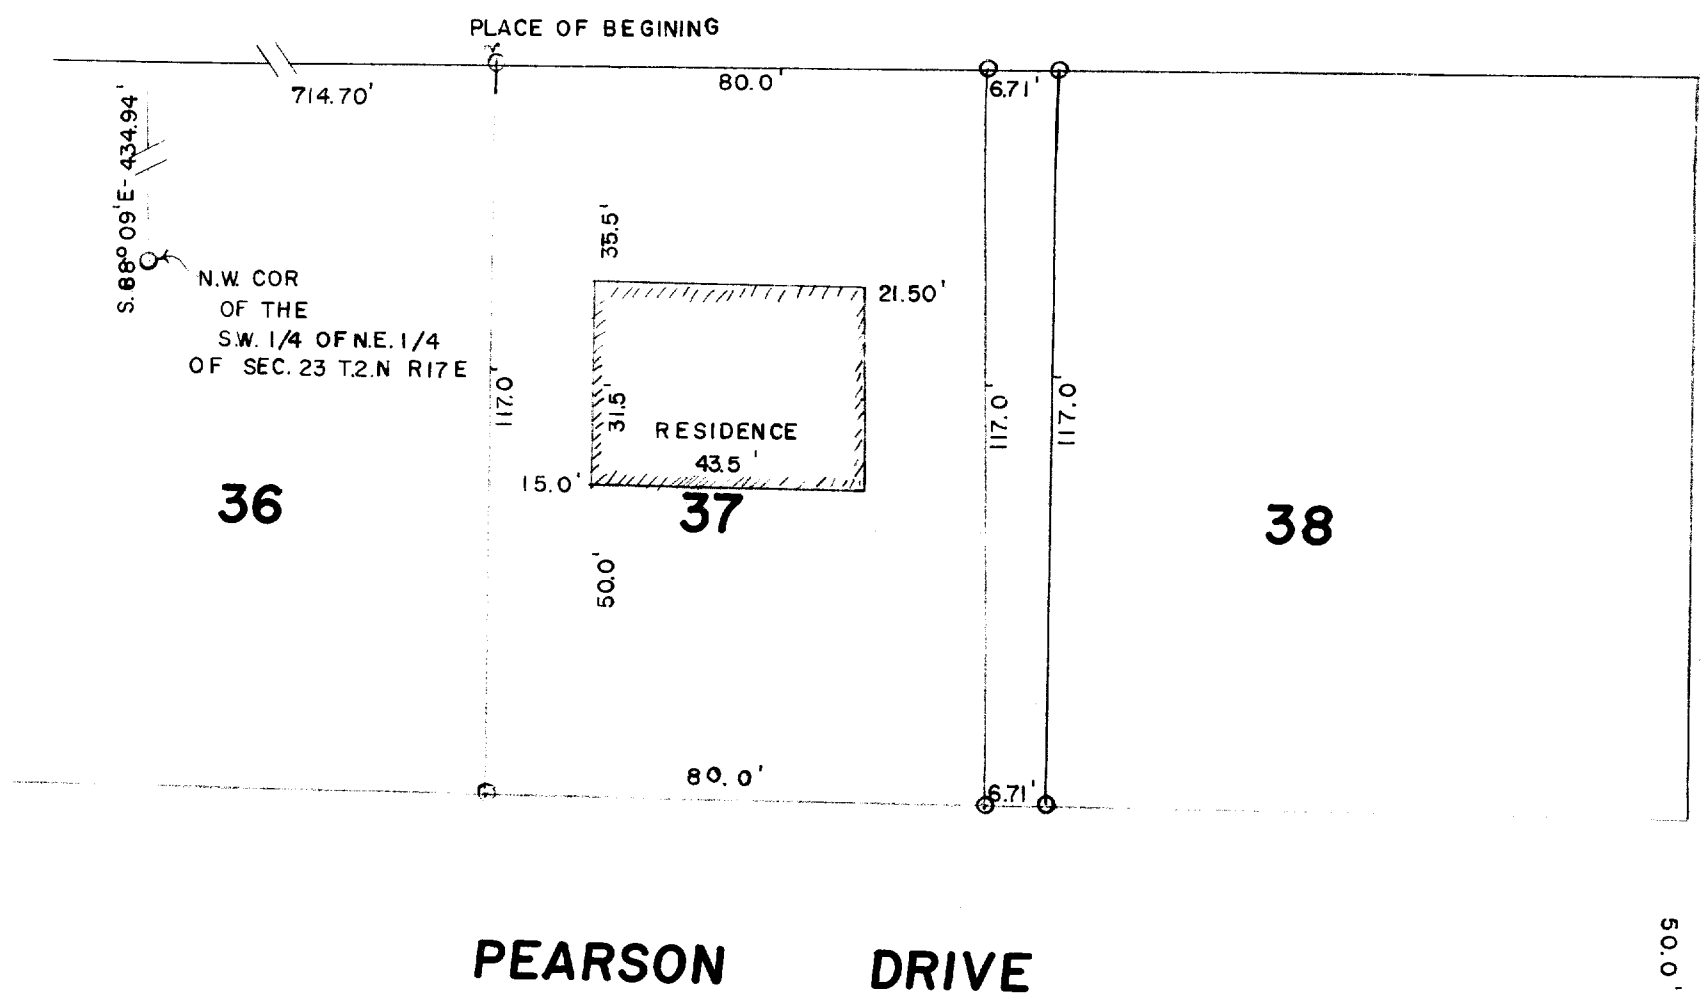

P-37

7-1988 B B

57-15