


HAROLD H. KOLB

REGISTERED PROFESSIONAL LAND SURVEYOR
LAKE GENEVA, WISCONSIN

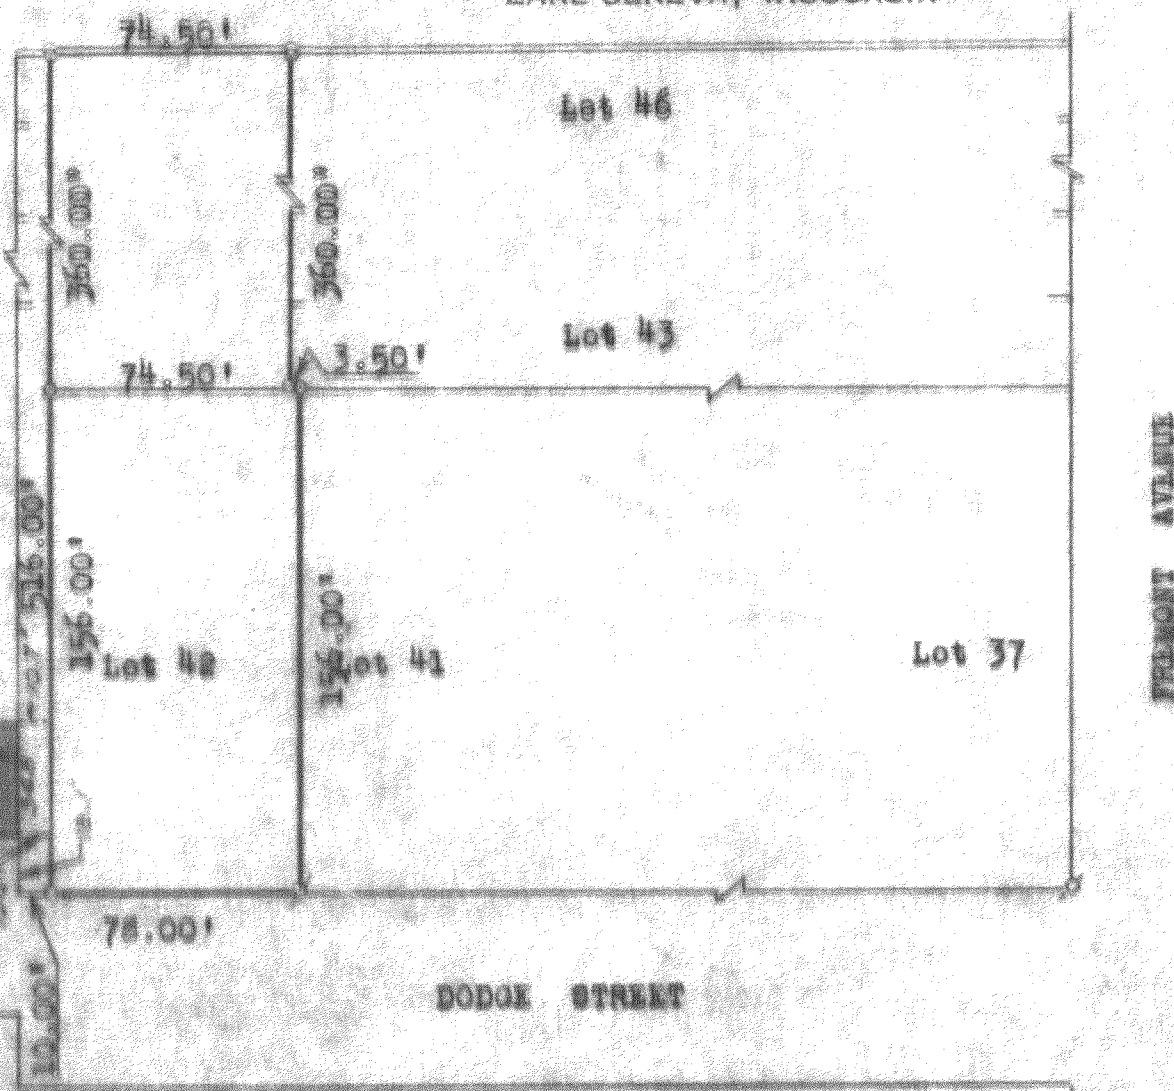

PLAT OF SURVEY OF

The East 78.00 feet of Lot 42 and the East 74.50' of the West 84.50 feet of Lots 43, 44, 45, and 46 of David O Marsh's Addition to the Village (now City) of Lake Geneva, Walworth County, Wisconsin.

LEGEND

- IRON PIPE FOUND
- — IRON PIPE PLACED
- — CONCRETE MONUMENT
- ✕ — SPIKE



I, HAROLD H. KOLB, DO HEREBY CERTIFY THAT I HAVE SURVEYED THE PROPERTY HEREON DESCRIBED ACCORDING TO THE OFFICIAL RECORDS, AND THAT THE PLAT HEREON IS A CORRECT REPRESENTATION OF THE LOT LINES.

Harold H. Kolb
HAROLD H. KOLB

SCALE: 1" = 60' WISCONSIN REGISTERED LAND SURVEYOR, S-187
DATE December 19, 1964

7-195