


PREPARED FOR:
DAVID BRAID
110 WEST STREET
UNIT #7
LAKE GENEVA, WI
53147


PLAT OF SURVEY

J.E. SURVEYING, INC.
10705 WILLOWBEND LANE
LAKE GENEVA, WI 53147
262-545-3600

DESCRIPTION: THE SOUTH 1/3 OF LOTS NUMBERED SIX (6) AND SEVEN (7) AND THE SOUTH 1/3 OF THE WEST 1/2 OF LOT NUMBER EIGHT (8) IN BLOCK NUMBER TWO (2) OF E.D. PHILLIPS SUBDIVISION IN THE CITY OF LAKE GENEVA, WALWORTH COUNTY, WISCONSIN

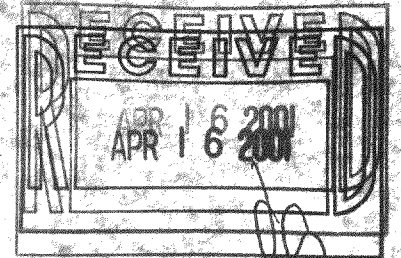


ELEVATION KEY	
LETTER	ELEVATION IN FEET
A	941.78
B	933.91
C	927.13
D	927.68
E	927.28
F	927.58
G	927.54
H	927.89
I	931.57
J	931.35
K	931.11
L	931.04
M	925.85
N	925.95
O	926.34

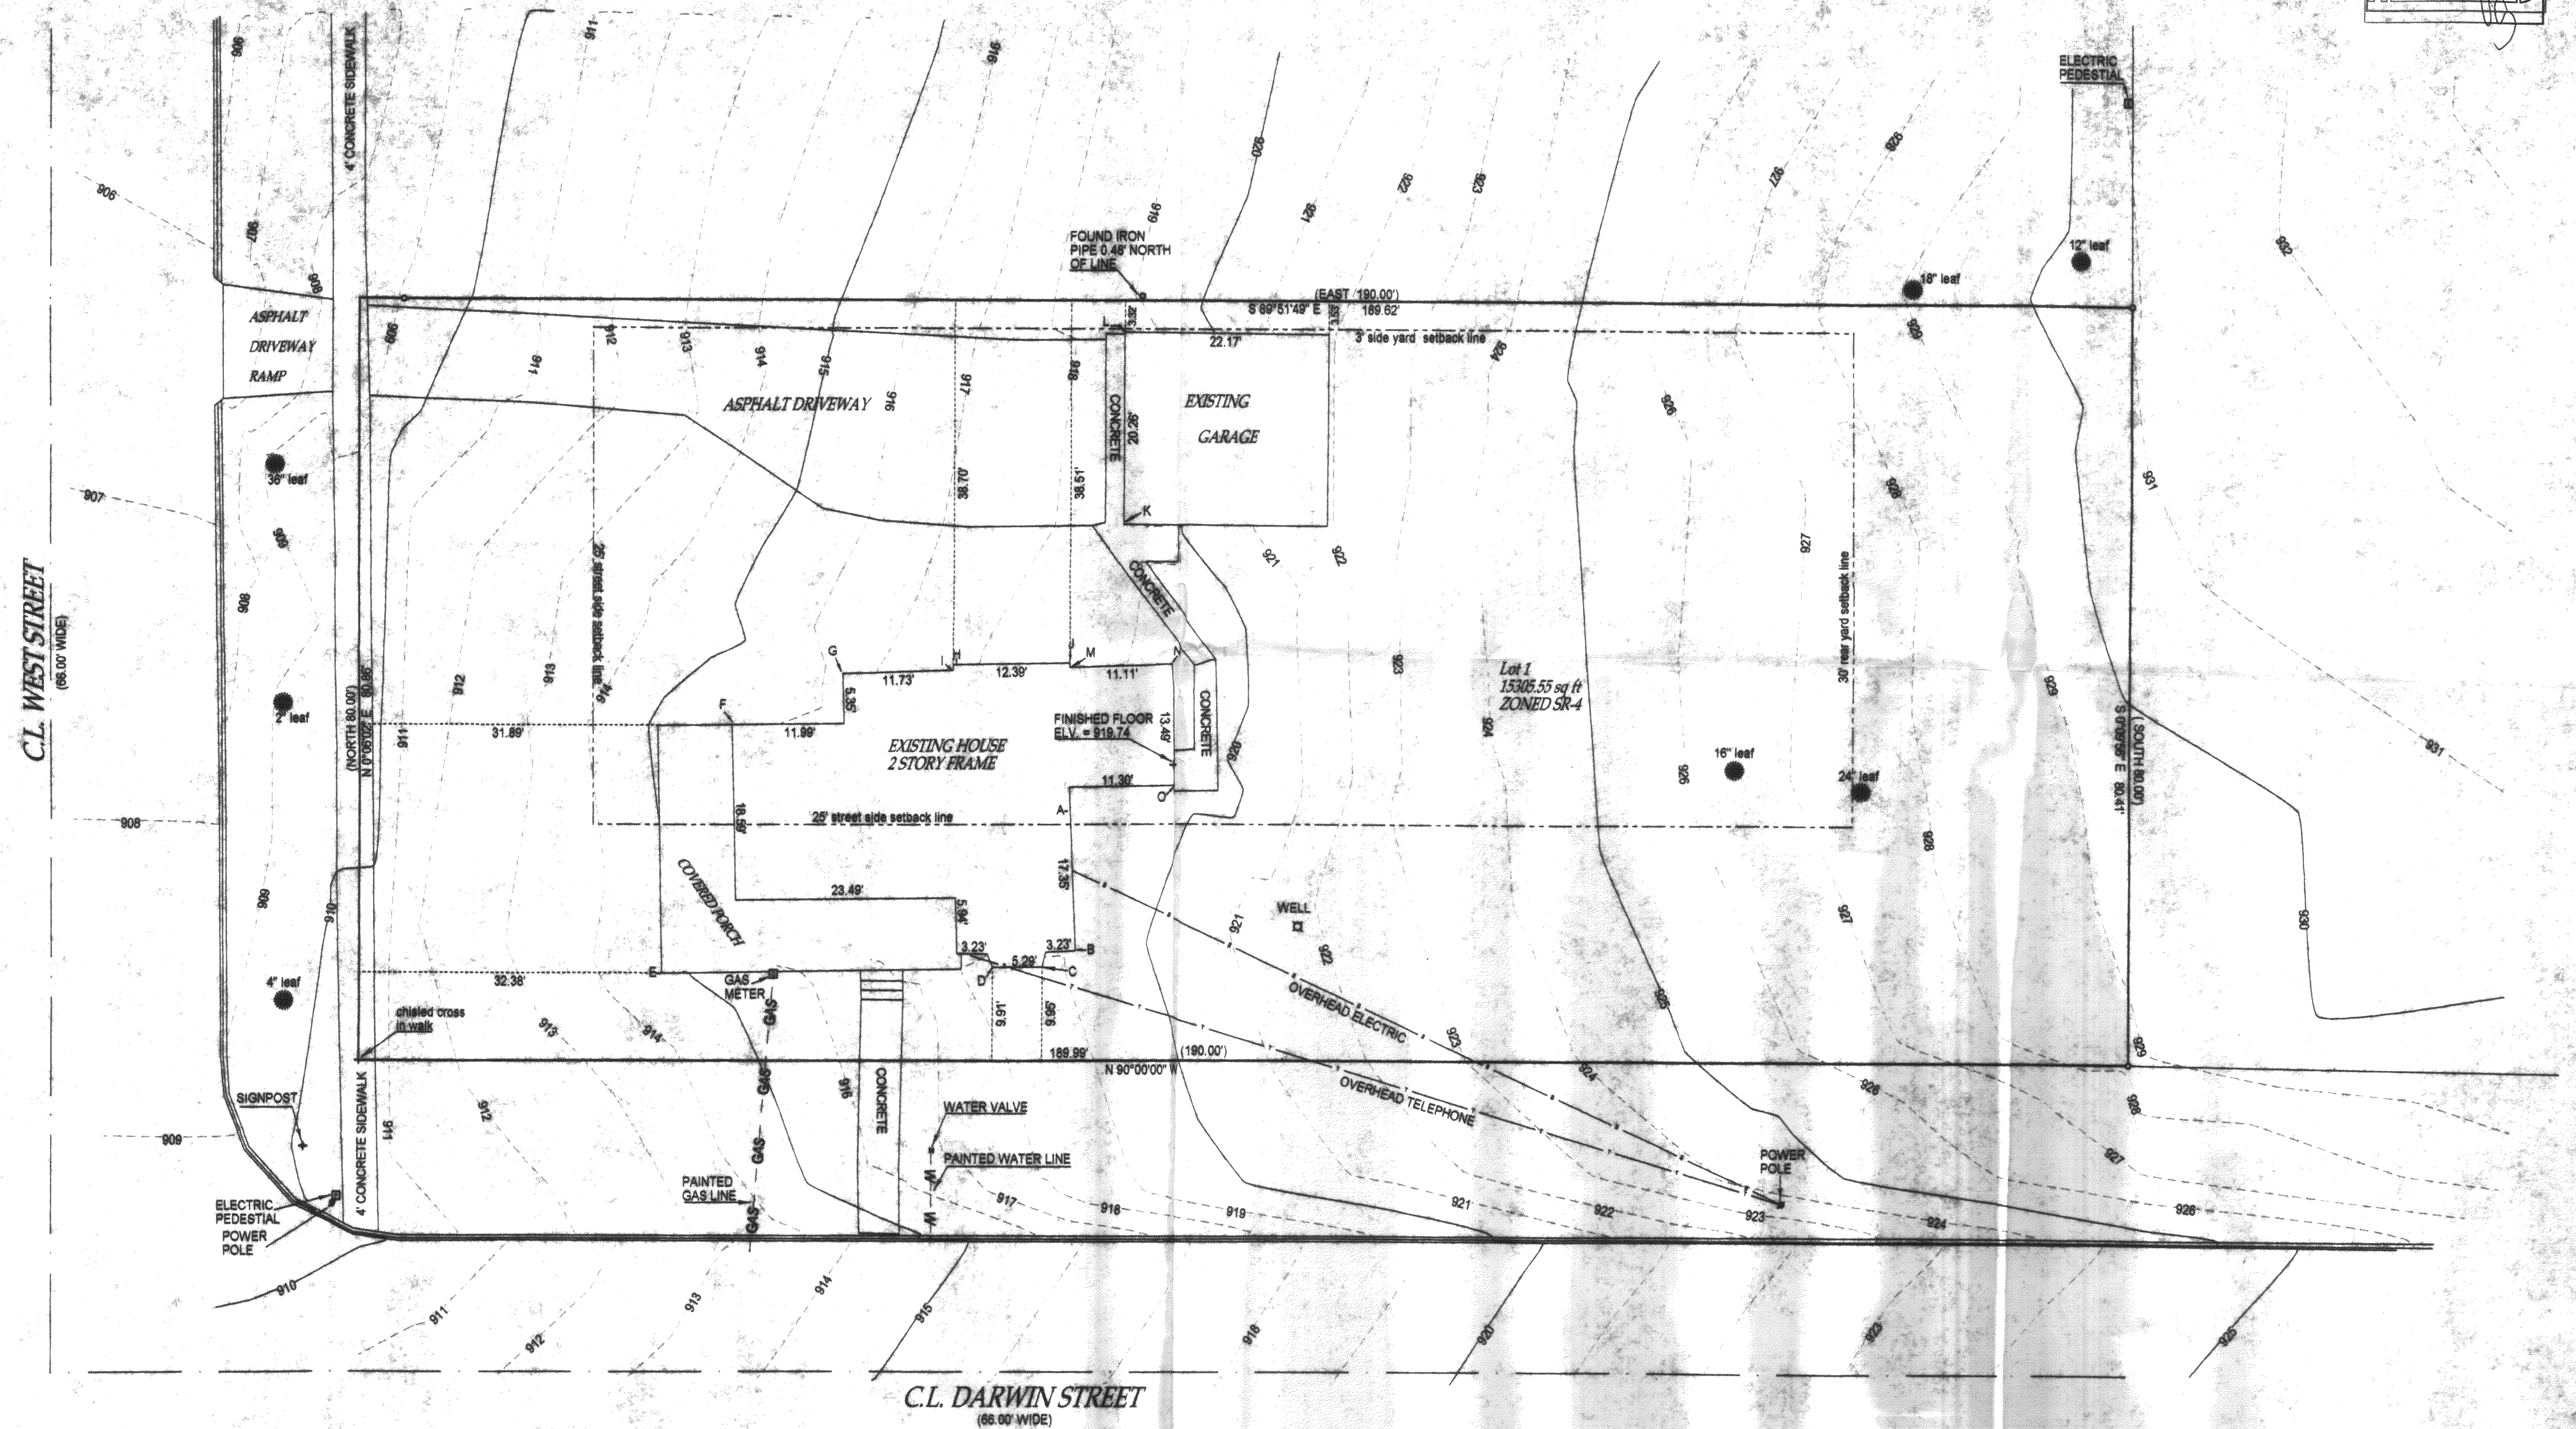

● = tree
() = recorded as
□ = found iron bar
○ = found iron pipe
● = set iron pipe
■ = set iron bar
⊕ = power pole
SCALE 1" = 10'
JOB # 01-081
TAX ID # 22P-15

COMPARE LEGAL DESCRIPTION AND DRAWING WITH RECD. FOR BUILDING RESTRICTIONS AND EASEMENTS NOT SHOWN REFER TO RECD. ASSESSOR'S RECORDS AND LOCAL MUNICIPAL CODES. NOTIFY THE SURVEYOR IMMEDIATELY OF ANY DISCREPANCY.
"I hereby certify that the above described property was surveyed under my supervision and that the above map is a true representation thereof and shows the size and location of all visible structures, apparent easements and encroachments if any."
This survey is made for the present owners of the property, and those who purchase, mortgage, or guarantee title thereto, within one year from the date hereof.
DATED THIS 27 TH DAY OF MARCH 20 11.

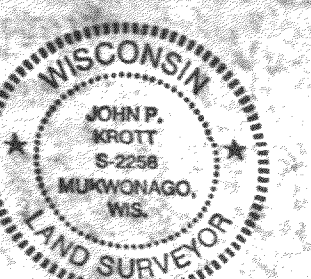

JOHN P. KROTT
Wisconsin Registered Land Surveyor
(original if signed in red)

201-15 007-1977