



PLAT OF SURVEY


— WORK ORDERED BY —
JOHN RYAN
1376 R.F.D.
LONG GROVE, IL. 60047

FARRIS, HANSEN & ASSOCIATES, INC.
ENGINEERING — ARCHITECTURE — SURVEYING
7 RIDGWAY COURT P.O. BOX 437
ELKHORN, WISCONSIN 53121
OFFICE: (262) 723-2098 FAX: (262) 723-5886

REVISIONS

PROJECT NO.
5227
DATE:
08/08/01
SHEET NO.
1 OF 1


PLAT OF SURVEY LOT 2 CERTIFIED SURVEY MAP NO. 3156 PART OF LOTS 5 & 6 OF BAKER & BROWN'S SUBDIVISION CITY OF LAKE GENEVA, WALWORTH COUNTY, WISCONSIN

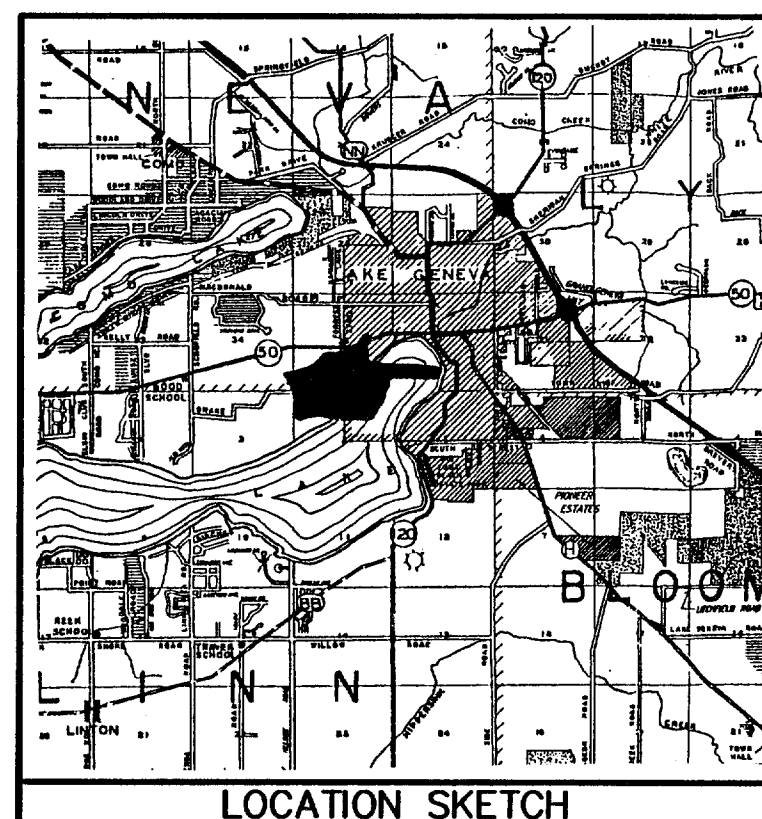

WISCONSIN COORDINATE SYSTEM
SOUTH ZONE
ASSIGNED WEST LINE SE 1/4
N 00 49' 31" W

GRID
NORTH

GENEVA LAKE
W.S. ELEV. = 865

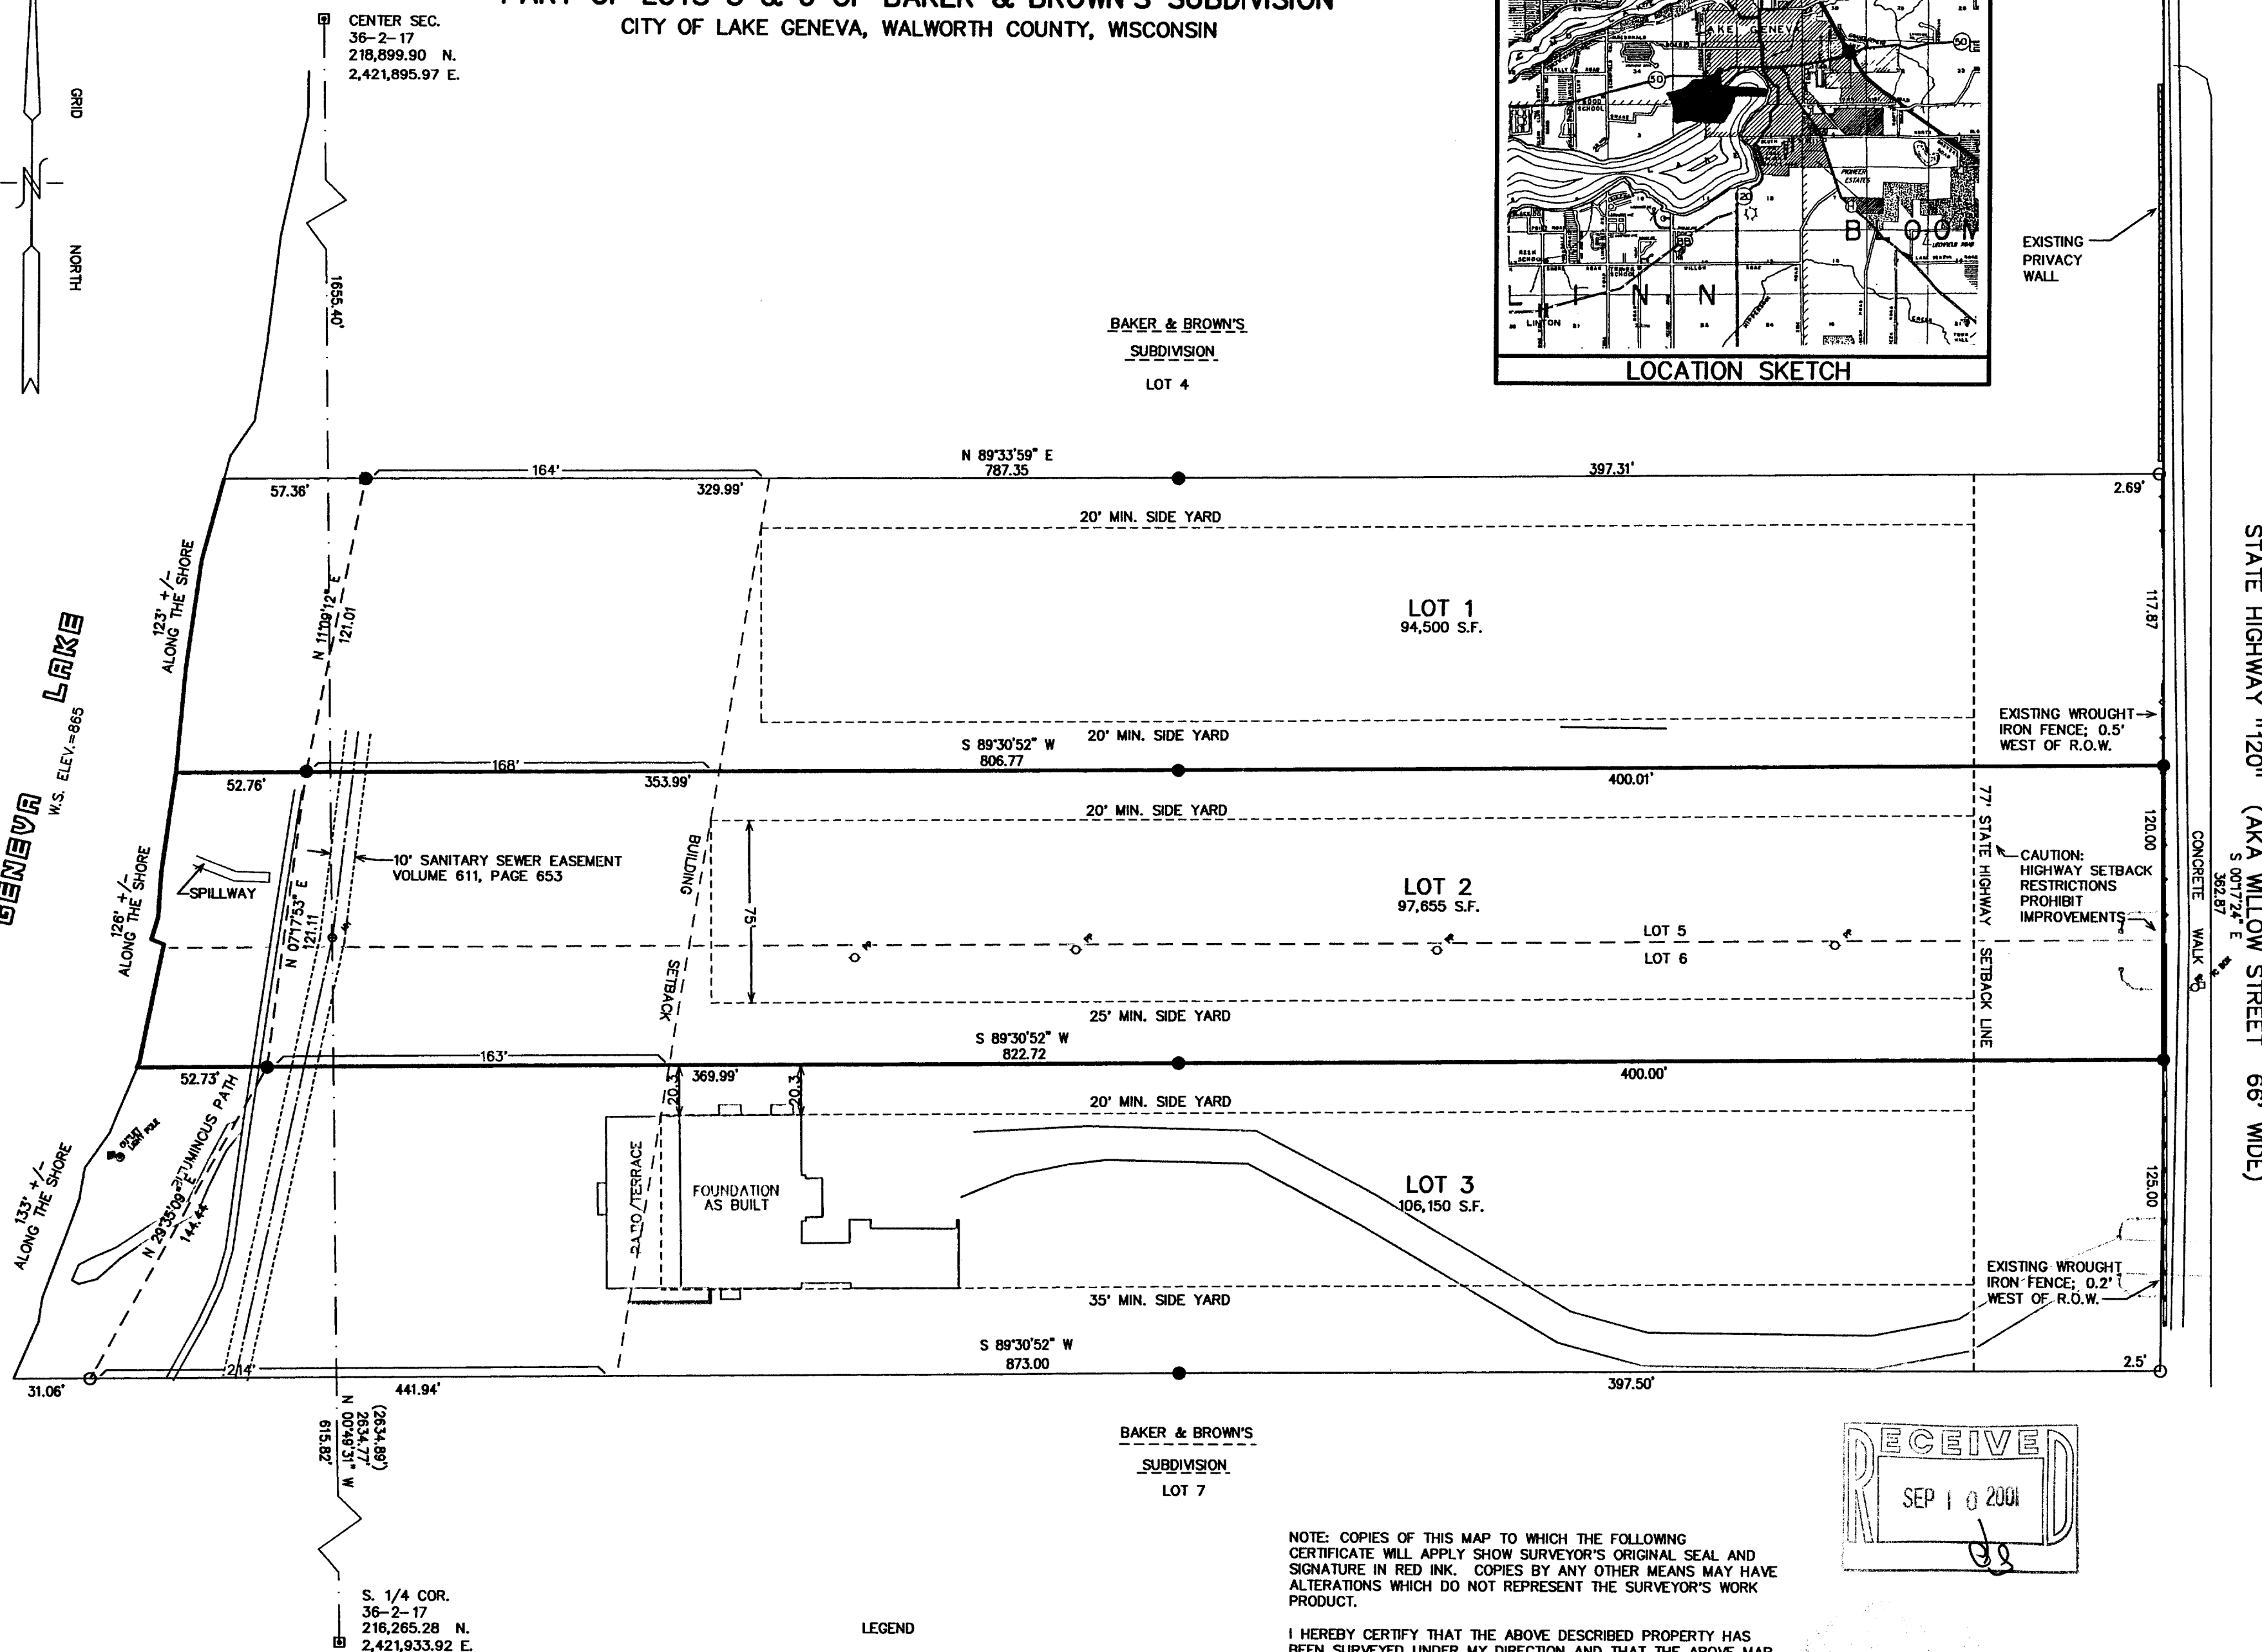

- LEGEND
- = FOUND CONCRETE COUNTY MONUMENT W/ BRASS CAP
 - = FOUND IRON PIPE STAKE 1" DIA. IN CONCRETE
 - = SET IRON REBAR STAKE 24" X 3/4" DIA. X 1.5 LBS./FT.
 - (xxx) = RECORDED AS

NOTE: COPIES OF THIS MAP TO WHICH THE FOLLOWING CERTIFICATE WILL APPLY SHOW SURVEYOR'S ORIGINAL SEAL AND SIGNATURE IN RED INK. COPIES BY ANY OTHER MEANS MAY HAVE ALTERATIONS WHICH DO NOT REPRESENT THE SURVEYOR'S WORK PRODUCT.

I HEREBY CERTIFY THAT THE ABOVE DESCRIBED PROPERTY HAS BEEN SURVEYED UNDER MY DIRECTION AND THAT THE ABOVE MAP IS A TRUE REPRESENTATION THEREOF AND SHOWS THE SIZE AND LOCATION OF THE PROPERTY AND ITS EXTERIOR BOUNDARIES. THIS SURVEY IS MADE FOR THE USE OF THE PRESENT OWNERS OF THE PROPERTY, AND ALSO THOSE WHO PURCHASE, MORTGAGE, OR GUARANTEE THE TITLE THERETO WITHIN ONE YEAR FROM THE DATE HEREOF.

DATED: 08/07/01

PETER S. GORDON R.L.S. 2101

MAP SCALE IN FEET ORIGINAL 1" = 50'

2A-3156-2

7-1984