


NORTH LINE OF
SECTION 35, T2NR17E

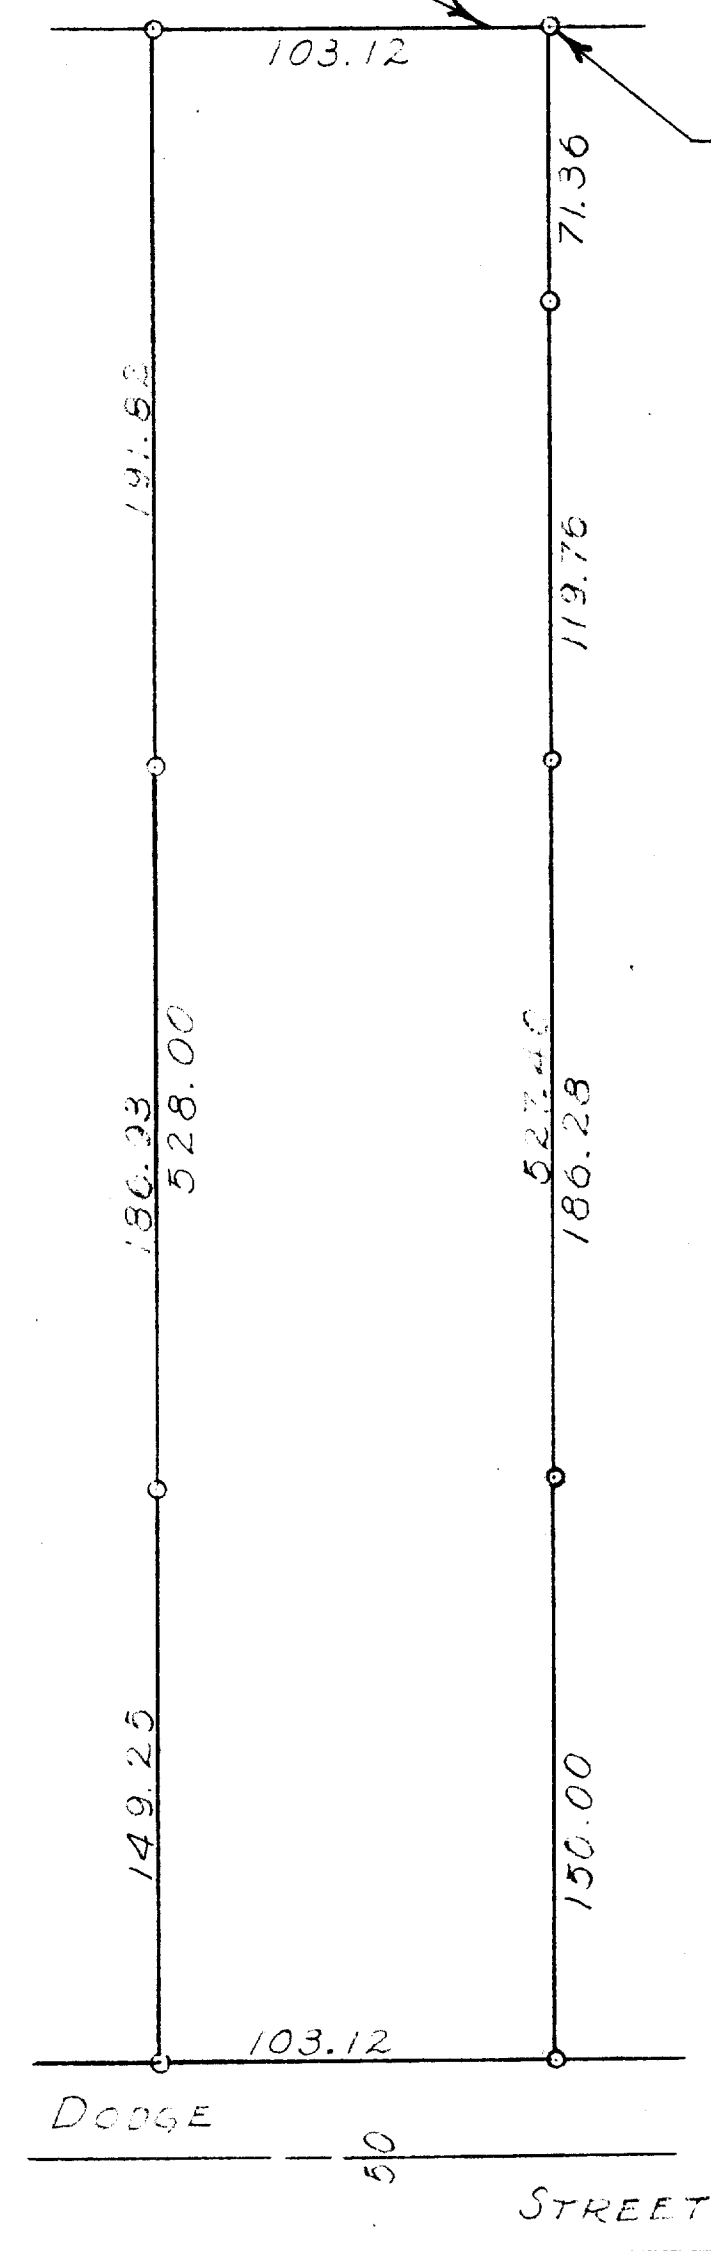

IRON PIPE AT BASE OF
TREE AND 0.60 FEET
SOUTH OF CORNER,
TREE AT TRUE CORNER

N

SCALE ~ 1" = 50'
O ~ IRON PIPE

PLAT OF SURVEY OF A PARCEL OF LAND LOCATED IN THE NORTHEAST 1/4
OF SECTION 35, T2NR17E, WALWORTH COUNTY, WISCONSIN,
JUNE 26, 1957

GEORGE T. DUNHAM, SURVEYOR
DELAVER, WISCONSIN