


LEGEND:
 ○ - IRON PIPE FOUND
 SCALE 1" = 30'

10.0 10.0

25.00
 25.00

92.80
 15.00
 ALLEY

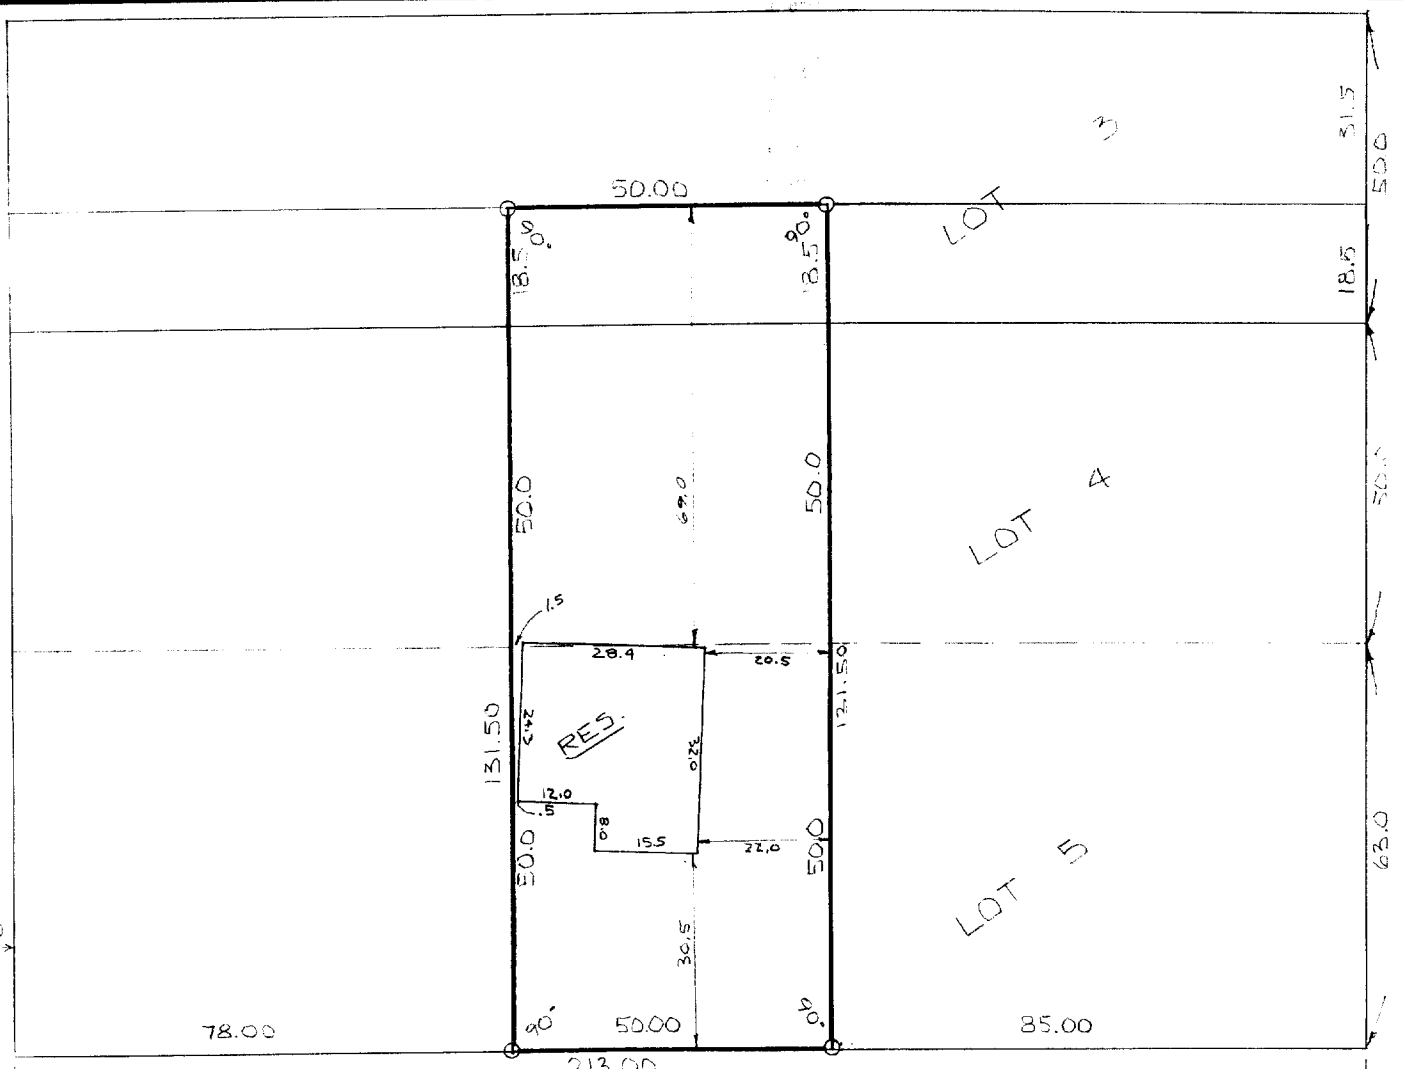

CASS STREET

213.70

DESCRIPTION:
 THE EAST 50.00' OF THE FOLLOWING DESCRIBED
 PROPERTY: THE SOUTH 18½' OF LOT 3 AND ALL
 OF LOTS 4 AND 5 OF BLOCK 5 EXCEPT THE
 EAST 85' THEREFROM, PHILLIPS & PURVIS SUB-
 DIVISION, LAKE GENEVA, WISC.

SURVEYOR'S CERTIFICATE:
 I, JOSEPH M. BIAGI, SURVEYOR, DO HEREBY
 CERTIFY THAT I HAVE SURVEYED THE
 PROPERTY HEREON DESCRIBED.

SIGNED: JUNE 5, 1974

ST.
 CURTIS

Joseph M. Biagi
 JOSEPH M. BIAGI R.L.S. #12
 ELKHORN, WISCONSIN



REVISIONS			GERTRUDE L. PODY PROPERTY		
NO.	DATE	BY	PART OF LOTS 3-4-5 PHILLIPS & PURVIS		
1			DRAWN BY	SCALE 1"=30'	MATERIAL
2					
3			CHK'D	DATE 6-5-74	DRAWING NO.
4					
5			TRACED	APP'D	# 34-74