

ABELL
SURVEYING & MAPPING


1140 SEQUOIA STREET • DELAVAN, WISCONSIN 53115
262-728-6737

PLAT OF SURVEY OF


LOT 9, BLOCK 17, GENEVA LAKE CRAWFORD
MANUFACTURING COMPANY ADDITION, CITY
OF LAKE GENEVA, WALWORTH COUNTY,
WISCONSIN.

REVISED DATE: MAY 3, 2002
REVISED TO SHOW HOUSE UNDER CONSTRUCTION

ORDERED BY: DAN HURZELER
P.O. BOX 882
WALWORTH, WI 53184

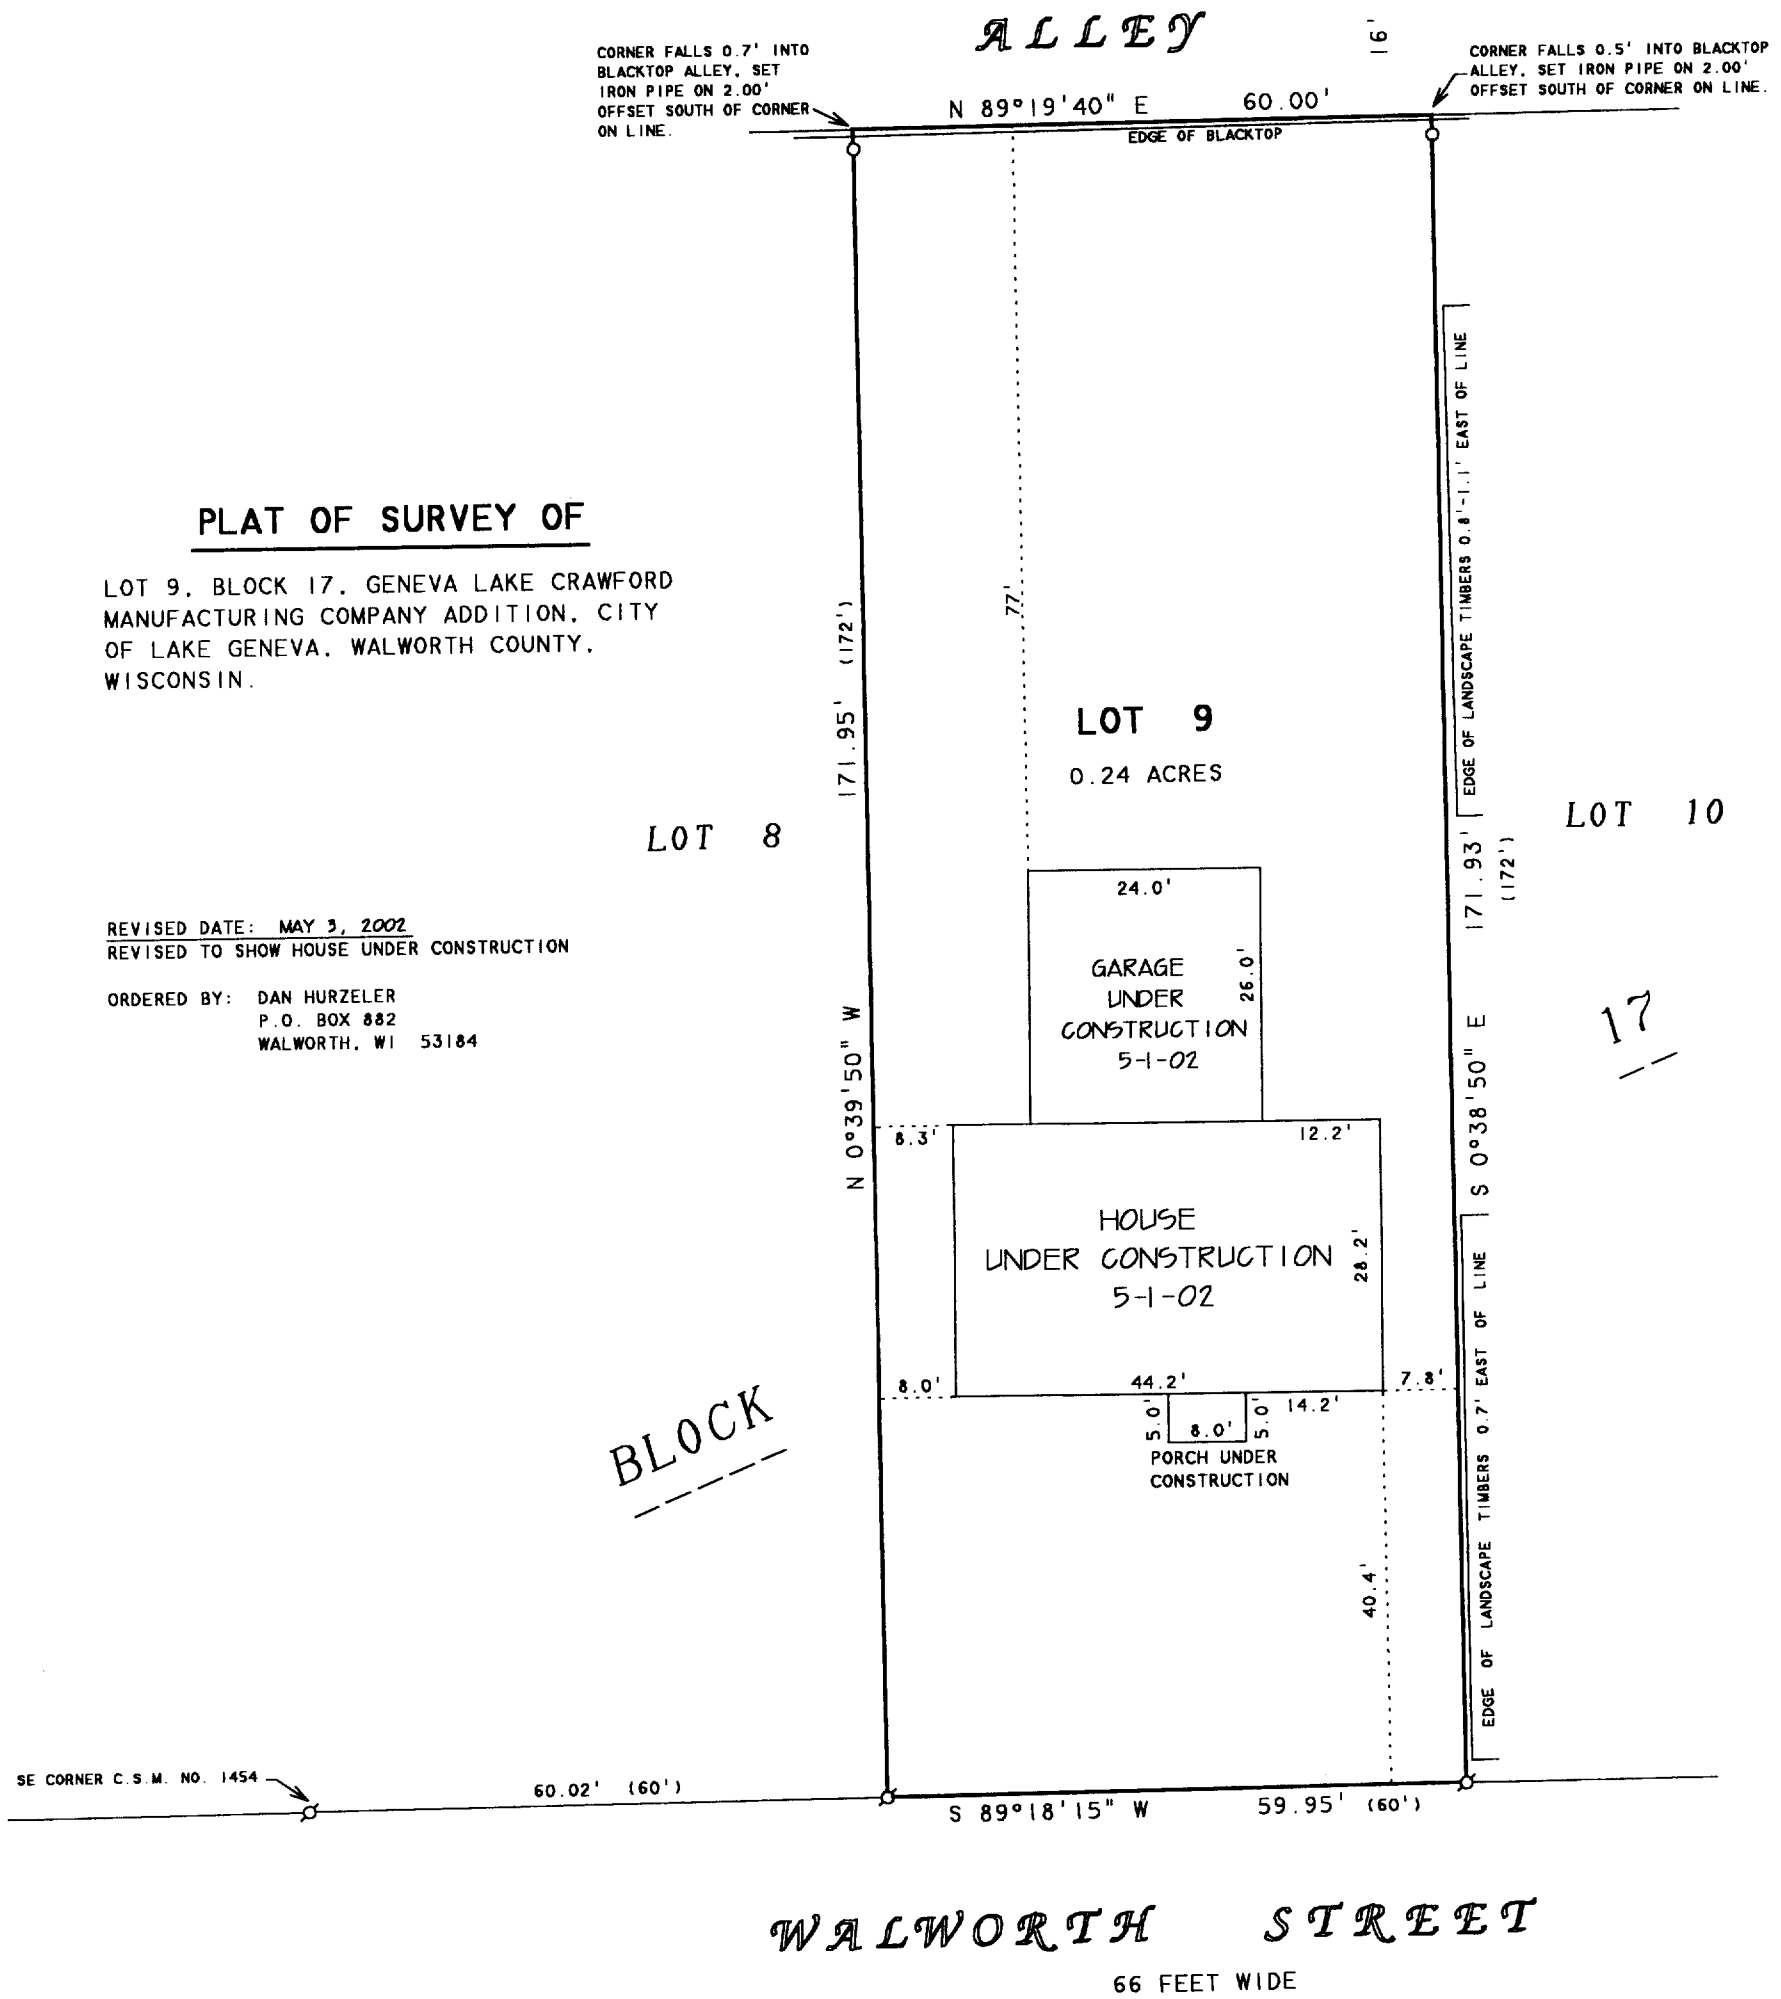

NOTE: BEARINGS ARE REFERENCED TO
CERTIFIED SURVEY MAP NO. 1454

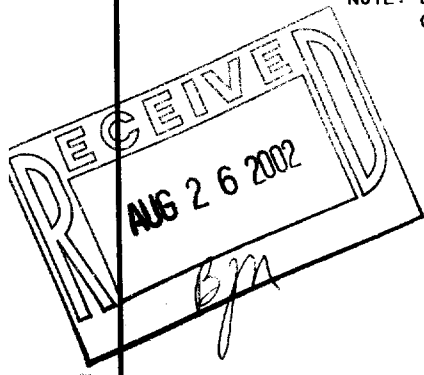

N



SCALE 1"=20'

LEGEND

- Ø - IRON PIPE FOUND
- O - IRON PIPE SET
- BE - BASEMENT ENTRY
- WP - WOOD PORCH
- () - RECORDED AS

I HEREBY CERTIFY THAT I HAVE SURVEYED THE ABOVE DESCRIBED PROPERTY AND THAT THE ABOVE MAP IS A TRUE REPRESENTATION THEREOF AND SHOWS THE SIZE AND LOCATION OF THE PROPERTY, ITS EXTERIOR BOUNDARIES, THE LOCATION OF ALL VISIBLE STRUCTURES AND DIMENSIONS OF ALL PRINCIPAL BUILDINGS THEREON, BOUNDARY FENCES, APPARENT EASEMENTS, ROADWAYS AND VISIBLE ENCROACHMENTS, IF ANY, TO THE BEST OF MY KNOWLEDGE AND BELIEF.

THIS SURVEY IS MADE FOR THE USE OF THE PRESENT OWNERS OF THE PROPERTY, AND ALSO THOSE WHO PURCHASE, MORTGAGE, OR GUARANTEE THE TITLE THERETO WITHIN ONE (1) YEAR FROM DATE HEREON.

David F. Abell

DAVID F. ABELL
WISCONSIN REGISTERED LAND SURVEYOR, S-1596

February 28, 2002

DATE JOB NUMBER - 02025A
NOTE: THIS IS NOT A CERTIFIED COPY UNLESS SEALED.

ZGC 88

007-2040