

7-2042

Plat of Survey



of

Lots 3 and 4 of Block 2 of Warhurst's Subdivision,



located in the Southwest 1/4 of Section 25, Town 2 North, Range 17 East,
City of Lake Geneva, Walworth County, Wisconsin.

Surveyed for: **Keefe Real Estate, Inc.**


P.O. Box 460
Lake Geneva, Wisconsin. 53147

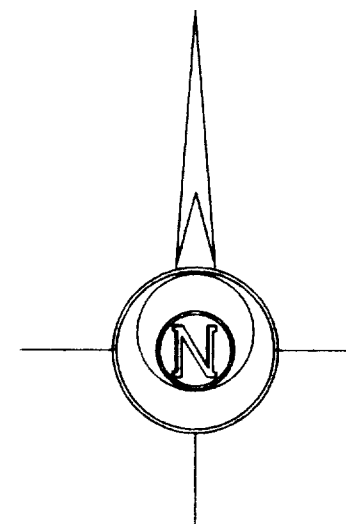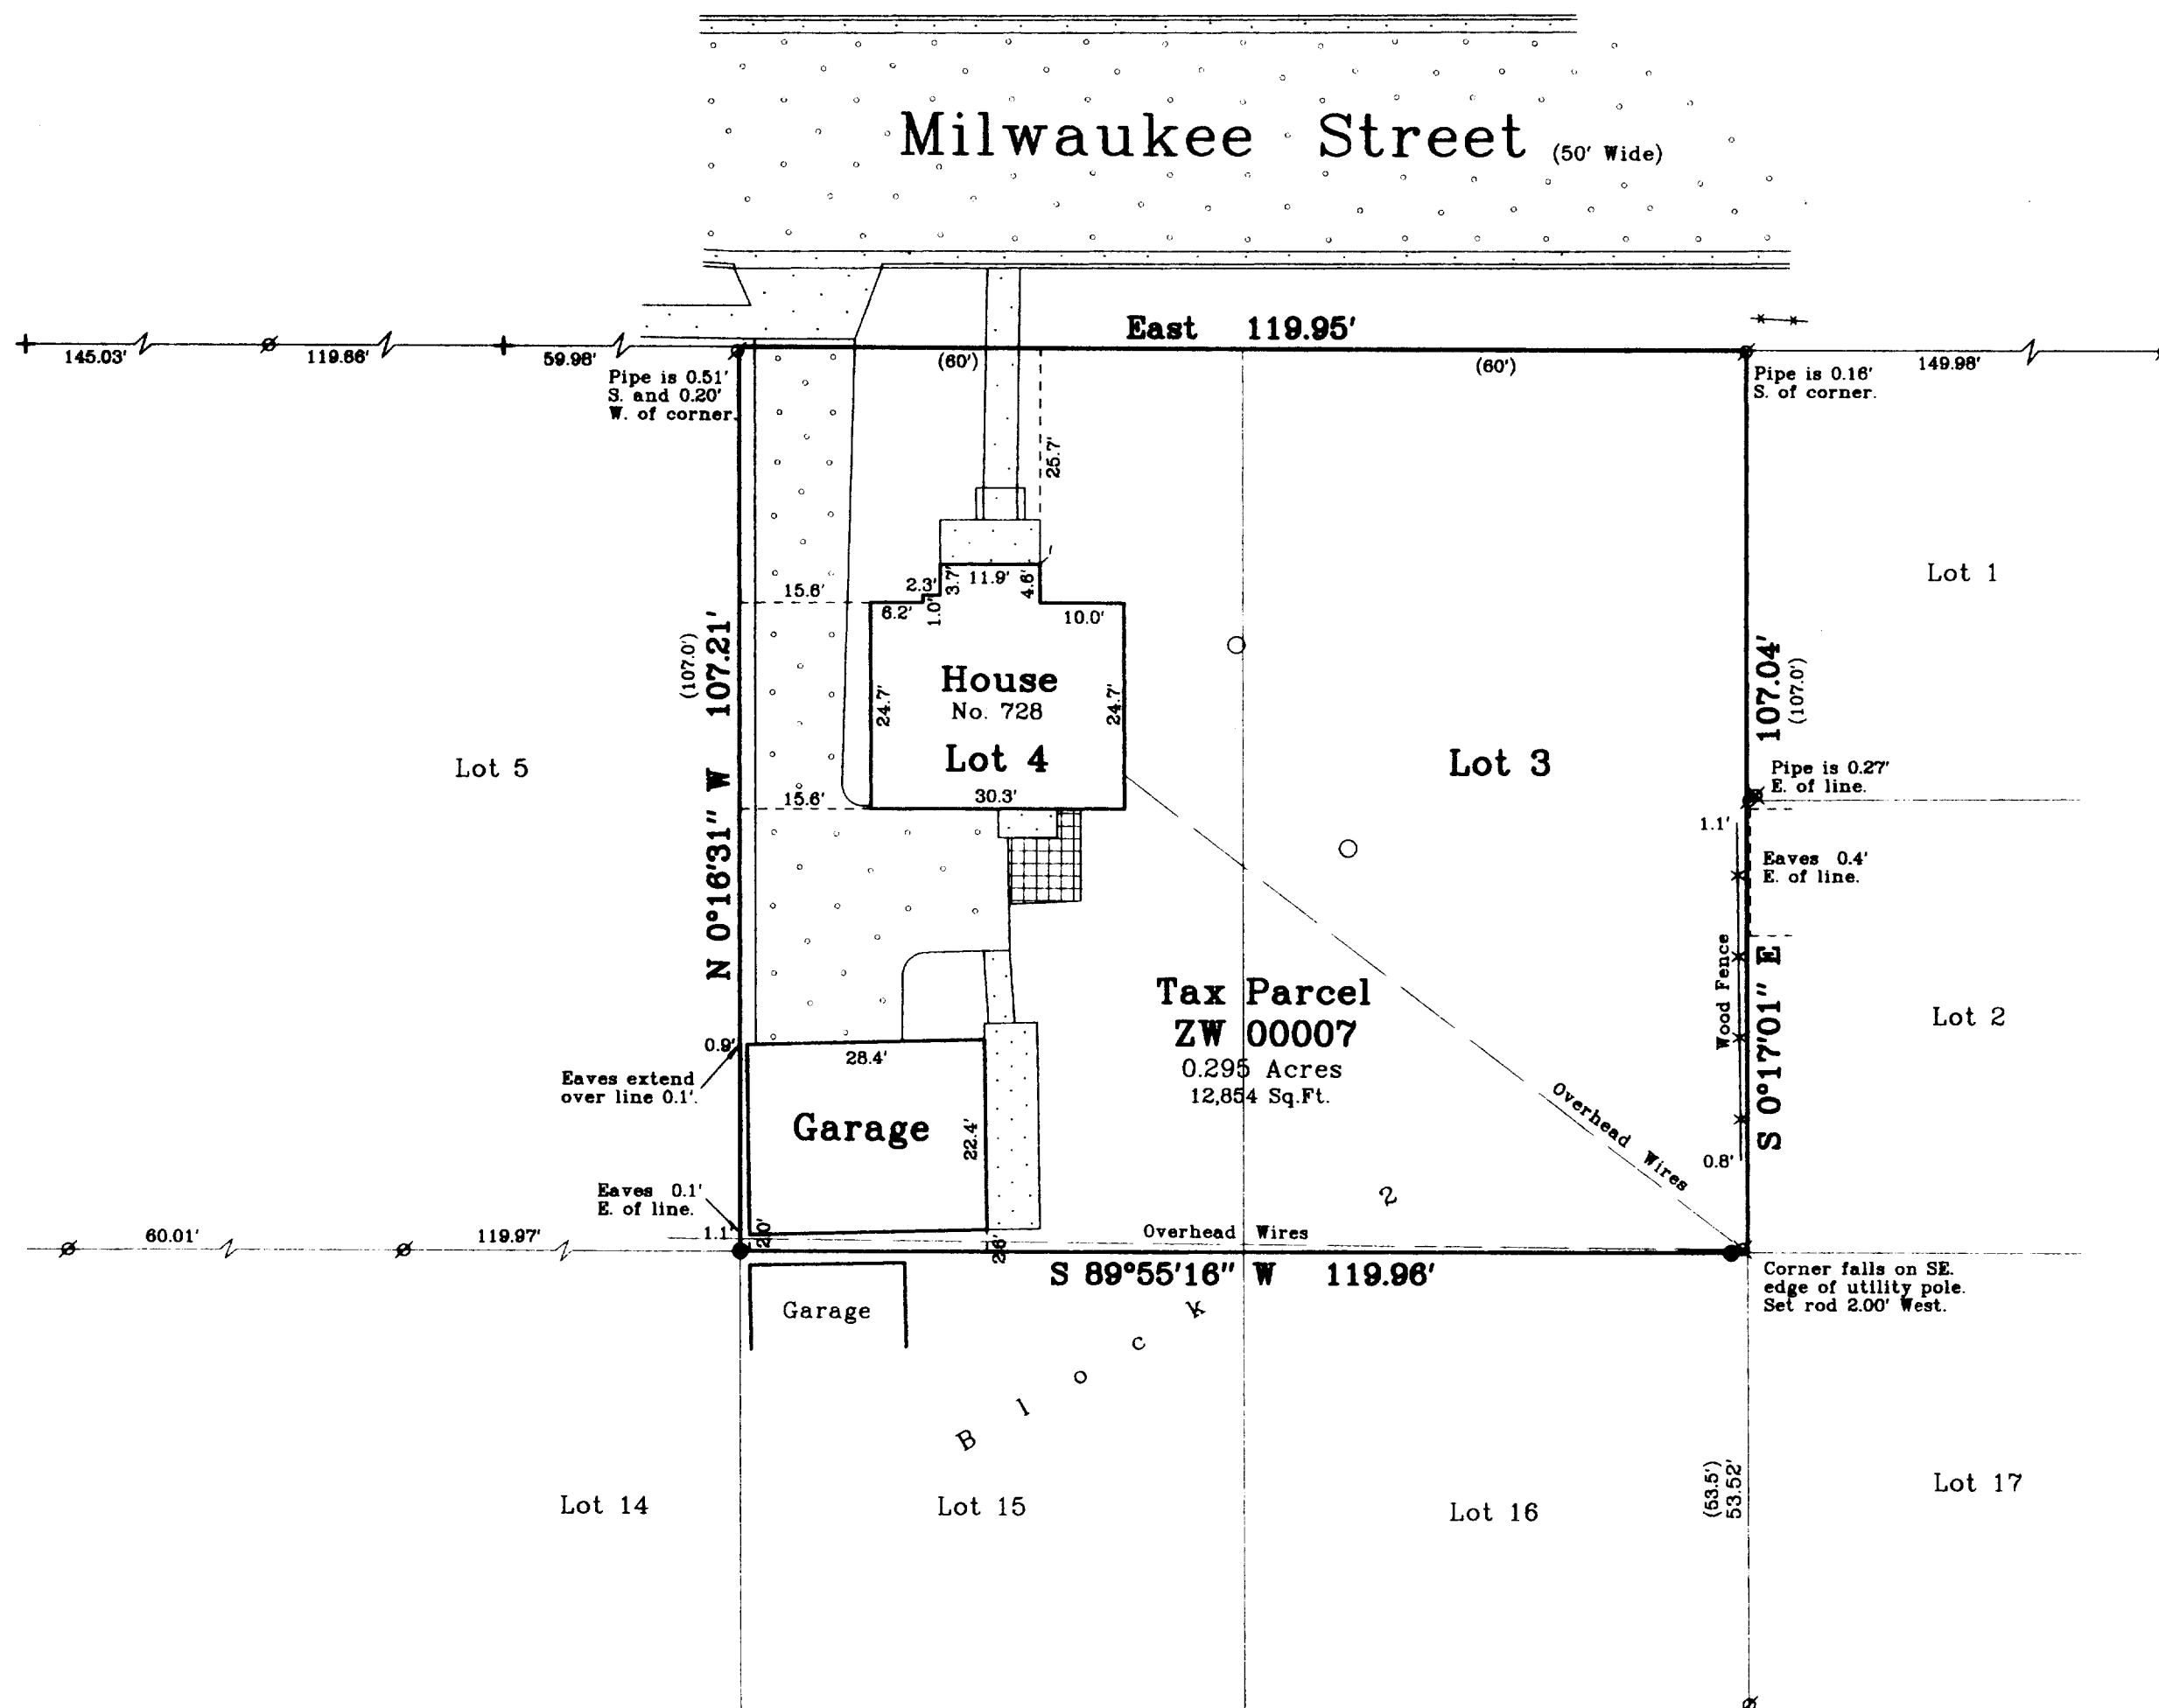

Bearings referenced to the South line
of Milwaukee Street, assumed as East.

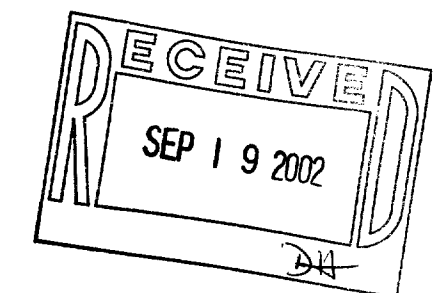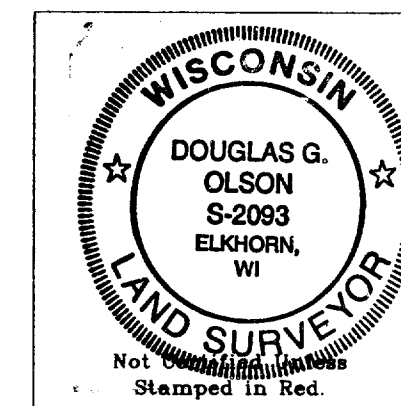

Survey Date: May 29, 2001.
Revisions:

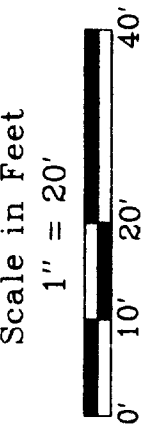

Jensen & Olson Land Surveying, LLC
45 South Wisconsin Street
Elkhorn, Wisconsin. 53121
Telephone (262) 723-3434
Facsimile (262) 723-8044

Legend

- Found Iron Pipe
- Found Chiseled Cross
- Set Iron Rod
- Set Iron Stake
- Utility Pole
- Asphalt Surface
- Concrete Surface
- Metal Cover
- Brick Patio

Sheet 1 of 1 Sheets
Job Reference Number
2001.063
2001.063

7-2042