

2GC-84B

Haskins Street

Plat of Survey

of





The South 2/3 of Lots 4 and 5 of Block 17 of Geneva
Lake Crawford Manufacturing Company's Addition,

a subdivision located in the Southeast 1/4 of Section 25, Town 2 North,
Range 17 East, City of Lake Geneva, Walworth County, Wisconsin.

Surveyed for: **Braden & Olson, LLP**
716 Wisconsin Street
P.O. Box 940
Lake Geneva, Wisconsin. 53147

Henry Street

Center Street
(86' Wide)

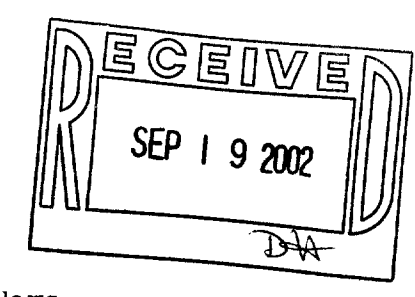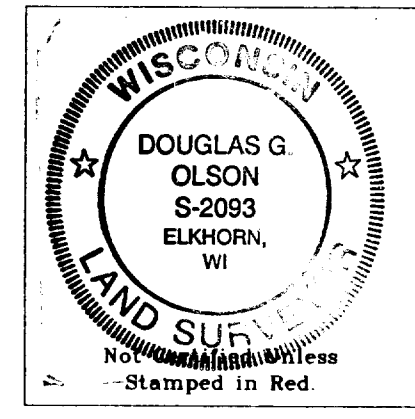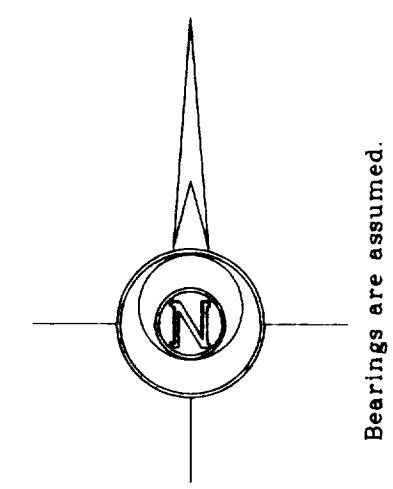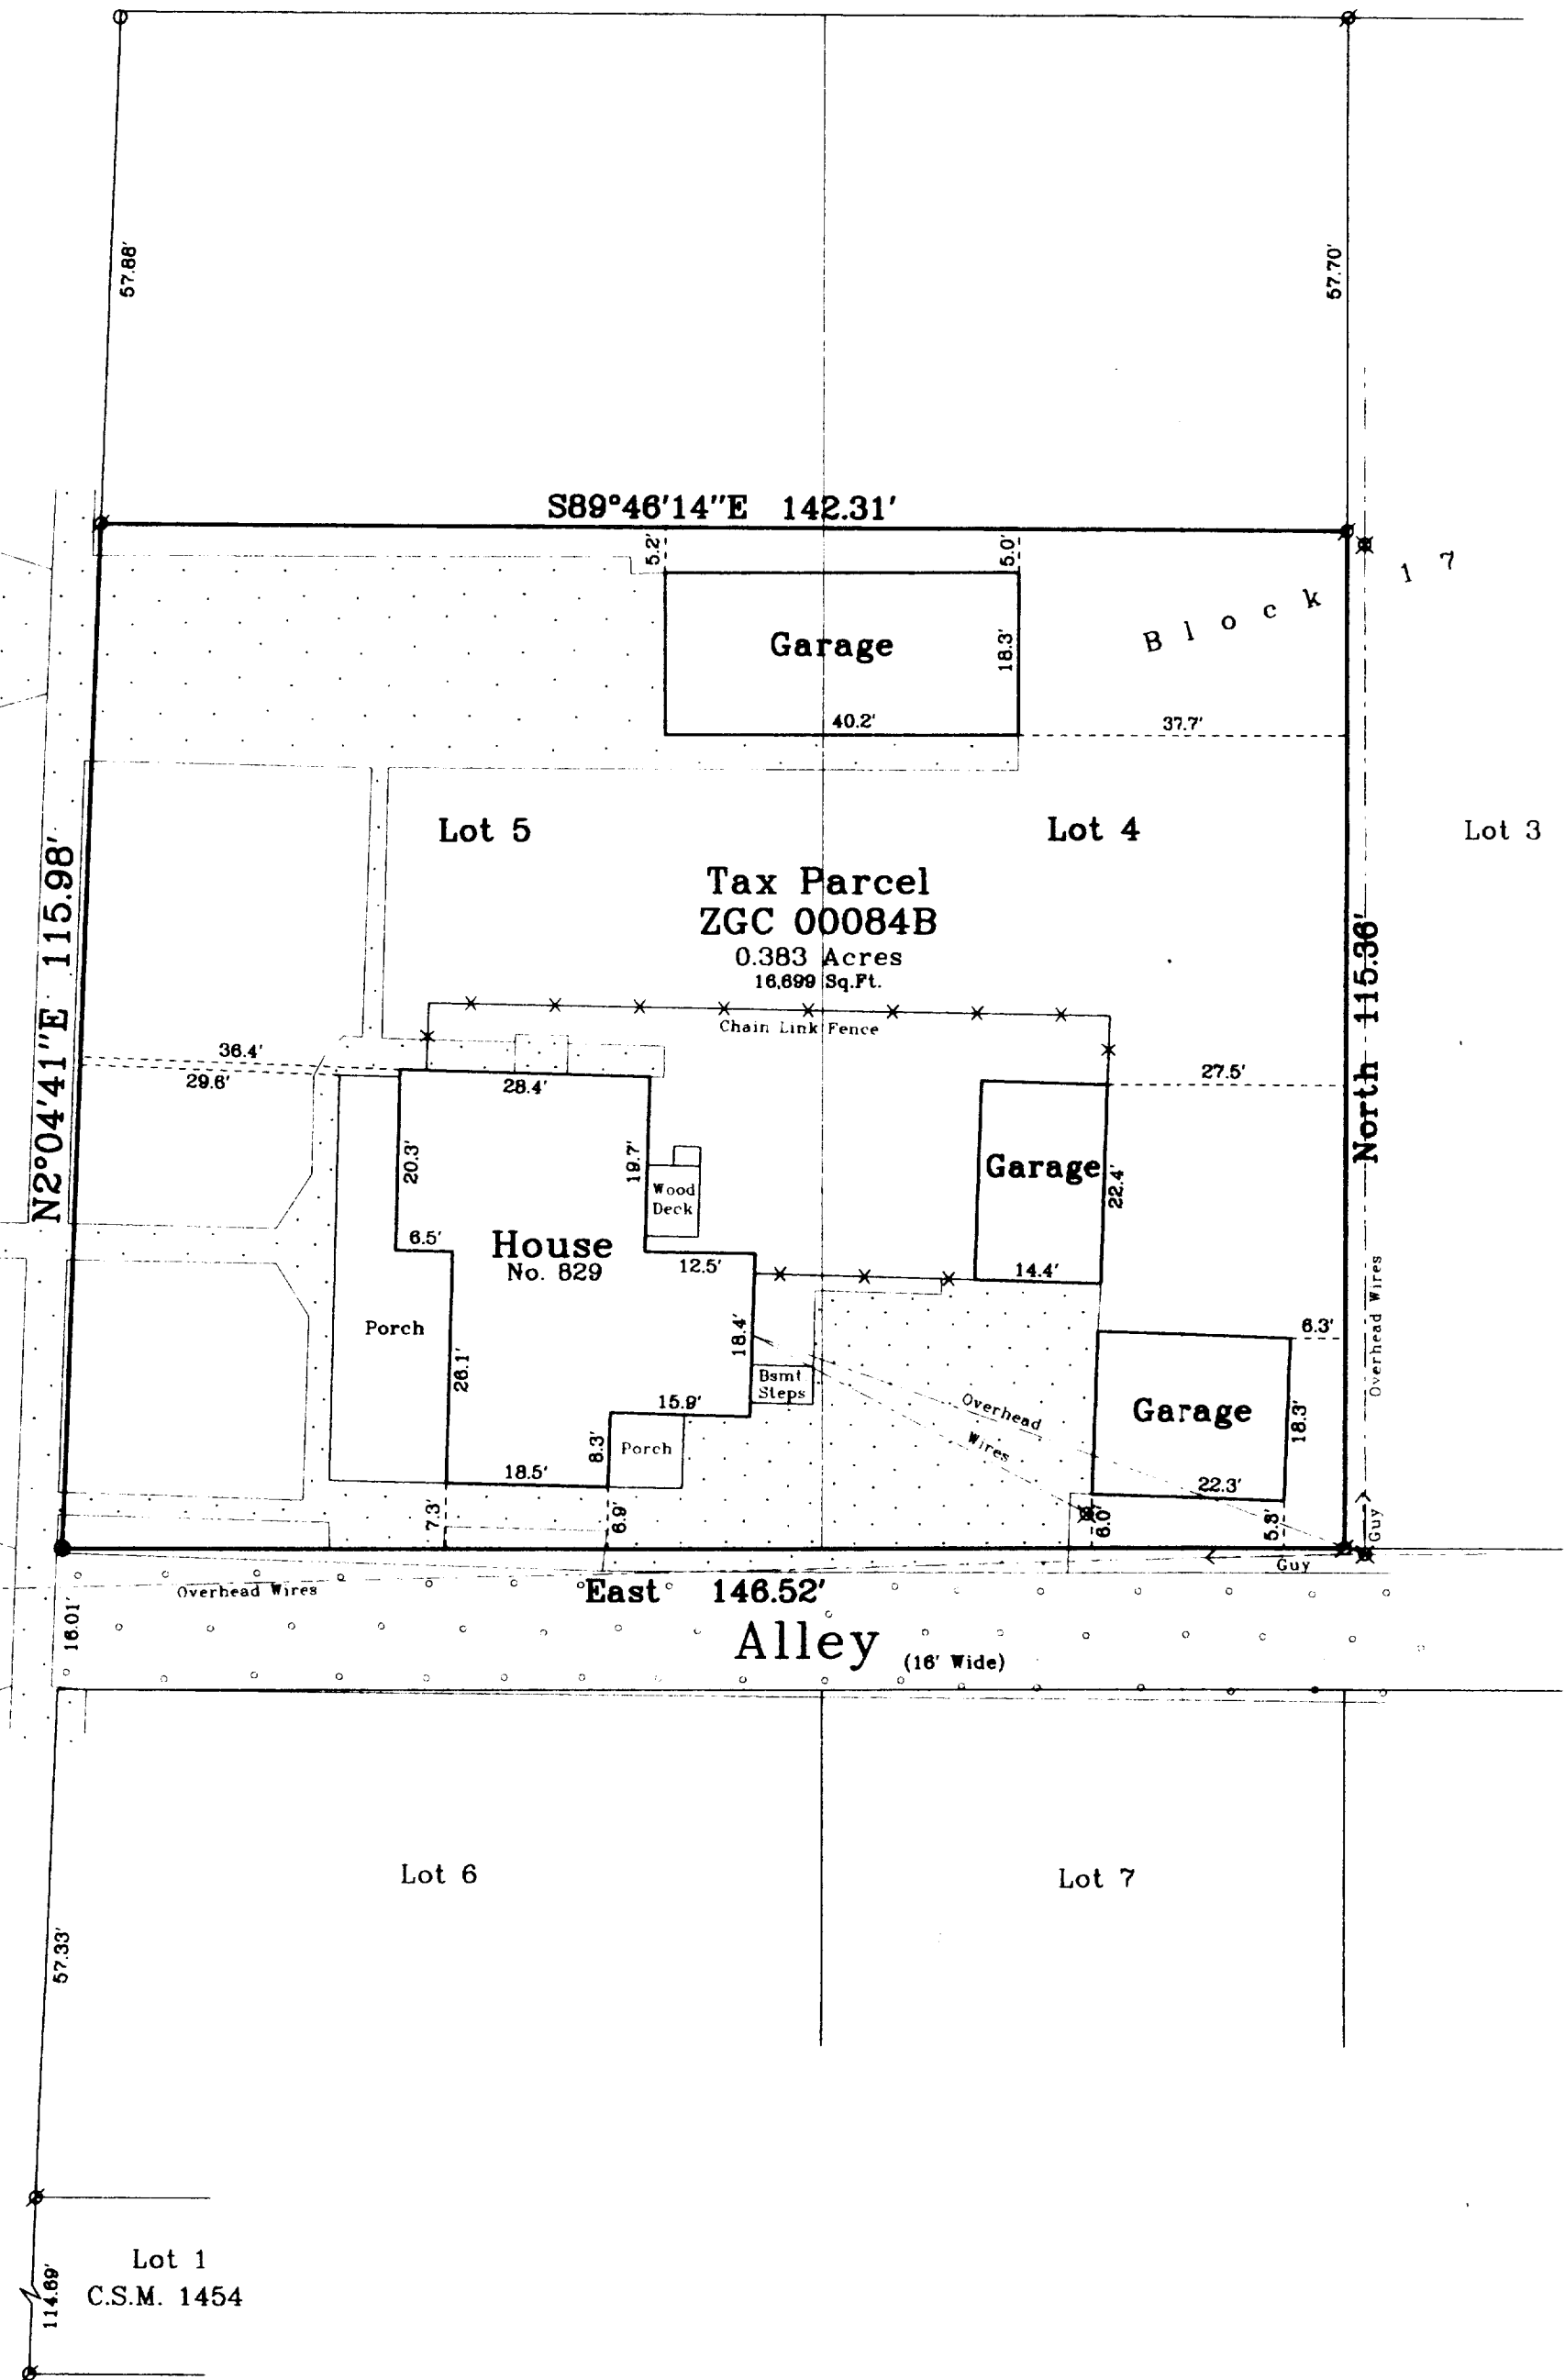

- Notes: 1) This survey plat is not certified unless signed and sealed in red ink.
- 2) This survey is subject to Wisconsin lien laws. This Plat of Survey is the notice of intent to file lien. Lien waiver required.

Copyright © 2001 by Jensen & Olson Land Surveying, LLC.


All rights reserved. No part of this survey plat may be reproduced or transmitted in any form by any means - graphic, electronic, or mechanical, including photocopying, tracing, or information storage and retrieval systems - without permission in writing from Douglas G. Olson, Jensen & Olson Land Surveying, LLC.

I hereby certify that I have surveyed the above described property and the map hereon is correct to the best of my professional knowledge and belief and shows the size and location of the property, its exterior boundaries, the location and dimensions of all visible structures thereon, boundary fences, apparent easements and roadways and visible encroachments, if any.

This survey is made for the exclusive use of the present owners of property, and also those who purchase, mortgage or guarantee title thereto, within one year from the date hereof.

Douglas G. Olson
Wisconsin Registered Land Surveyor - 2093

Survey Date: September 14, 2001.
Revisions:

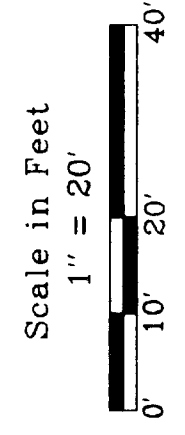

Jensen & Olson Land Surveying, LLC
45 South Wisconsin Street P.O. Box 322
Elkhorn, Wisconsin. 53121
Telephone (262) 723-3434
Facsimile (262) 723-8044

- Legend
- Found Iron Pipe
 - Found Iron Rod
 - Set Iron Rod, 3/4" dia.
 - Recorded Information
 - Utility Pole
 - Concrete Surface
 - Asphalt Surface

Sheet 1 of 1 Sheets

Job Reference Number
2001.128

2001.128

007-2045