



PLAT OF SURVEY OF

Lot 14, Block 14 of LAKE GENEVA MANOR, Tract No. 17, being a subdivision located in the East Half of Section 35, Town 2 North, Range 17 East of the 4th Principal Meridian, City of Lake Geneva, Walworth County, Wisconsin.

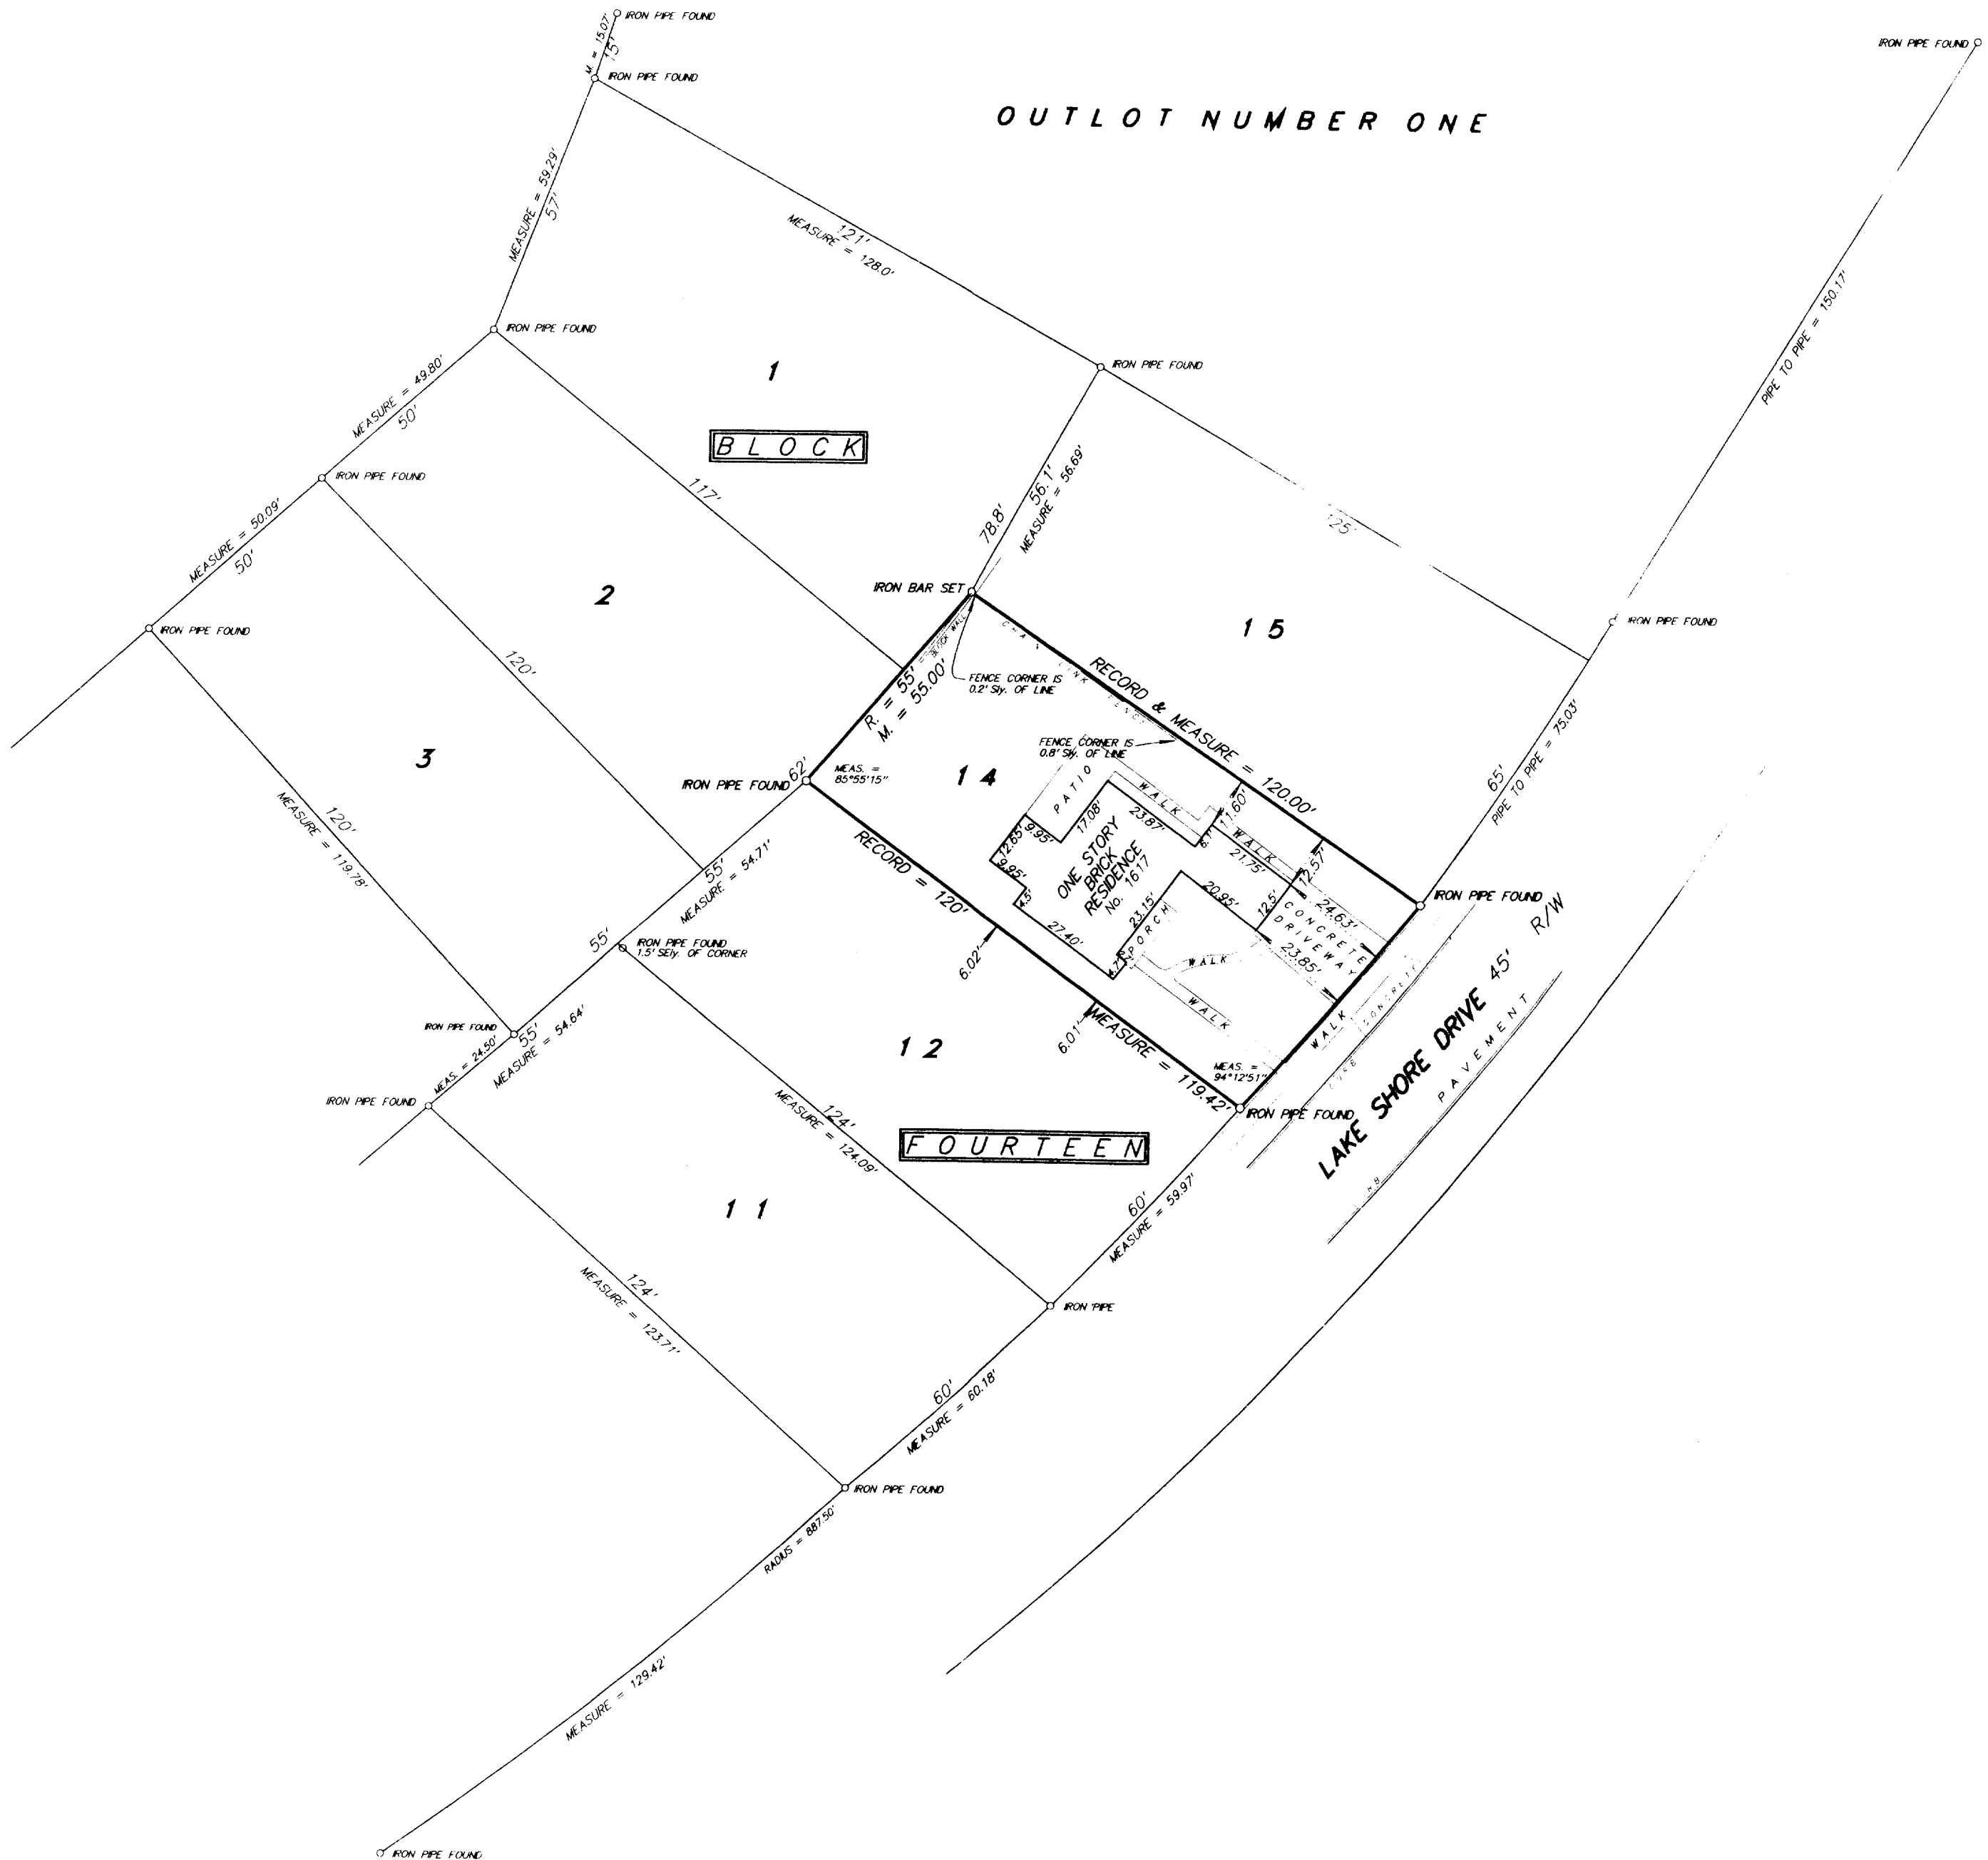

SCALE 1 inch = 30 feet
ORDERED BY D. Blonda
JOB NO. 02279

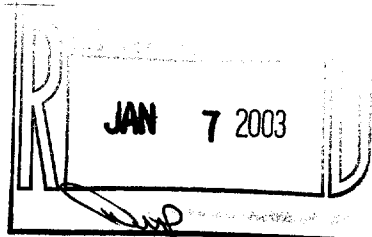

I hereby certify that I have surveyed the above described property and the above plat is a true and correct representation thereof and shows the size and location of the property, its exterior boundary, and the location and dimensions of all buildings and structures thereon, boundary lines, easements and encroachments and all other matters affecting the title to the property.

This survey is made for the purpose of the use of the present owners of the property, and for those who purchase hereafter, and I guarantee the title thereto as of the date hereof.

Dated at Bassett, Wisconsin, this 1st day of January, 2003.

Mark A. Molender
Wisconsin Registered Land Surveyor - 1784