


44-1000-1

DESCRIPTION: Lot 5, Block 2, Warhurst's Subdivision of a portion of the N.E. $\frac{1}{4}$ of the N.E. $\frac{1}{4}$ of the S.W. $\frac{1}{4}$ of Section 23, Township 2 North, Range 17 East of the 4th P.M. in the City of Lake Geneva Walworth County, Wisconsin.

CERTIFICATE: I hereby certify that I have on this the 22nd day of May 1944, surveyed the above described property, according to the official records on file in the Office of the Recorder of Deeds in and for Walworth County, Wisconsin, and find that no encroachments exist, and the plat here shown, is a reproduction of the courses and distances procured at the site on this day.

Signed and sealed on this the 12th day of June 1944.

Joseph M. Biagi
Joseph M. Biagi
Professional Engineer
Elkhorn Wisconsin.

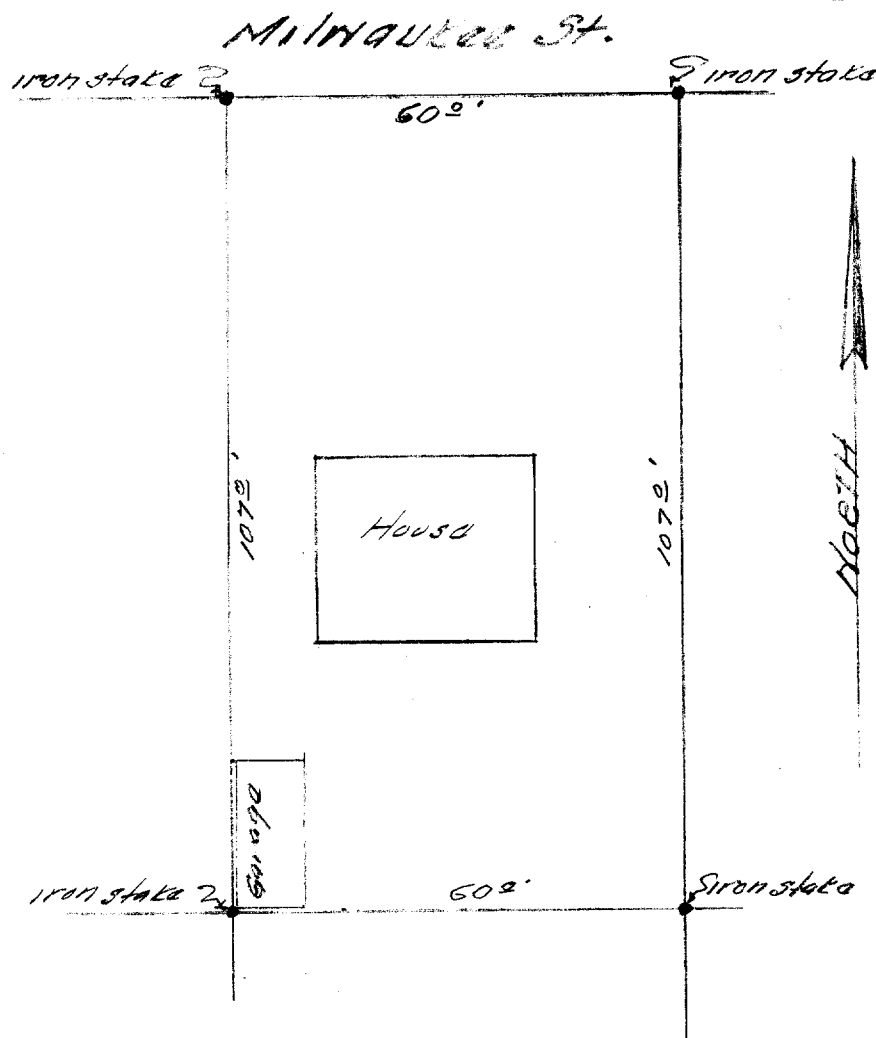

SURVEY
OF
Lot 5 Block 2
Warhurst's Addition
to the
CITY OF LAKE GENEVA
Walworth County Wis.

7-206B