

LISA RACZINSKI  
COLDWELL BANKER PRIMUS  
226 BROAD ST.  
LAKE GENEVA, WI  
53147

# PLAT OF SURVEY


J.K. SURVEYING INC.  
N3705 WILLOWBEND LANE  
LAKE GENEVA, WI, 53147  
262-248-3697

- OF -  
LOT 35 COLUMBIAN SUBDIVISION A SUBDIVISION LOCATED  
IN THE SOUTHEAST 1/4 OF SECTION 26 AND THE SOUTHWEST  
1/4 OF SECTION 25 T.2.N., R.17.E., CITY OF LAKE GENEVA,  
WALWORTH COUNTY, WISCONSIN.

C.L. PLEASANT ST.

( 60' WIDE )

C.L. HIGH STREET

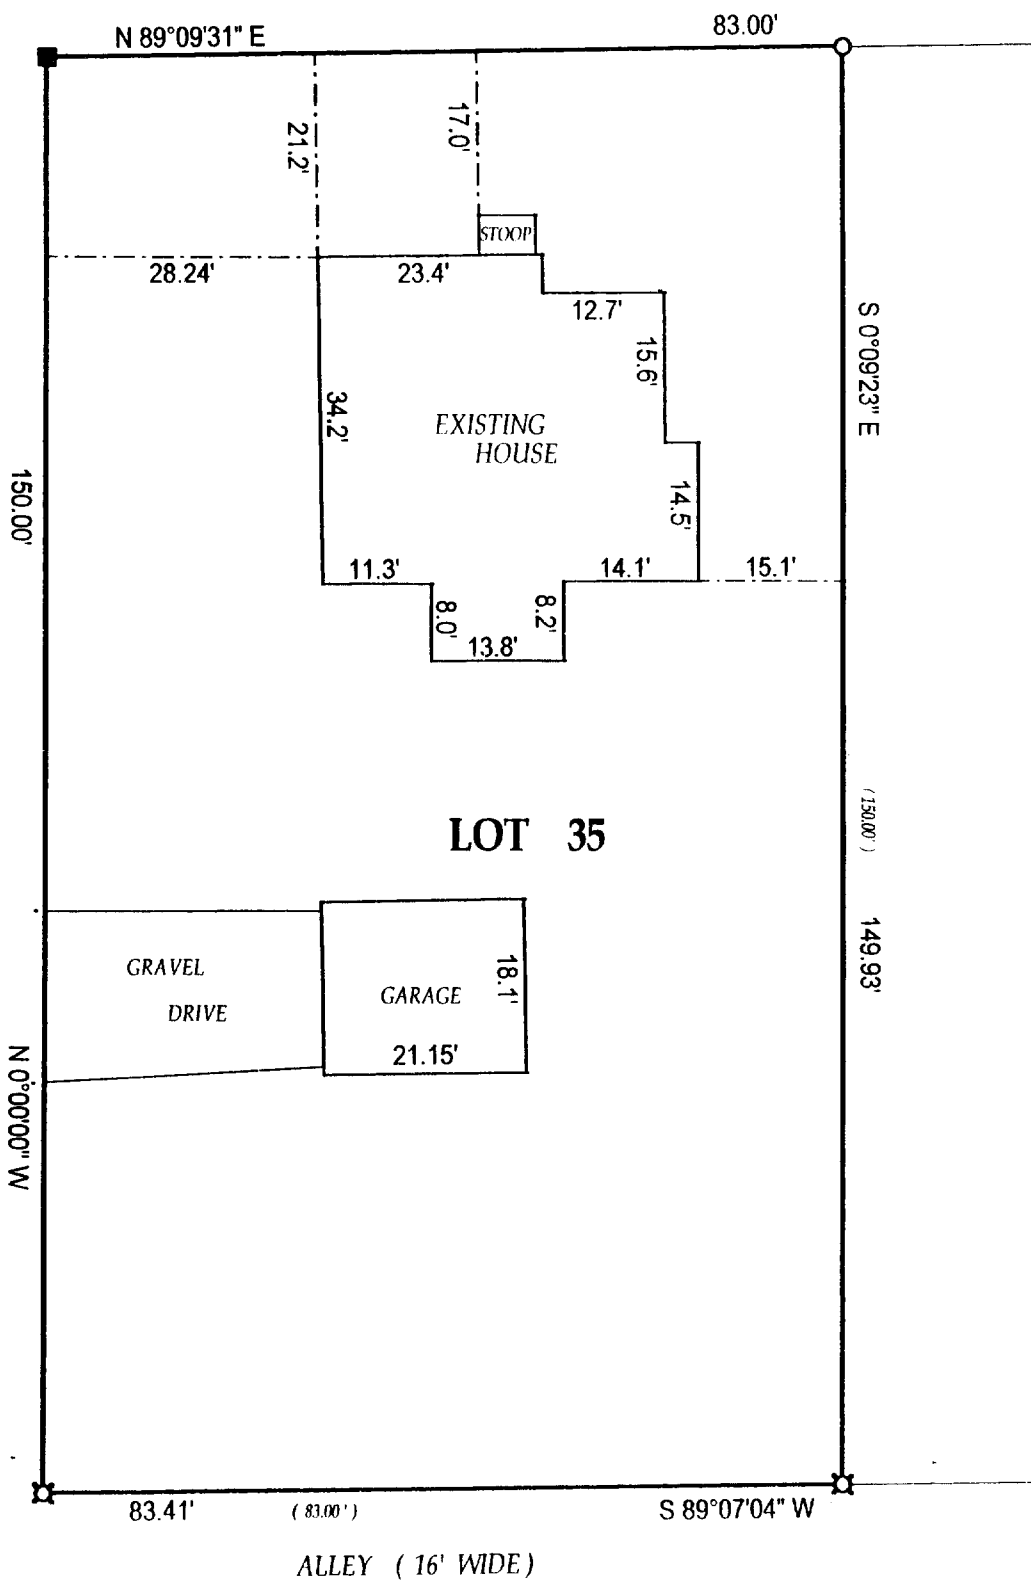

( ) = recorded as

⊗ = set p.k. nail

○ = found iron pipe

● = set iron pipe

■ = set iron bar

SCALE 1" = 20'

JOB # 03-055


TAX ID # ZCL00031A

COMPARE LEGAL DESCRIPTION ABOVE AND DRAWING WITH DEED. FOR BUILDING RESTRICTIONS AND  
EASEMENTS NOT SHOWN, REFER TO DEED, ABSTRACT SOURCES AND LOCAL MUNICIPAL CODES. NOTIFY  
THE SURVEYOR IMMEDIATELY OF ANY DISCREPANCY.

"I hereby certify that I have surveyed the above described property and that  
the above map is a true representation thereof and shows the size and  
location of all visible structures, apparent easements and encroachments  
if any."

This survey is made for the present owners of the property, and those who  
purchase, mortgage, or guarantee the title thereto, within one year from  
the date hereof.

DATED THIS 11 TH, DAY OF FEBRUARY 20 03.

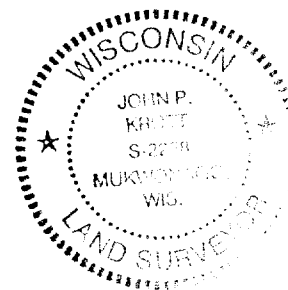

JOHN P. KROTT S - 2258  
Wisconsin Registered Land Surveyor  
( original if signed in red )

007-2080