


PLAT OF SURVEY
OF

all that part of Lot lettered "A" in BOULEVARD SUBDIVISION, being a subdivision of a part of the Northeast Quarter of Section 1, Township 1 North, Range 17 East (of the 4th Principal Meridian), in the City of Lake Geneva, Walworth County, Wisconsin, bounded and described as follows: Beginning at the southerly most corner of said Lot "A"; thence North along the east line of said lot, said east line also being the east line of said Section 1, 212.10 feet to a point; thence South 61 degrees 43 minutes West 124.77 feet to the westerly line of said lot, being also the easterly line of County Trunk Highway "H"; thence South 35 degrees 42 minutes East along said line 188.56 feet to the place of beginning.

ALSO commencing at the northeast corner of said Lot "A"; thence South 111.16 feet to the place of beginning; thence South 61 degrees 43 minutes 00 seconds West 124.77 feet to the northerly right-of-way line of County Trunk Highway "H"; thence North 35 degrees 42 minutes 00 seconds West 2.0 feet along said right-of-way line to a point; thence North 61 degrees 43 minutes 00 seconds East 124.77 feet more or less to a point on the east line of said Lot "A"; thence South to the place of beginning.

TOGETHER with an easement for automobile parking, ingress and egress, 18 feet in width across said Lot "A" described as follows: Commencing at the northeast corner of said Lot "A"; thence South 92.72 feet to the place of beginning; thence continue South 20.44 feet; thence South 61 degrees 43 minutes 00 seconds West 124.77 feet to the northerly right-of-way line of County Trunk Highway "H"; thence North 35 degrees 42 minutes 00 seconds West 18.15 feet along said right-of-way line; thence North 61 degrees 43 minutes 00 seconds East 136.80 feet to the place of beginning as contained in an instrument recorded on September 4, 1975 in Volume 142 of Records at page 647, as Document Number 695947.

LEGAL DESCRIPTION AS PROVIDED.

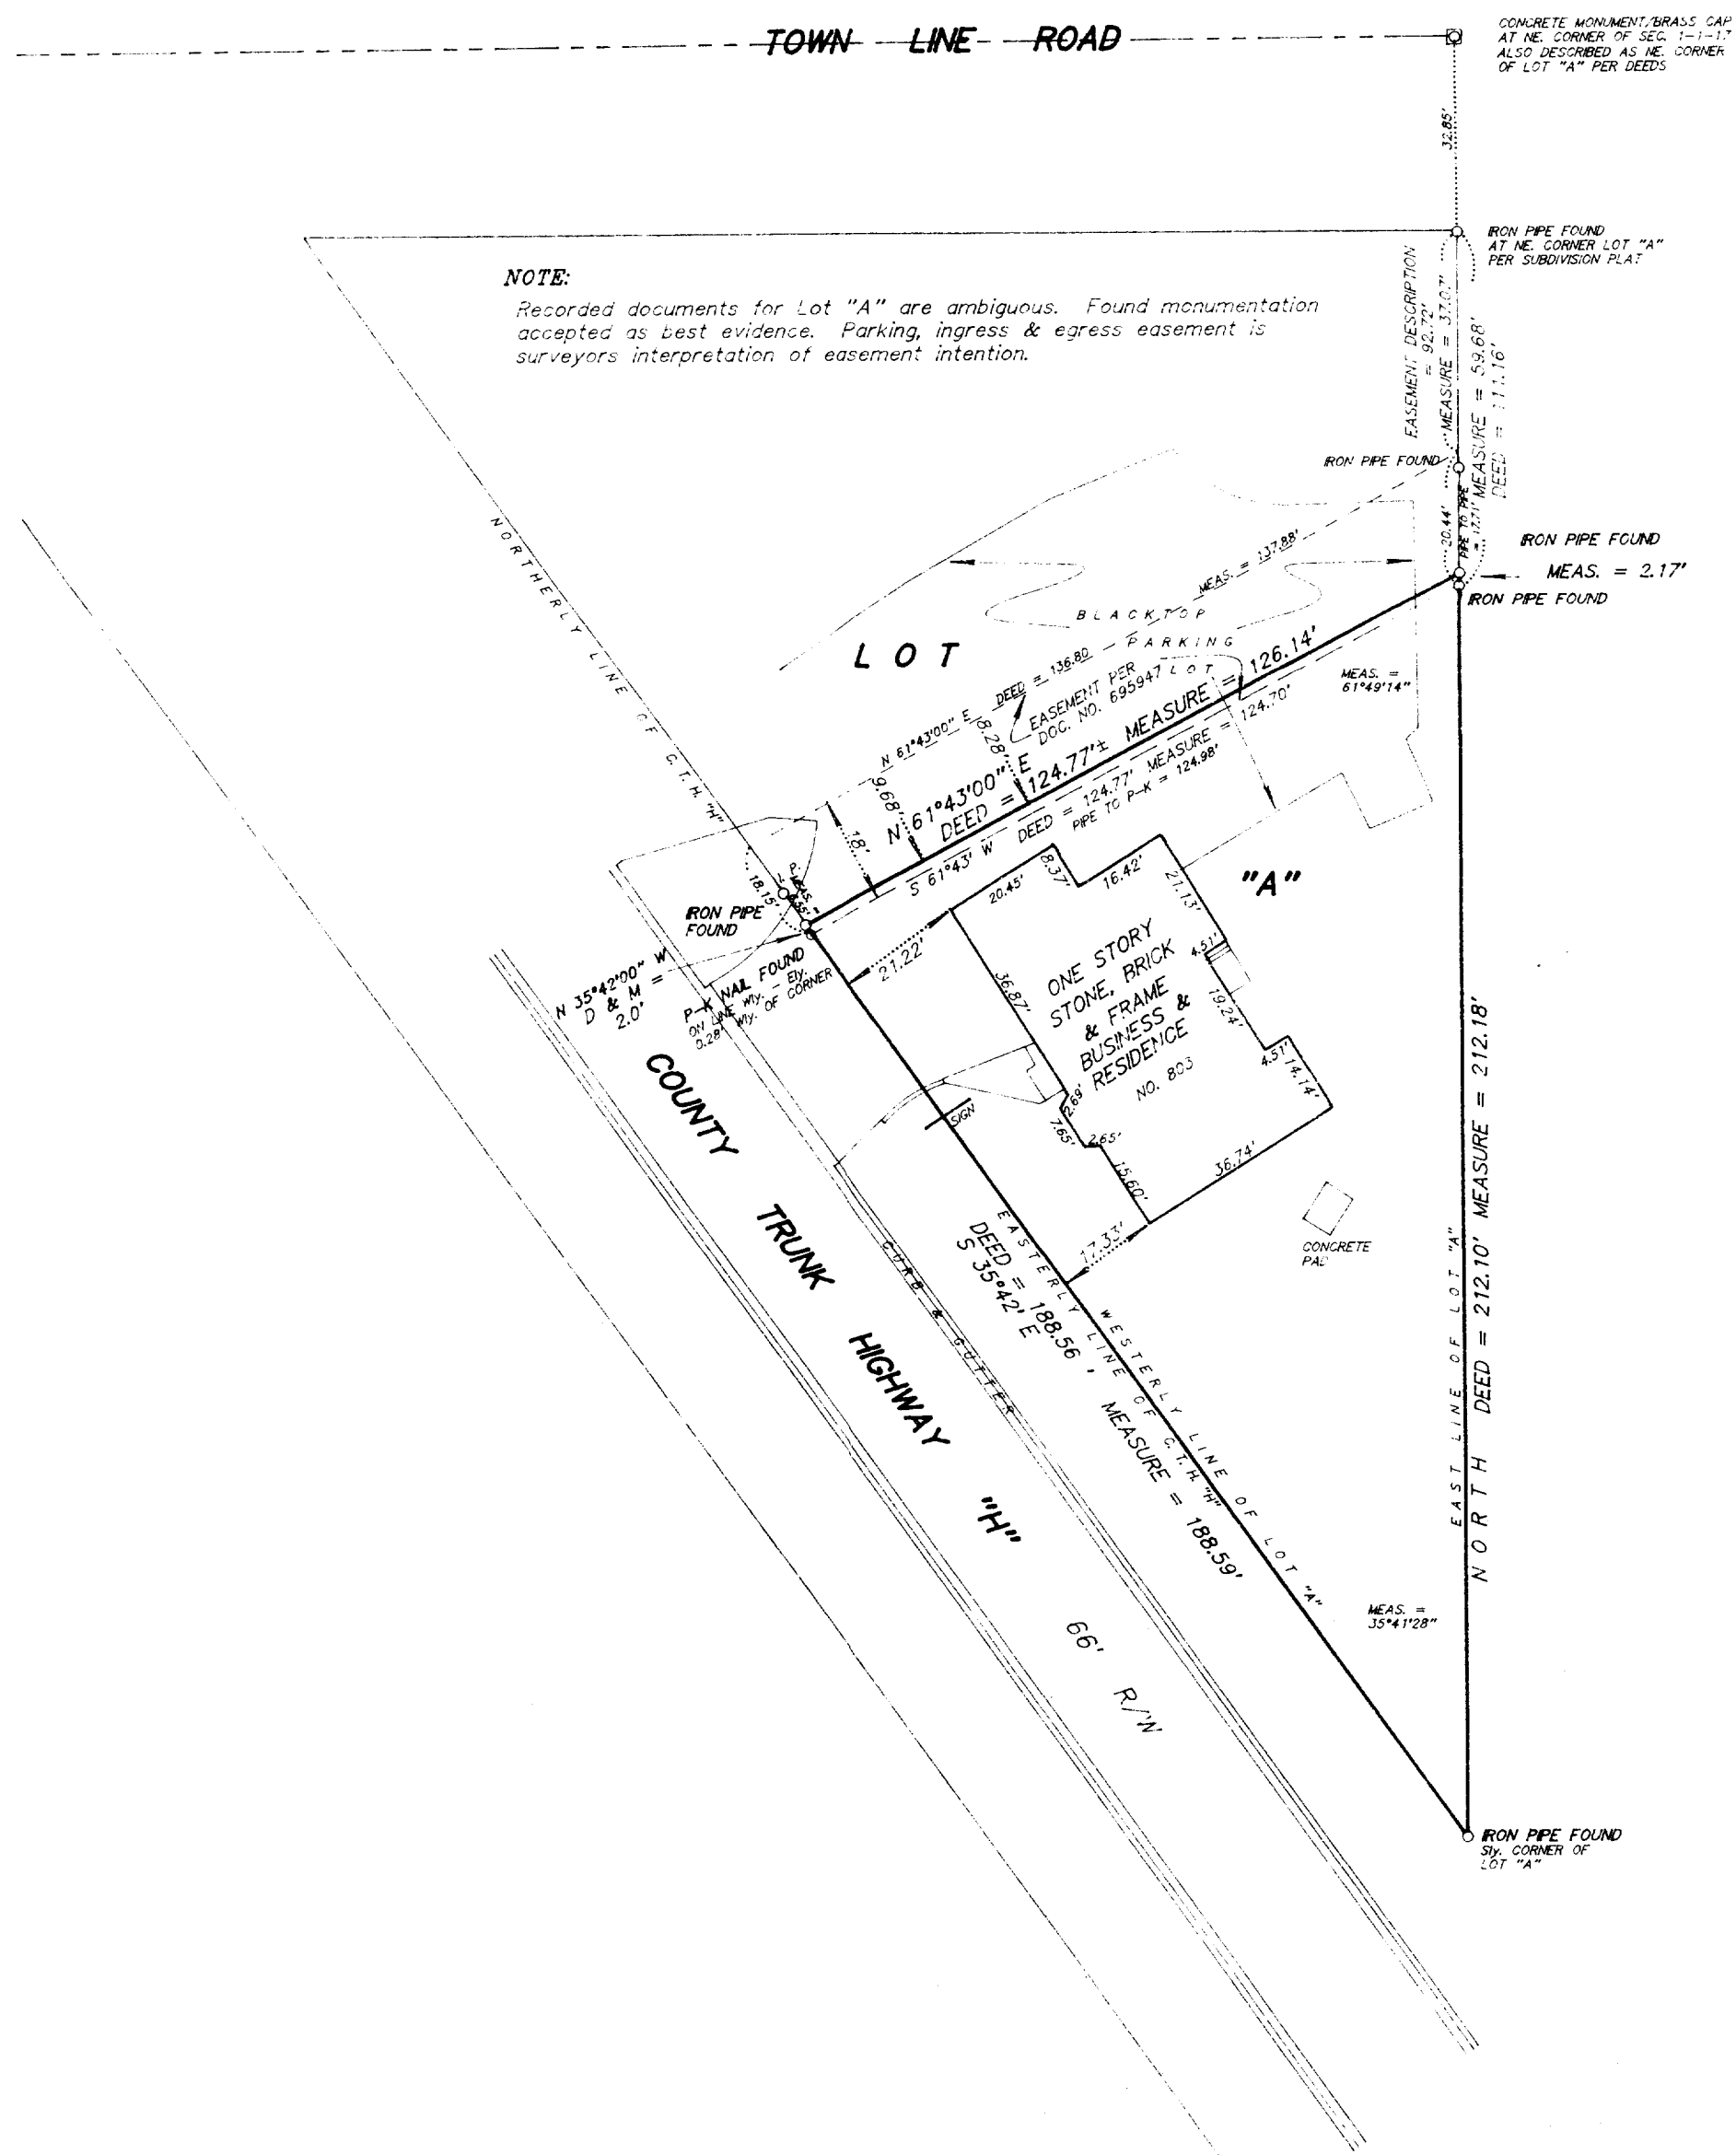

SCALE 1 inch = 30 feet
 ORDERED BY B. Limosani / Homestead Lake Realty
 JOB NO. 99071

I hereby certify that I have surveyed the above identified property and that the plat is a true representation thereof and show the size and location of the property, its exterior boundaries, the existing and proposed buildings and structures thereon, boundary fences, apparent easements and encroachments, if any.

This survey is made for the exclusive use of the present members of the society and also those who have, mortgage, or guarantee a limited liability stock year from the date herein.

dated at basalt, also on the road

Mark A. Bolender
Wisconsin Registered Professional Engineer

007-2088