


HAROLD H. KOLB

REGISTERED PROFESSIONAL LAND SURVEYOR
LAKE GENEVA, WISCONSIN

B.M. - Top of Iron Pipe WISCONSIN STREET
elev. 99.83

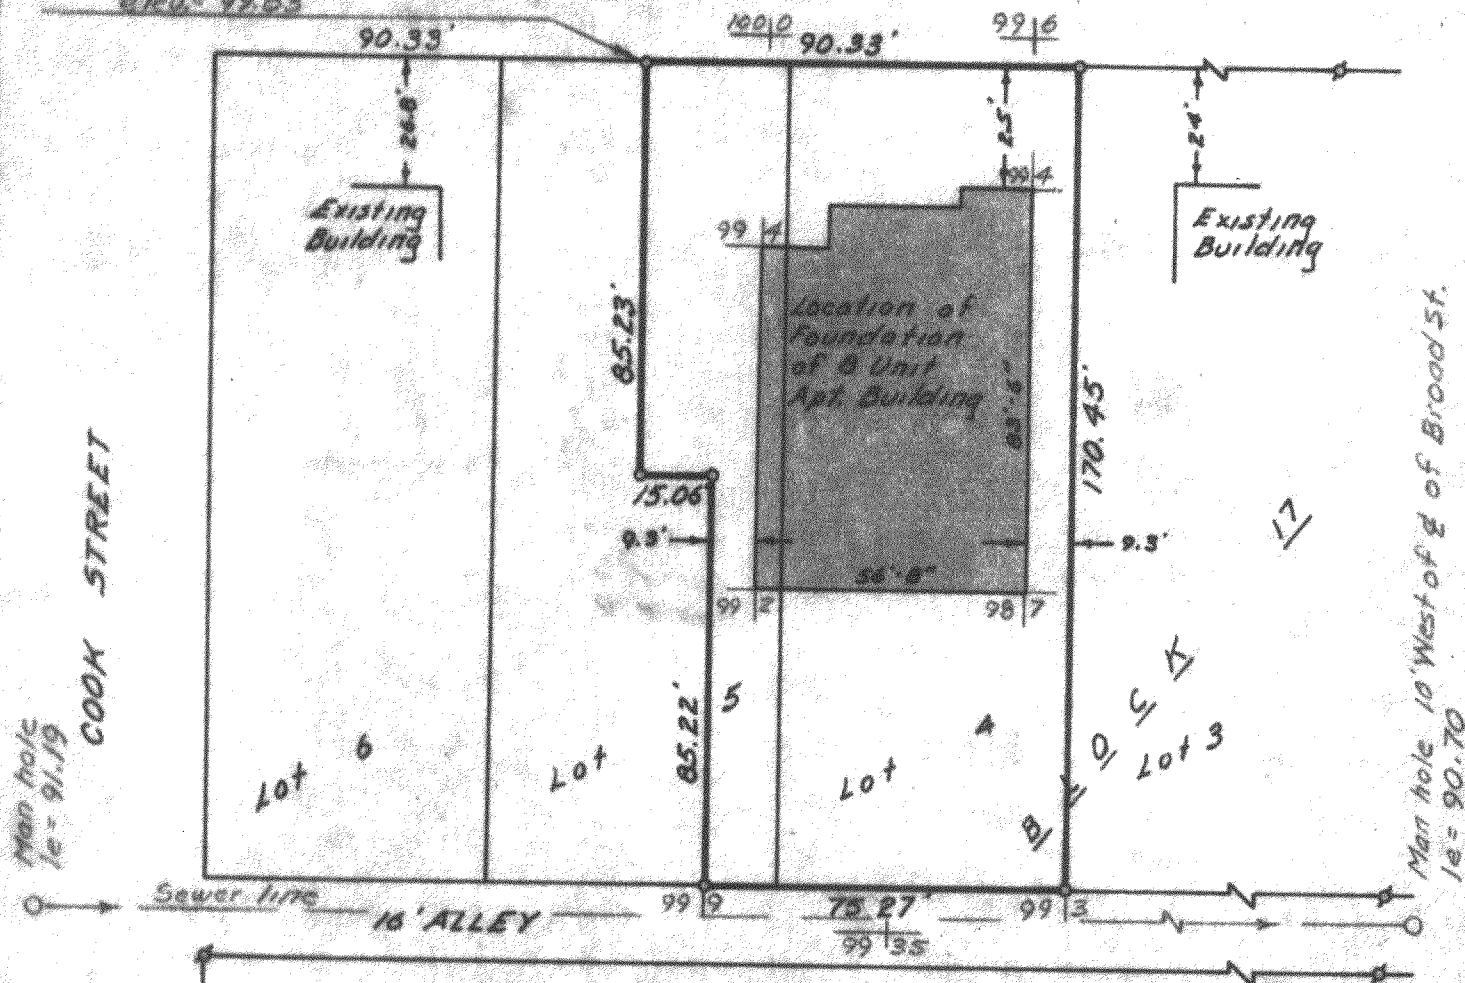

N

SCALE 1"=40'
LEGEND

- Ø - IRON PIPE FOUND
- - IRON PIPE PLACED
- - CONCRETE MONUMENT
- X - SPIKE

PLAT OF SURVEY OF
Lot 4 and part of Lot 5, Block 17, Original
Plat of the Village (Now City) of Lake
Geneva, Walworth County, Wisconsin.

Lot area - 14,108 sq. ft.

Floor area ratio- 0.60

PROPOSED FIRST FLOOR EVEL. 101.25

PROPOSED GROUND ELEV. 100.00

I, HAROLD H. KOLB, DO HEREBY CERTIFY THAT I HAVE
SURVEYED THE PROPERTY HEREON DESCRIBED ACCORDING
TO THE OFFICIAL RECORDS, AND THAT THE PLAT HEREON
IS A CORRECT REPRESENTATION OF THE LOT LINES, and the
principle lines of the buildings thereon.

Harold H. Kolb

HAROLD H. KOLB

WISCONSIN REGISTERED LAND SURVEYOR, S-187

DATE June 1, 1965

REVISED December 7, 1965

Revised February 16, 1966