


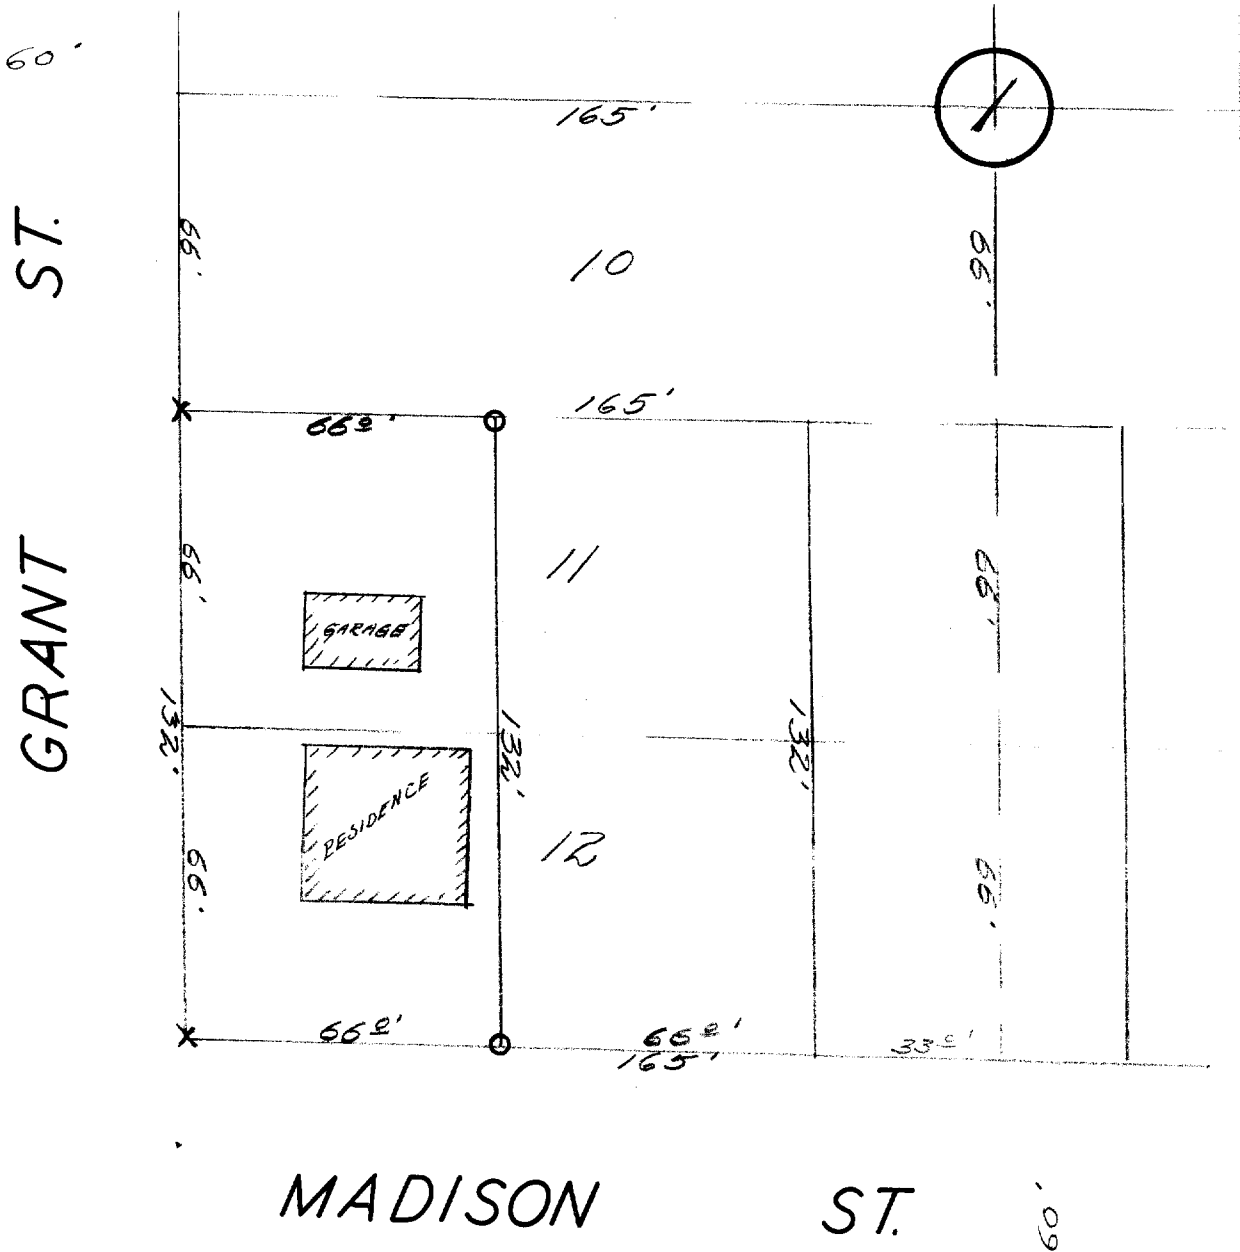

DESCRIPTION:

The south sixty six feet of Lots 11 and 12 Block 1 of Wheeler's Addition to the City of Lake Geneva Walworth County, Wisconsin.

CERTIFICATE:

I, hereby certify that I have on this the 22nd day of July 1949, surveyed the above described property, according to the official records on file in the office of the Recorder of Deeds in and for Walworth County, Wisconsin, and find that the measurements and bearings of the boundary lines of said property as taken at the site on this day, substantially agree with those in said official record, and that no encroachments exist.
SIGNED AND SEALED THIS 27TH DAY OF JULY 1949.

Joseph M. Biagi
Joseph M. Biagi. Professional Engineer.
Elkhorn Wisconsin.