

PREPARED FOR:
 BERNARD BRADEN
 716 WISCONSIN ST.
 LAKE GENEVA, WI
 53147


PLAT OF SURVEY

J.K. SURVEYING INC.
 N3705 WILLOWBEND LANE
 LAKE GENEVA, WI, 53147
 262-248-3697

- OF -

LOTS 7 AND 8 IN BLOCK 14 OF LAKE GENEVA MANOR SUBDIVISION, TRACT NO. 17, EXCEPTING THE FOLLOWING DESCRIBED PREMISES: COMMENCING AT A POINT IN THE THE SOUTH BORDER LINE OF LOT 8 IN BLOCK 14 WHICH POINT IS 10 FEET IN A SOUTHWESTERLY DIRECTION FROM THE SOUTHEASTERLY CORNER OF LOT 8 IN BLOCK 14 AFORESAID; RUNNING THENCE NORTHERLY IN A STRAIGHT LINE TO THE NORTHEASTERLY CORNER OF LOT 8 BLOCK 14; THENCE IN A SOUTHERLY DIRECTION ALONG THE EASTERLY BORDER LINE OF LOT 8 BLOCK 14 TO THE SOUTHEASTERLY CORNER OF LOT 8; THENCE IN A SOUTHWESTERLY DIRECTION ALONG THE SOUTHERLY BORDER LINE OF LOT 8 BLOCK 14, 10 FEET TO THE PLACE OF BEGINNING.

Kw

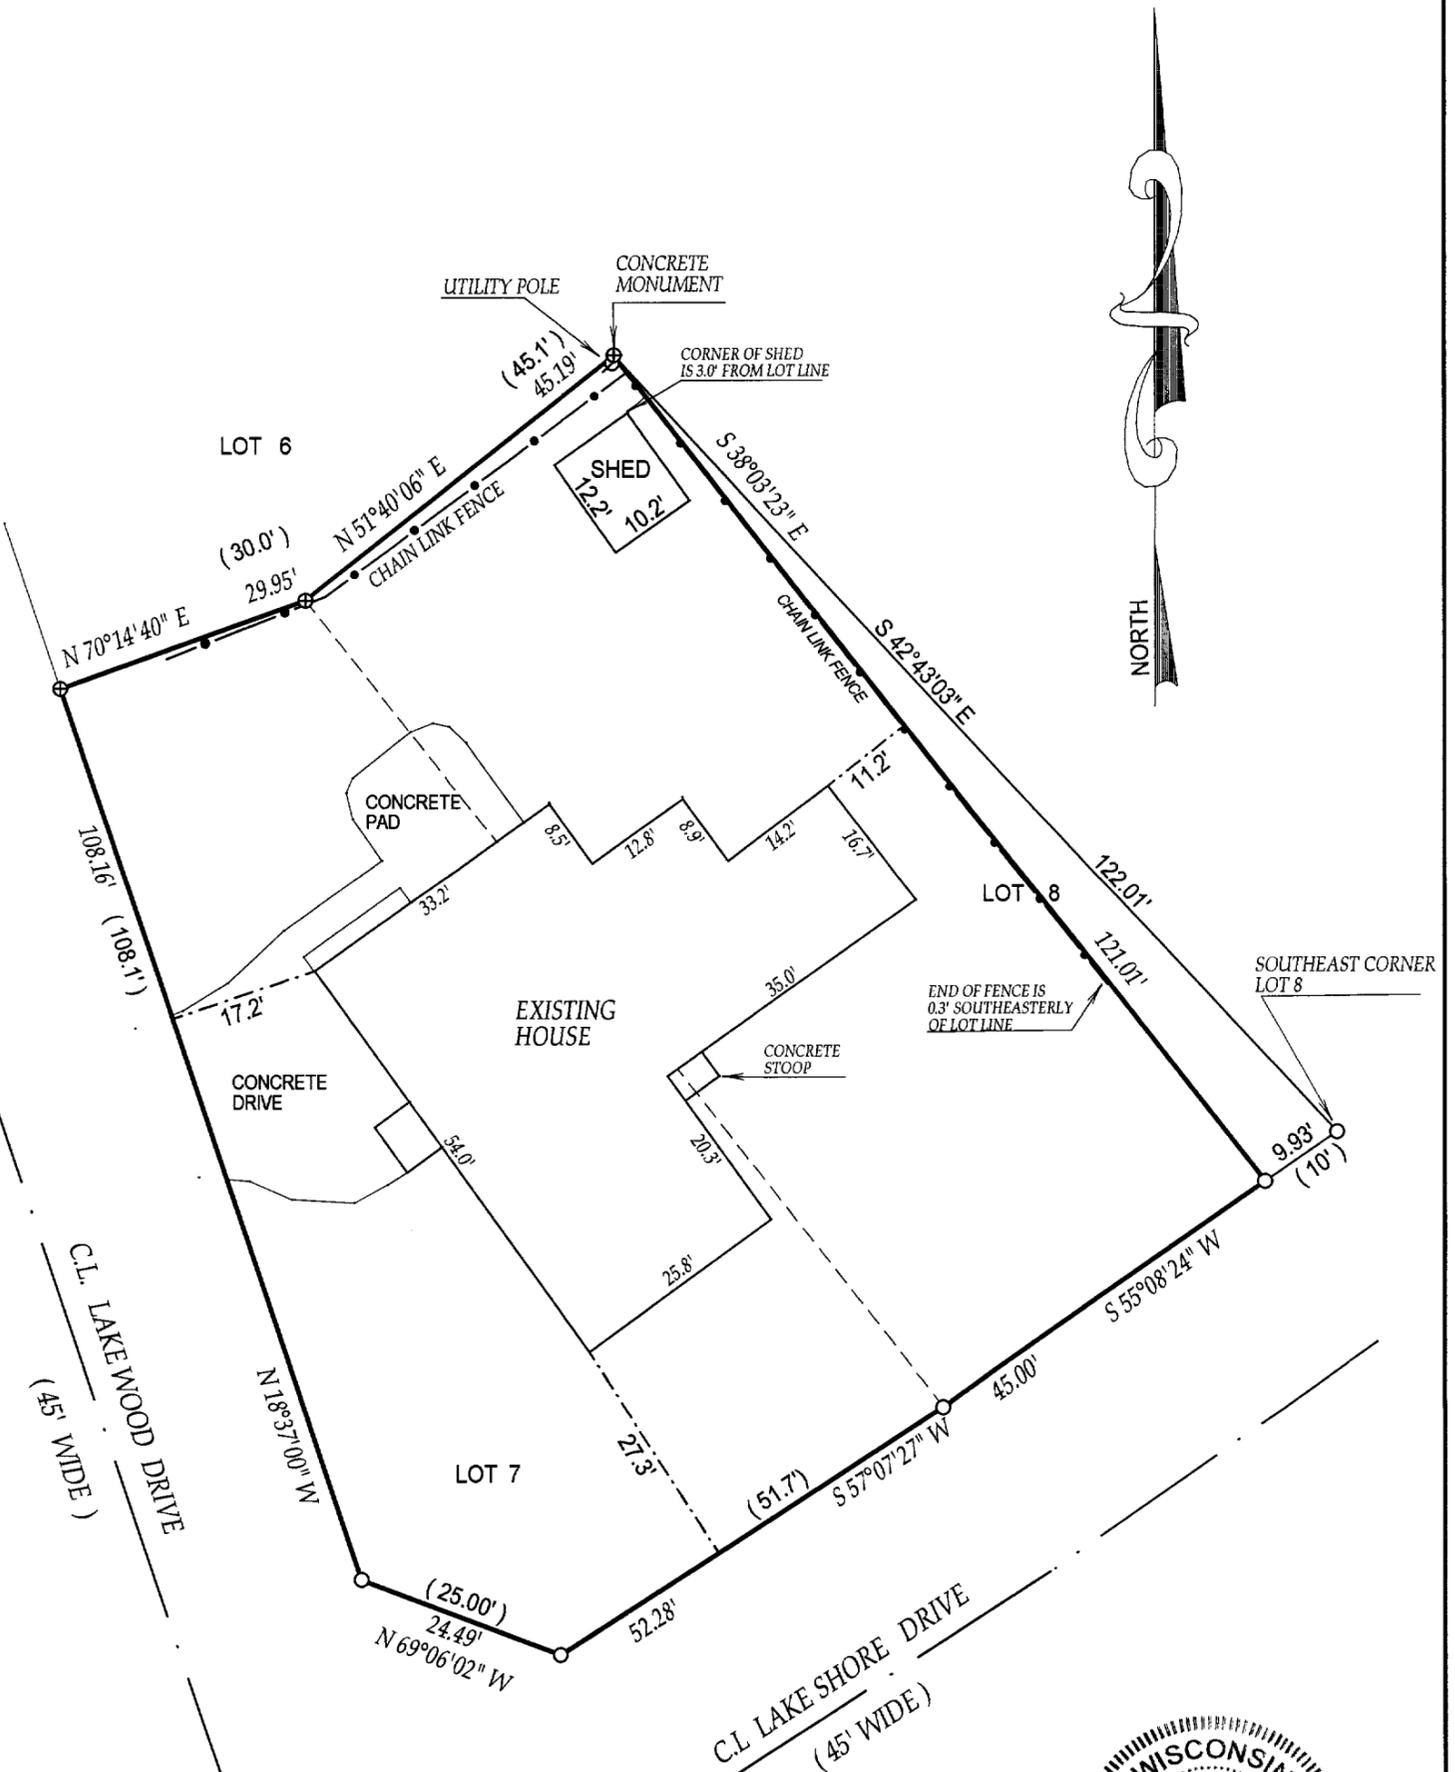

- () = recorded as
- = found iron bar
- = found iron pipe
- = set iron pipe
- = set iron bar

SCALE 1" = 20'

JOB # 03-658

TAX ID # ZLM-18

COMPARE LEGAL DESCRIPTION ABOVE AND DRAWING WITH DEED. FOR BUILDING RESTRICTIONS AND EASEMENTS NOT SHOWN, REFER TO DEED, ABSTRACT SOURCES AND LOCAL MUNICIPAL CODES. NOTIFY THE SURVEYOR IMMEDIATELY OF ANY DISCREPANCY.

"I hereby certify that I have surveyed the above described property and that the above map is a true representation thereof and shows the size and location of all visible structures, apparent easements and encroachments if any."
 This survey is made for the present owners of the property, and those who purchase, mortgage, or guarantee the title thereto, within one year from the date hereof.



John P. Krott
 JOHN KROTT S - 2258
 Wisconsin Registered Land Surveyor
 (original if signed in red)

DATED THIS 21st, DAY OF OCTOBER, 2003

007-2162