


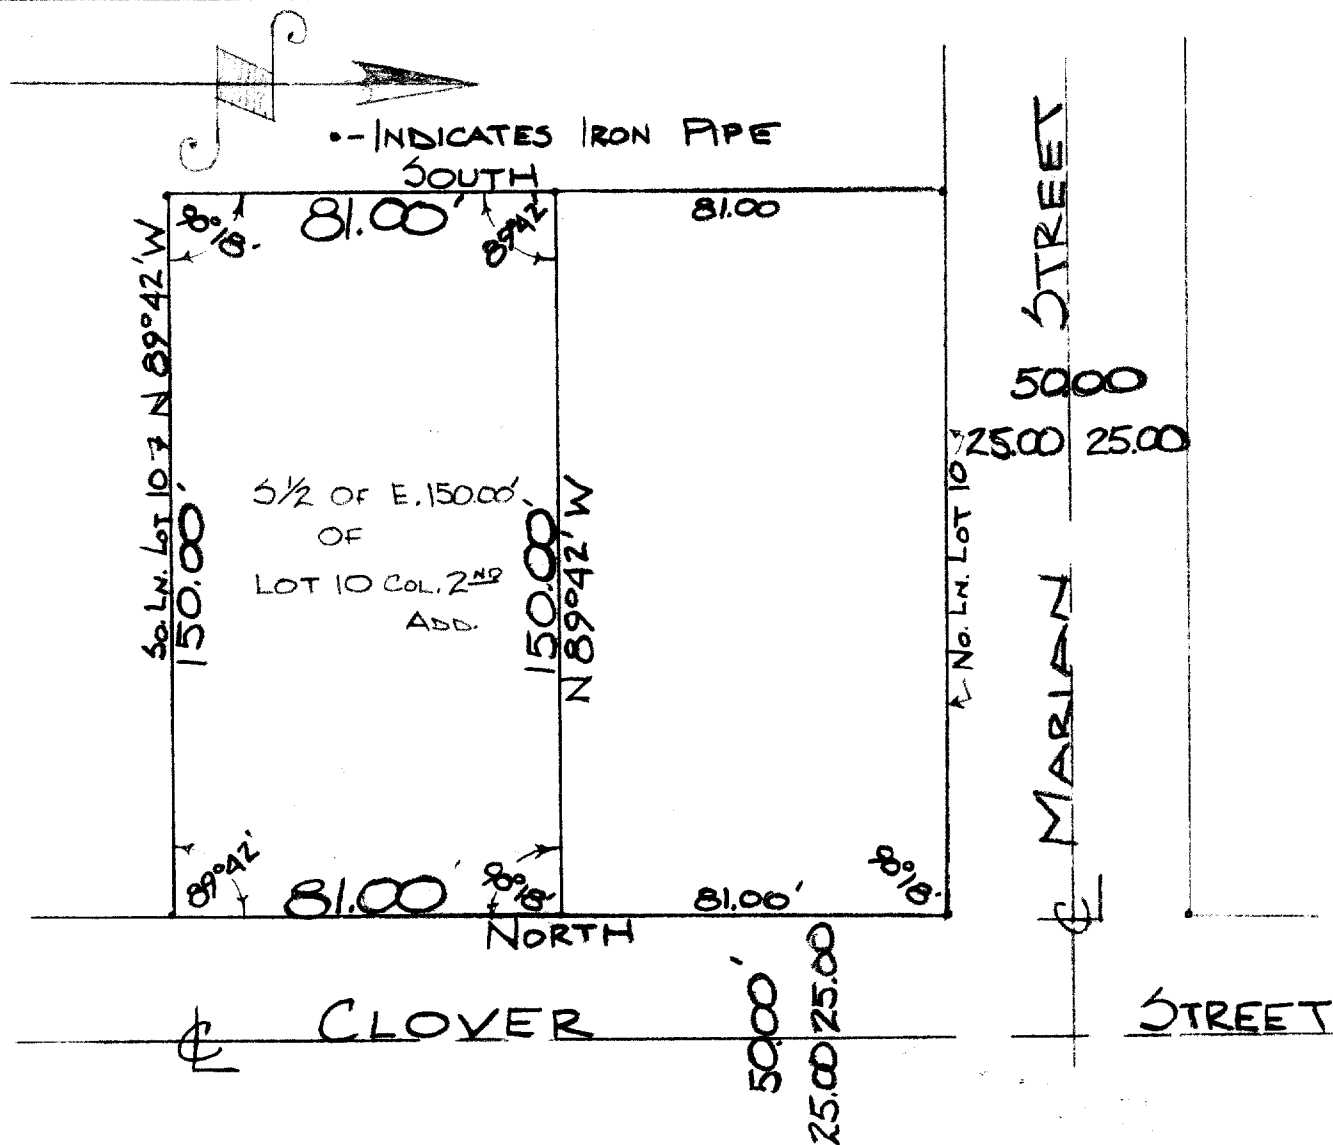

DESCRIPTION:

The north one-half of the east one hundred fifty feet of Lot 10, of Columbian 2nd ~~Subdivision~~ in the City of Lake Geneva, Walworth County, Wisconsin.

CERTIFICATE:

I, James F. Biagi, surveyor, do hereby certify that I, have surveyed the property hereon described, on this the 25th day of November 1961.

Signed and sealed on this the 25th day of November 1961.



James F. Biagi, (RLS 272)
Elkhorn, Wisconsin.