


48-29

HORACE ST.

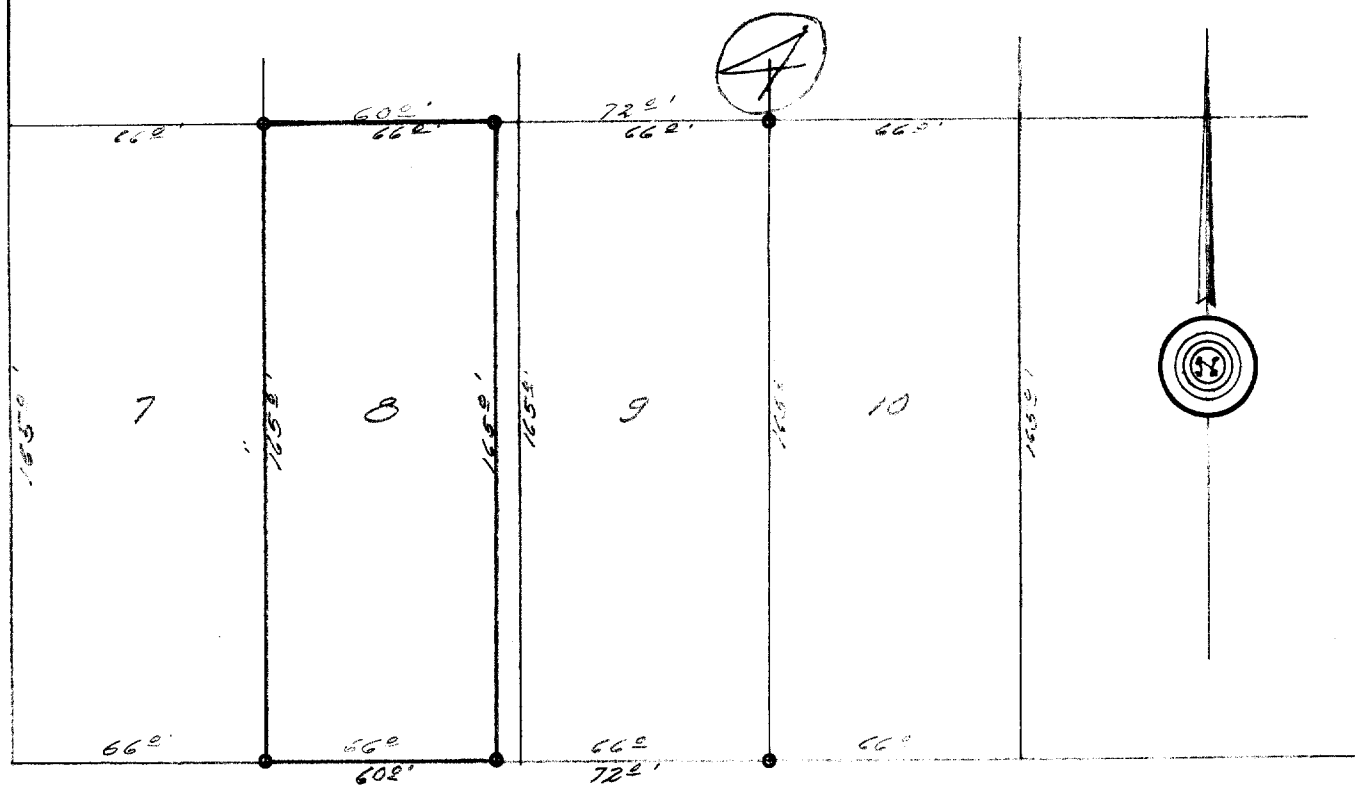

WHEELER ST.

TOLMAN ST.

DESCRIPTION:

The West sixty (60) feet of Lot 8, Block 4; Wheeler's Addition to the City of Lake Geneva Walworth County, Wisconsin.

CERTIFICATE:

I, hereby certify that I, have on this the 7th day of August 1943, surveyed the above described property according to the official plat on file in the office of the Recorder of Deeds in and for Walworth County, Wisconsin, and find that, the measurements and bearings of the boundary lines of the property as taken at the site on this day, substantially agree with those on the above drawn plat.

SIGNED AND SEALED THIS 9TH DAY OF AUGUST 1943.

Joseph M. Biagi
Joseph M. Biagi, Professional Engineer.
Elkhorn Wisconsin.

7-220B

204-21