


48-35

GRANT

ST.

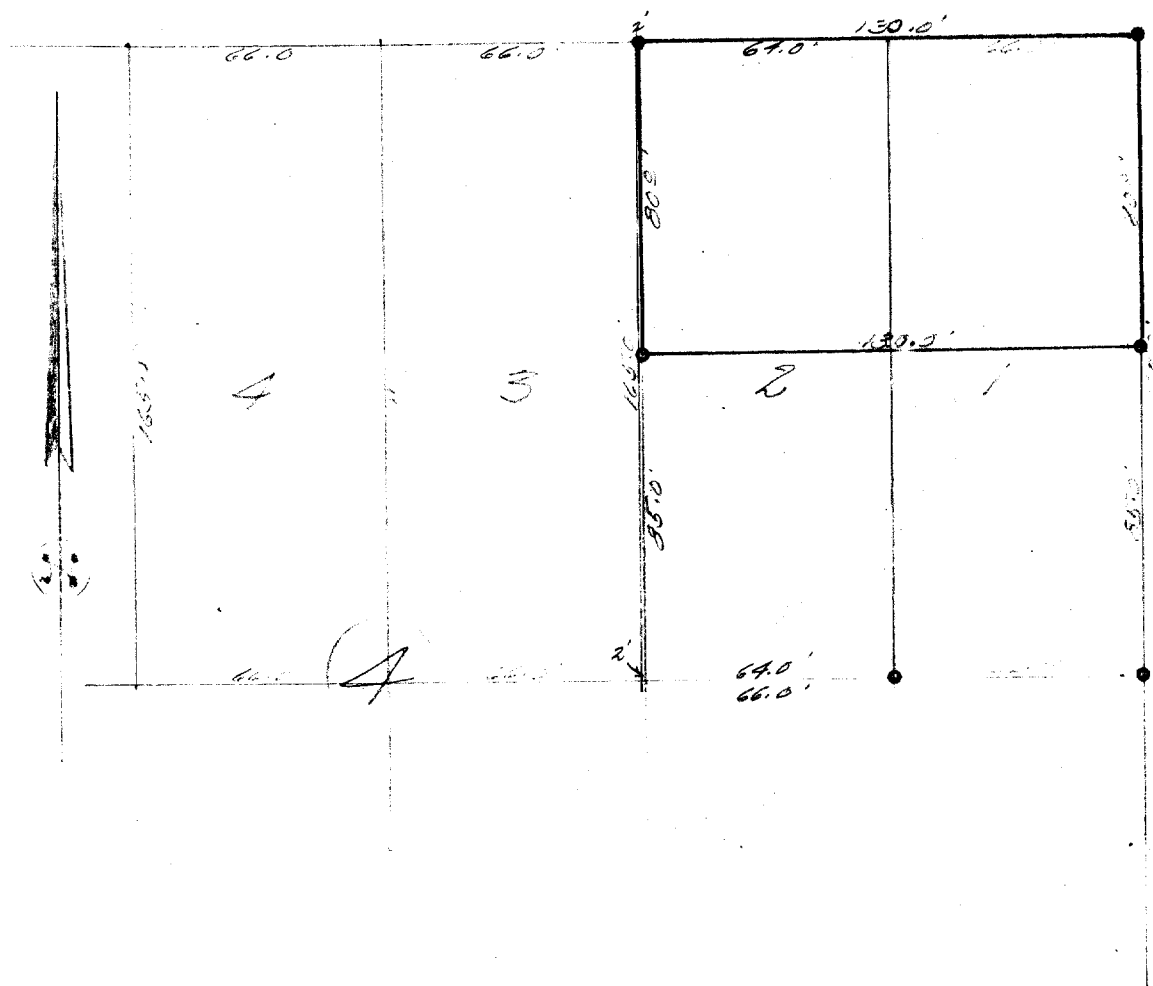

DESCRIPTION: The north 80.0 feet of Lot 1, & the east 84.0 feet of the north 80.0 feet, of Lot 2, of Block 4, Wheeler's Addition to the City of Lake Geneva, Walworth County, Wisconsin.

CERTIFICATE: I, hereby certify that I, have on this the 10th day of July, 1948, surveyed the above described property according to the official record on file in the office of the Recorder of Deeds in and for Walworth County, Wisconsin, and find that the measurements and bearings of the boundary lines of said property as taken at the site on this day, substantially agree with those in the above description and that no encroachments exist.

SIGNED AND SEALED THIS 10th DAY OF JULY 1948.

Joseph M. Biagi
Joseph M. Biagi,
Professional Engineer
Elkhorn Wisconsin.