

PLAT OF SURVEY


PREPARED FOR:
CINDY MAHER
COLDWELL BANKER PRIMUS
226 BROAD ST.
LAKE GENEVA, WI 53147

J.K. SURVEYING INC.
FORMERLY KOLB LAND CONSULTING
N3705 WILLOW BEND LANE LAKE GENEVA, WI
(262) 248-3697

DATE OF LAST REVISION: 10 / 28/2004
DATE: 4-13-2000

DESCRIPTION: LOT 18, GARRISON GLEN SUBDIVISION, A DIVISION OF LOT 3 OF CERTIFIED SURVEY MAP NO. 2008, RECORDED IN VOLUME NO. 9 ON PAGE NO. 295 OF WALWORTH COUNTY CERTIFIED SURVEY MAPS AS DOCUMENT NO. 206794; LOCATED IN THE SOUTHWEST 1/4 AND SOUTHEAST 1/4'S OF THE NORTHEAST 1/4 OF SECTION 1, TOWN 1 NORTH, RANG 17 EAST, CITY OF LAKE GENEVA, WALWORTH COUNTY, WISCONSIN.



GARRISON DR. (60') WIDE

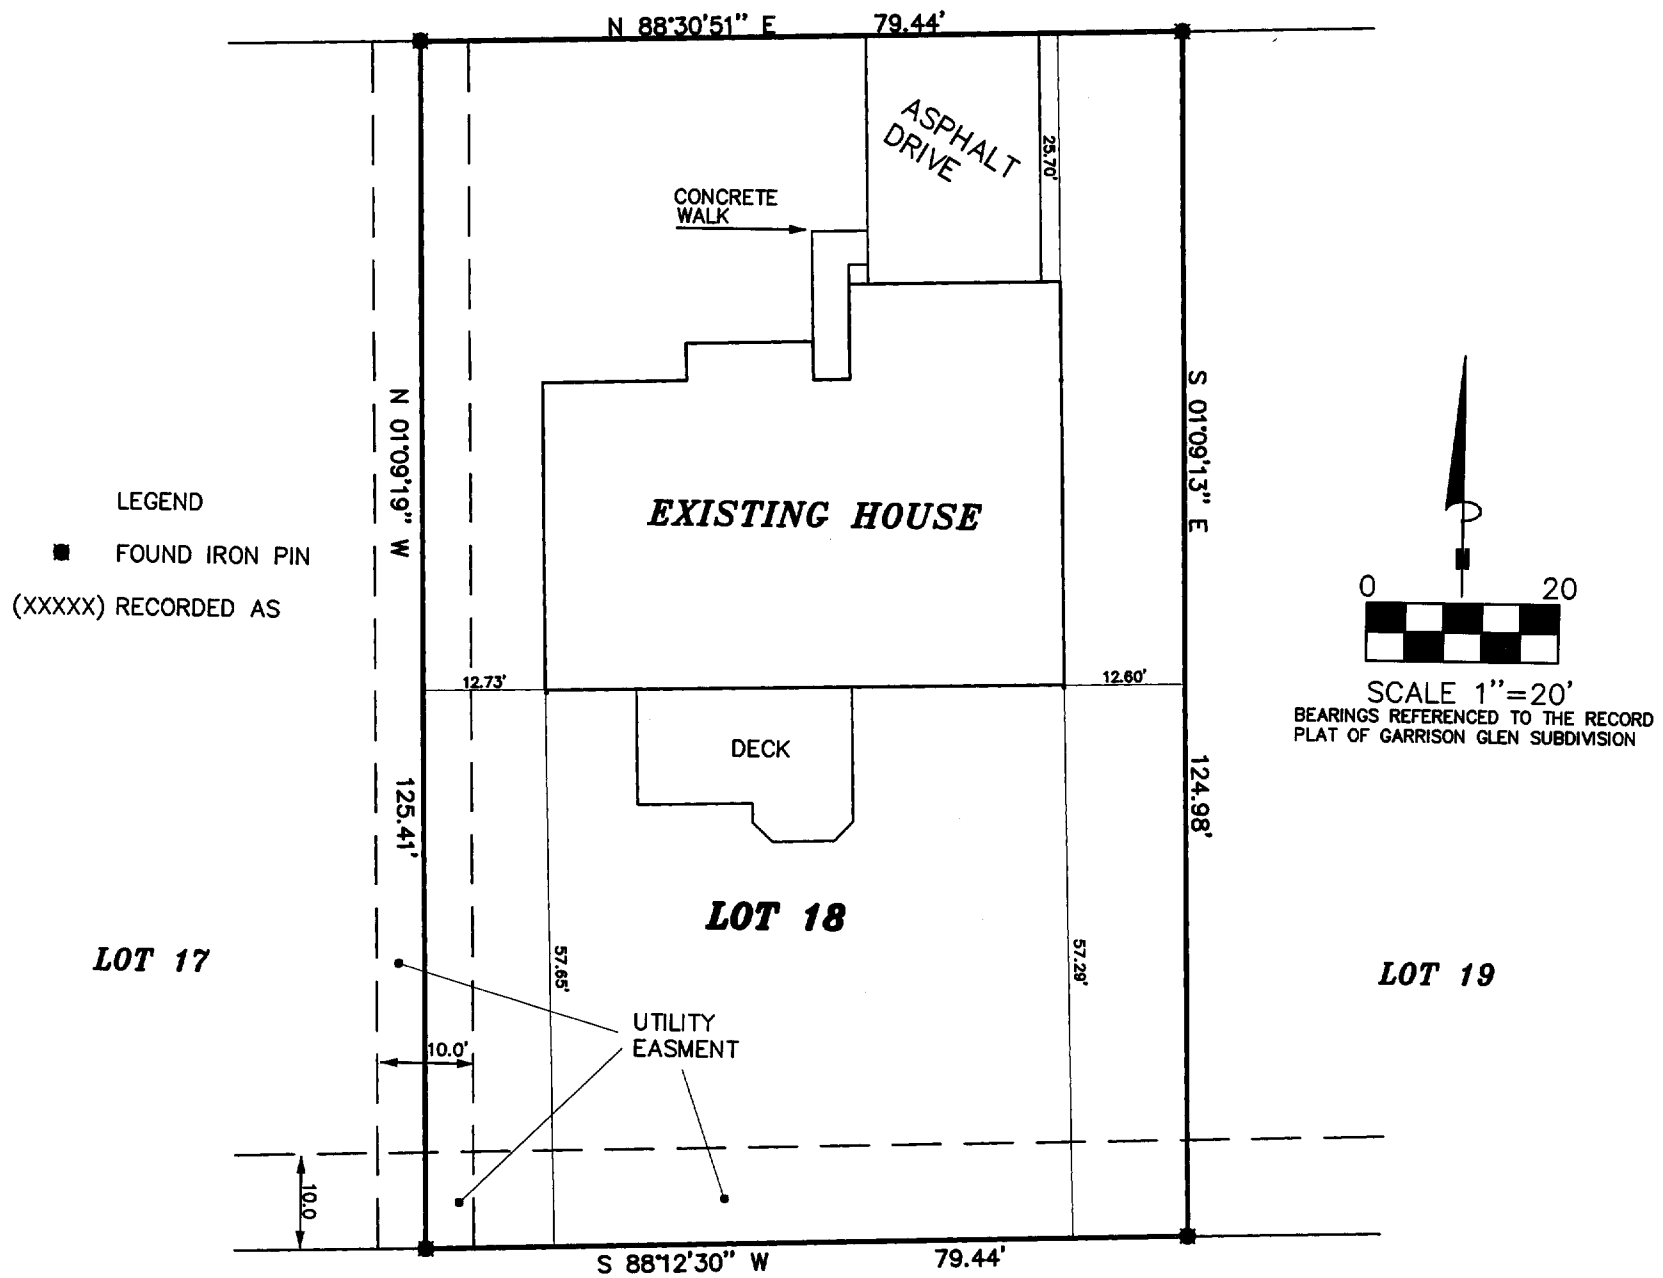

THE ABOVE MAP IS A TRUE REPRESENTATION THEREOF AND SHOWS THE SIZE AND LOCATION OF ALL THE PROPERTY, EXTERIOR BOUNDARIES, THE LOCATION OF ALL VISIBLE BOUNDARY FENCES, APPARENT EASEMENTS, ROADWAYS AND VISIBLE ENCROACHMENTS, IF ANY

THIS SURVEY IS MADE FOR THE USE OF THE PRESENT OWNERS OF THE PROPERTY , AND ALSO THOSE WHO PURCHASE , MORTGAGE OR GURANTEE TITLE THERETO WITHIN ONE (1) YEAR FROM DATE HERETO.

JOHN P. KROTT , R.L.S. 2258

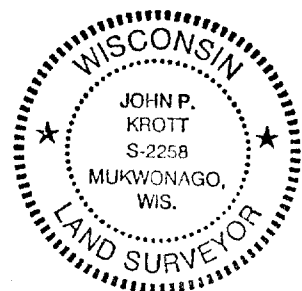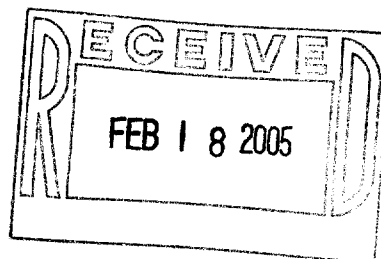

NOTE: THIS IS NOT A CERTIFIED COPY
UNLESS SEAL IS IN RED.

JOB NUMBER #00028 ZGAR 18

007-2240