


WALWORTH

STREET

N

SCALE - 1" = 20'
O = IRON PIPE

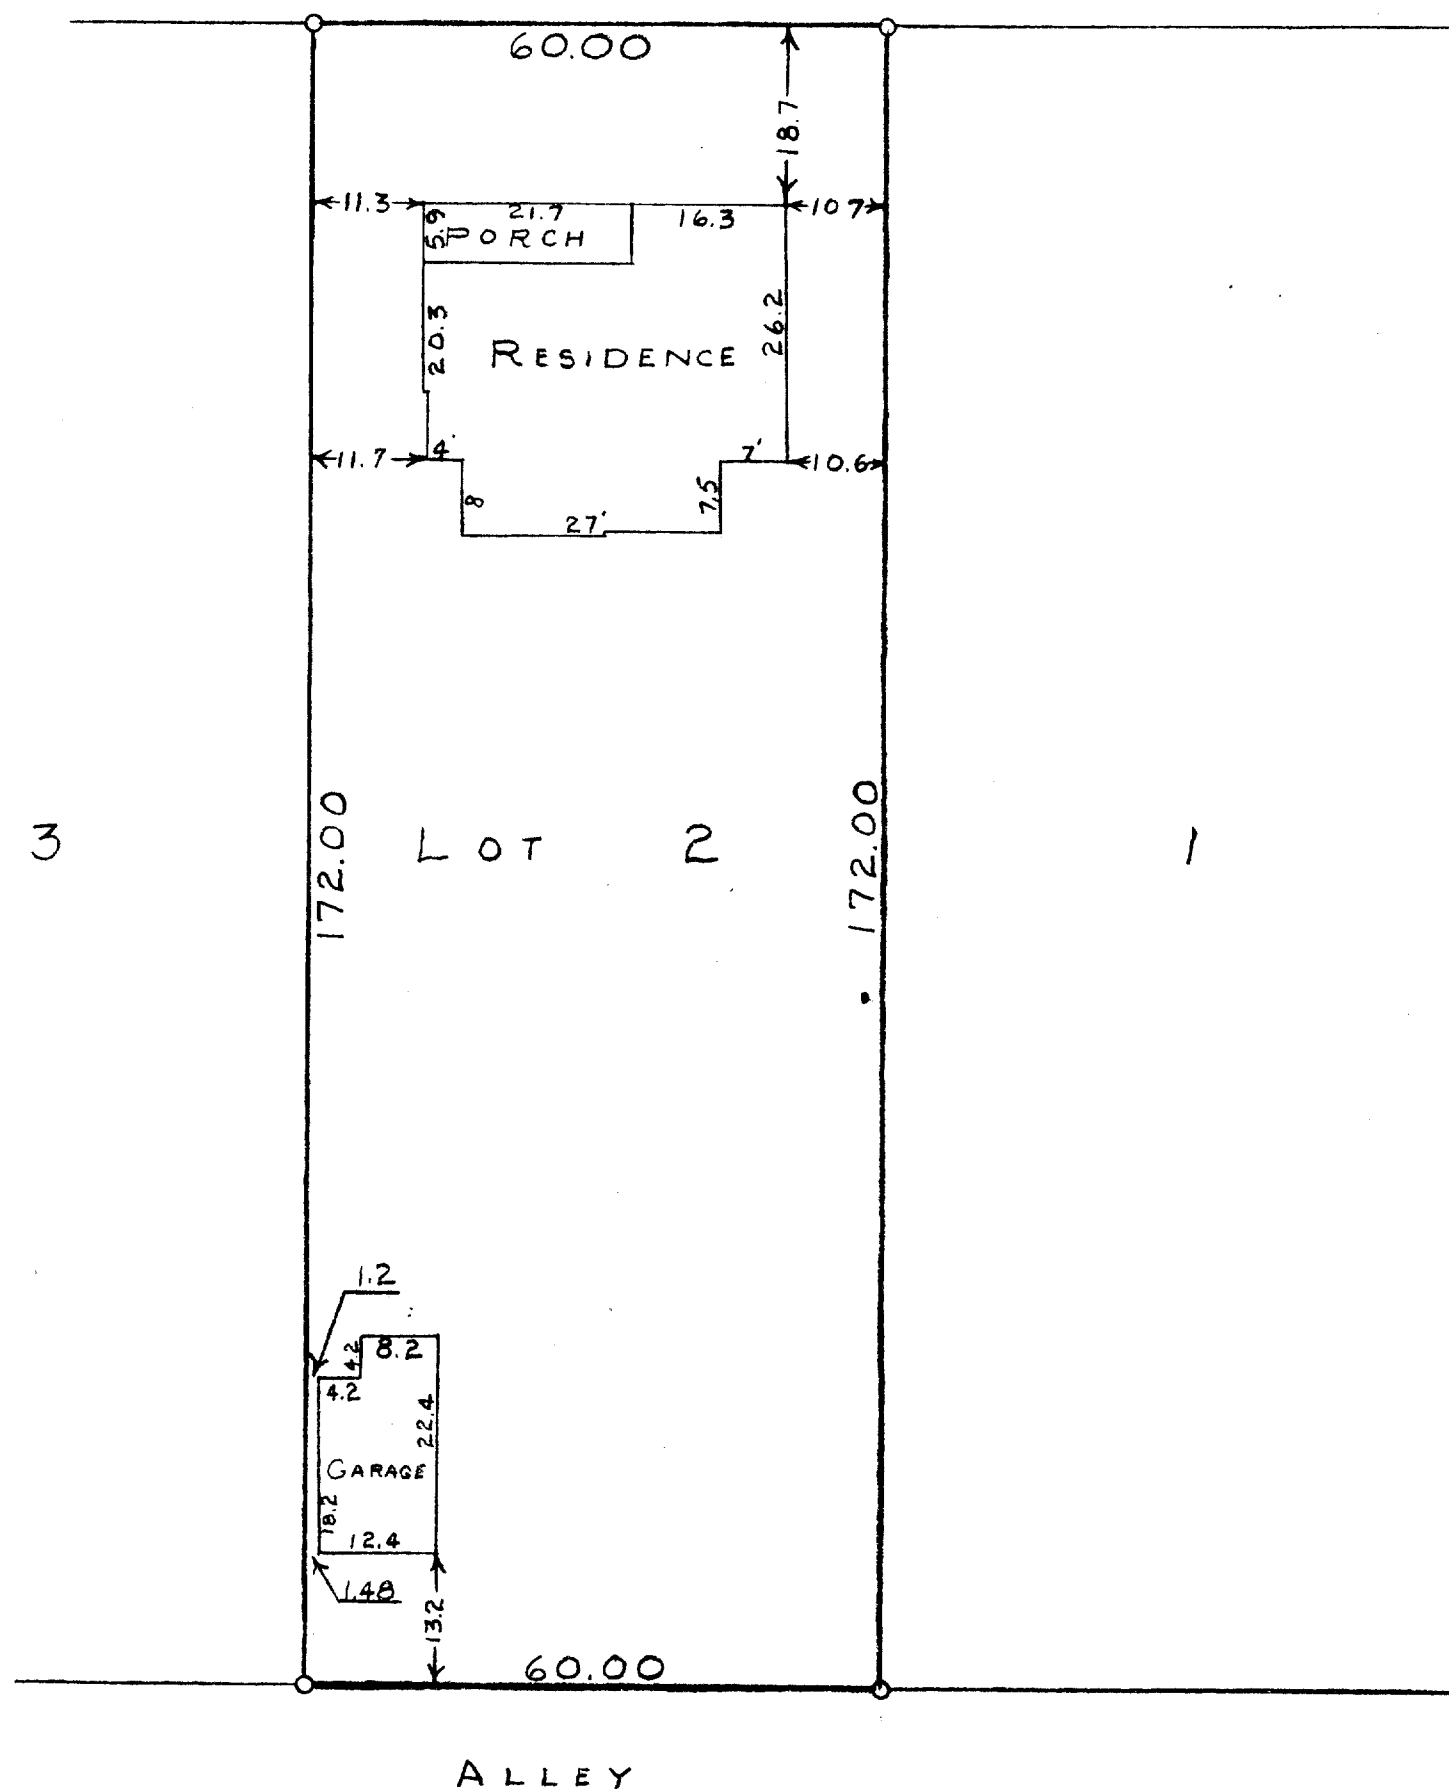

STREET

WAVERLY

STATE OF WISCONSIN
COUNTY OF WALWORTH

I, GEORGE T. DUNHAM, DO HEREBY CERTIFY THAT I HAVE SURVEYED THE
PROPERTY DESCRIBED AS FOLLOWS:

LOT 2, BLOCK 22, GENEVA LAKE CRAWFORD MANUFACTURING COMPANY
ADDITION TO THE CITY OF LAKE GENEVA, WALWORTH COUNTY, WISC.
AND THAT THE PLAT SHOWN ABOVE IS A CORRECT REPRESENTATION OF THE
PROPERTY LINES
MARCH 14, 1955

George T. Dunham
GEORGE T. DUNHAM, SURVEYOR
DELAVER, WISCONSIN

7-23

GC-122