


HAROLD H. KOLB
REGISTERED PROFESSIONAL LAND SURVEYOR
LAKE GENEVA, WISCONSIN

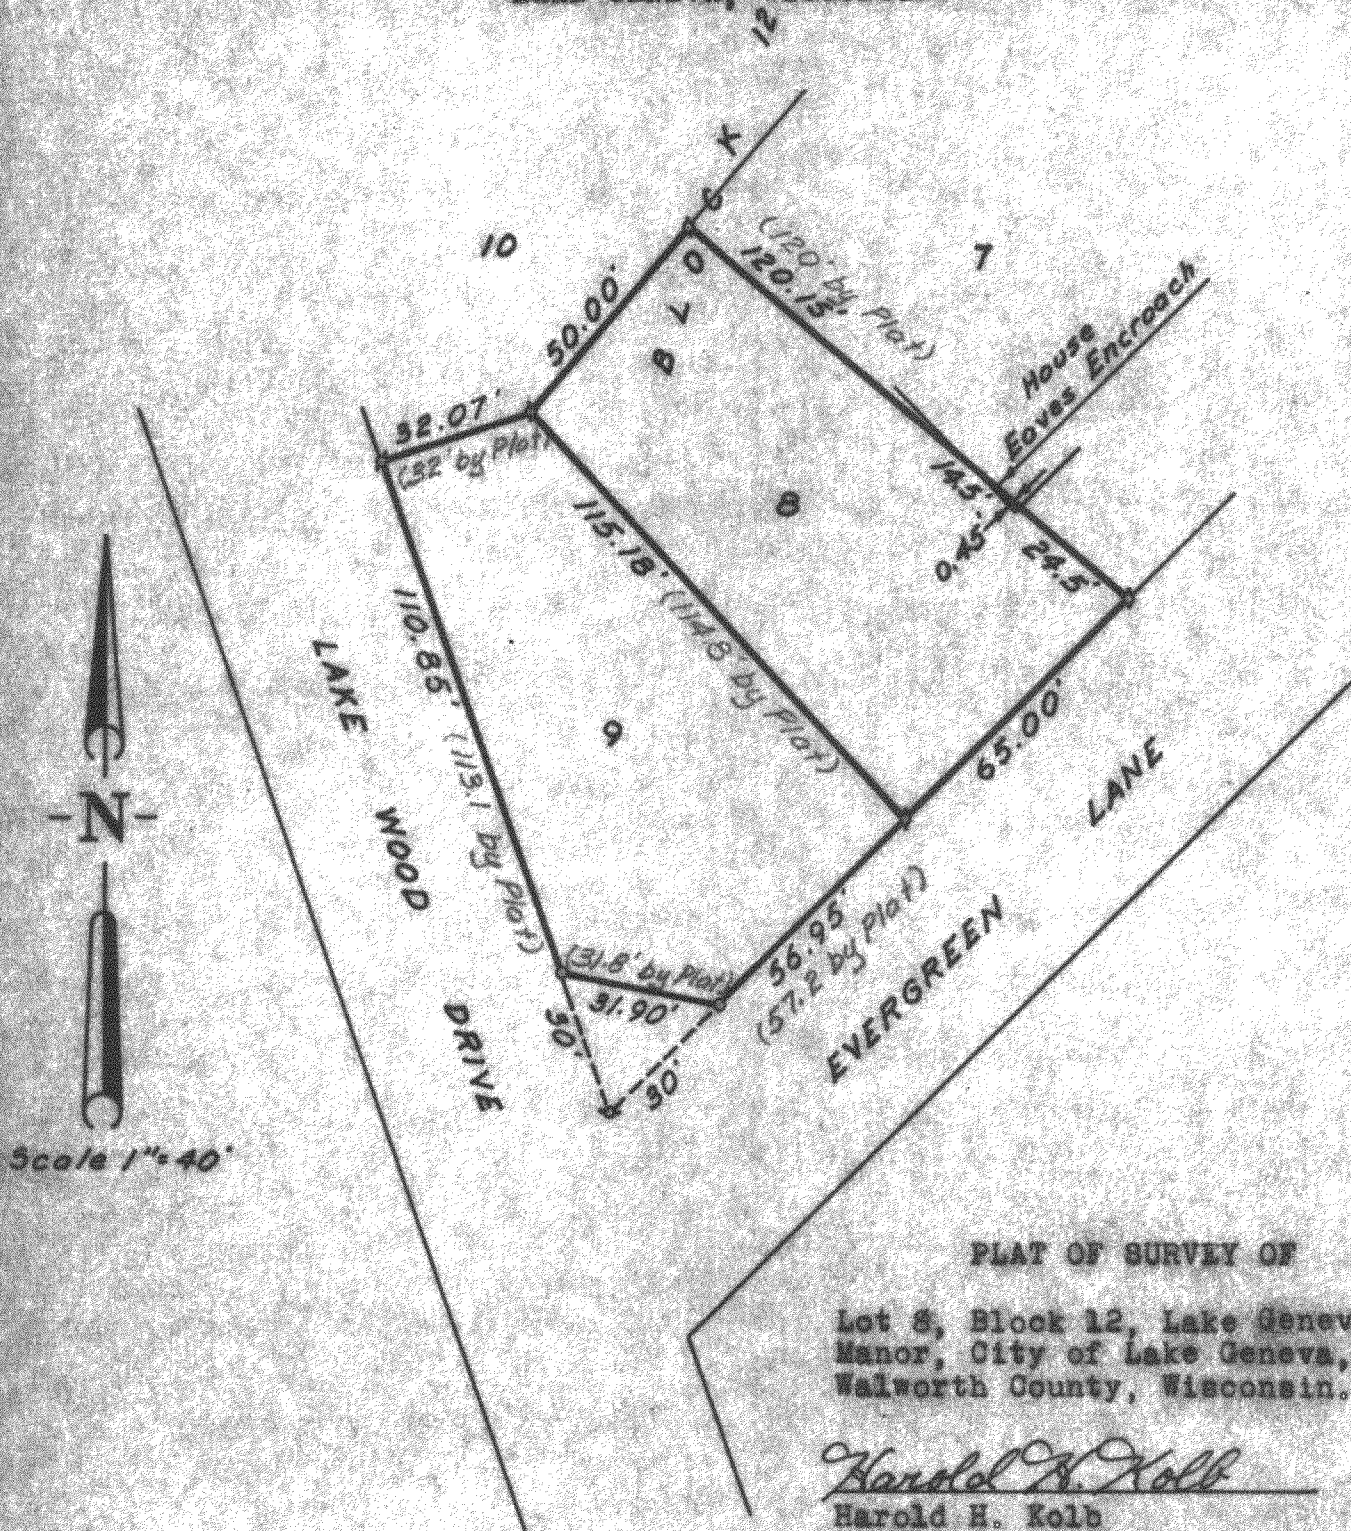

PLAT OF SURVEY OF

Lot 8, Block 12, Lake Geneva
Manor, City of Lake Geneva,
Walworth County, Wisconsin.

Harold H. Kolb

Harold H. Kolb
Wisconsin Surveyor, 8-157
DATE: May 9, 1964

Resurvey of Lot 8 and survey of Lot 9
Block 12.
DATE: June 25, 1966

o - Iron Pipe Placed
x - Iron Pipe Found ZLM-10

7-233

REVISED 4-6-96