


PLAT OF SURVEY

DESCRIPTION:

LOTS 6, 7, 8, 9 AND PART OF LOT 10, BLOCK 26 OF
THE ORIGINAL PLAT OF THE CITY OF LAKE GENEVA,
WALWORTH COUNTY, WISCONSIN.

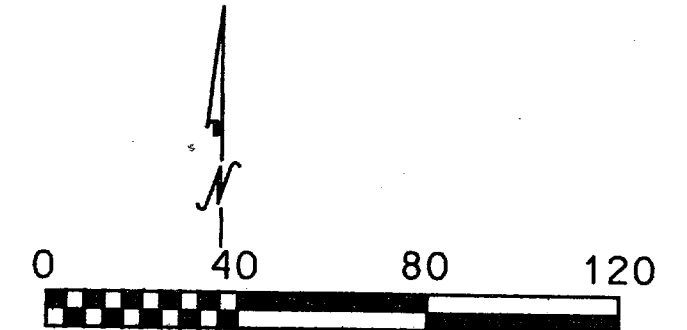


SCALE 1" = 40'


RECERTIFICATION
DATE: 10/24/2005

FOR: KEEFE ASSOCIATES

COOK STREET

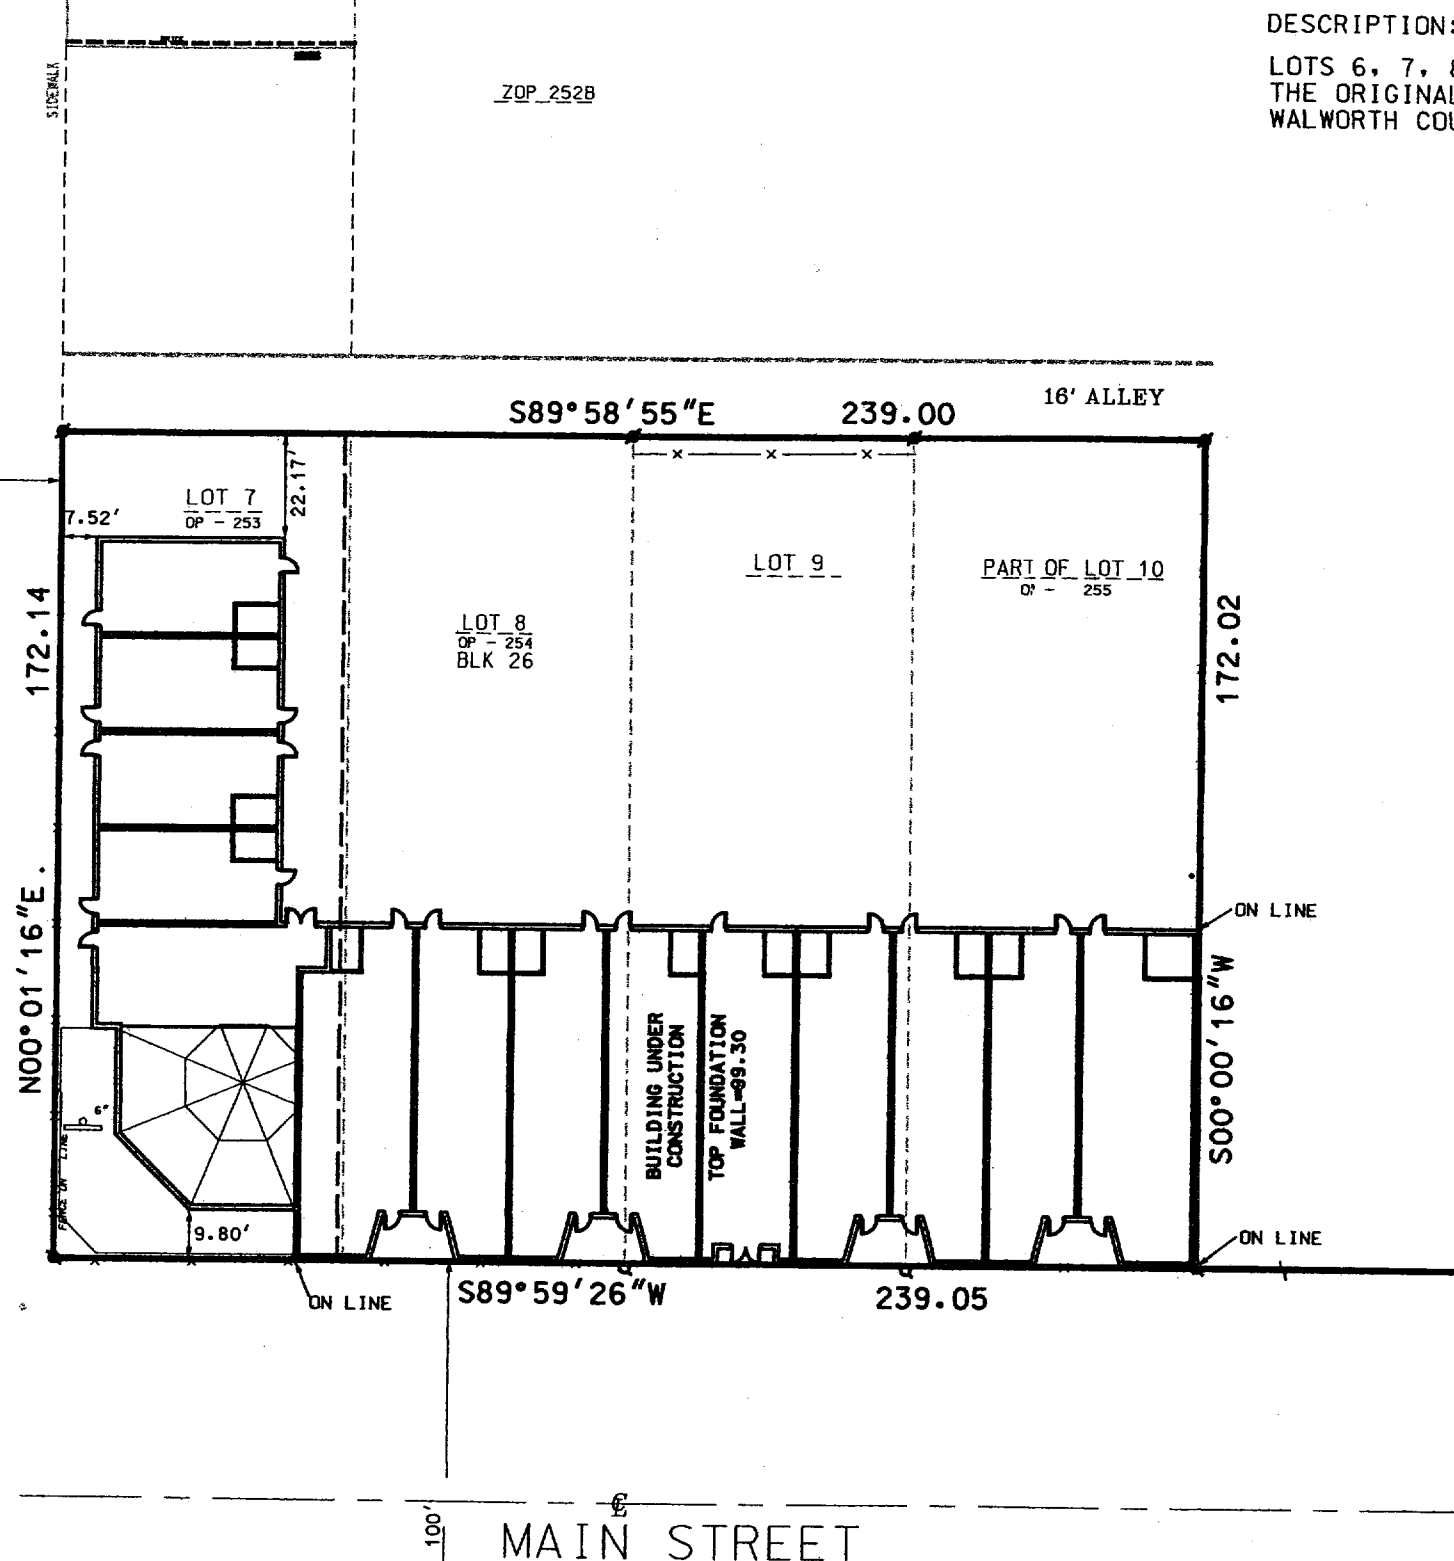

I PAUL H. VAN HENKELUM R.L.S. # 1931 HEREBY
CERTIFY THAT THIS SURVEY WAS MADE IN
ACCORDANCE WITH THE MINIMUM STANDARDS FOR
PROPERTY SURVEYS (CHAPTER A-E7) STATE OF
WISCONSIN AND HAS BEEN PREPARED UNDER MY
DIRECTION AND CONTROL AND IS CORRECT TO THE
BEST OF MY KNOWLEDGE AND BELIEF.

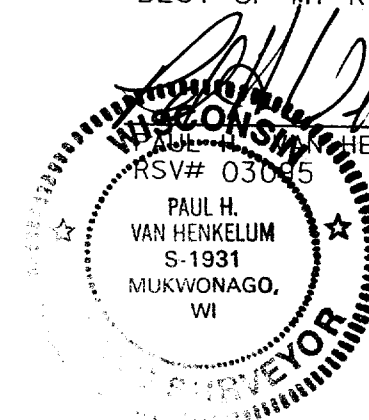

RSV
ENGINEERING, INC.

Engineers Land Surveyors Environmental Scientists
801 MAIN STREET, MUKWONAGO, WISCONSIN 53149 (262) 363-2004

ZOP-254 ZOP-255

007-2377

BR0105037 000087/000955 SITE REPORT.DGN 10/24/2005