



PREPARED FOR:
PRIMUS CORPORATION
c/o BILL McCARRON
226 BROAD STREET
LAKE GENEVA WI
53147

PLAT OF SURVEY

- OF -


LOT 85 OF STONE RIDGE SUBDIVISION, LOCATED IN THE
SOUTHWEST 1/4 AND THE SOUTHEAST 1/4 OF SECTION 24,
AND THE NORTHWEST 1/4 AND THE NORTHEAST 1/4 OF
SECTION 25, ALL IN TOWN 2 NORTH, RANGE 17 EAST,
CITY OF LAKE GENEVA, WALWORTH COUNTY, WISCONSIN.

PATHFINDER SURVEYING INC.
N3705 WILLOWBEND LANE
LAKE GENEVA, WI, 53147
262-248-3697

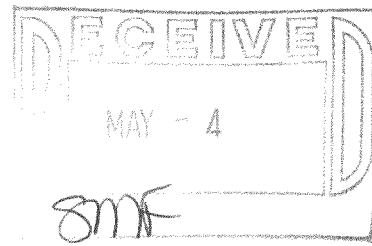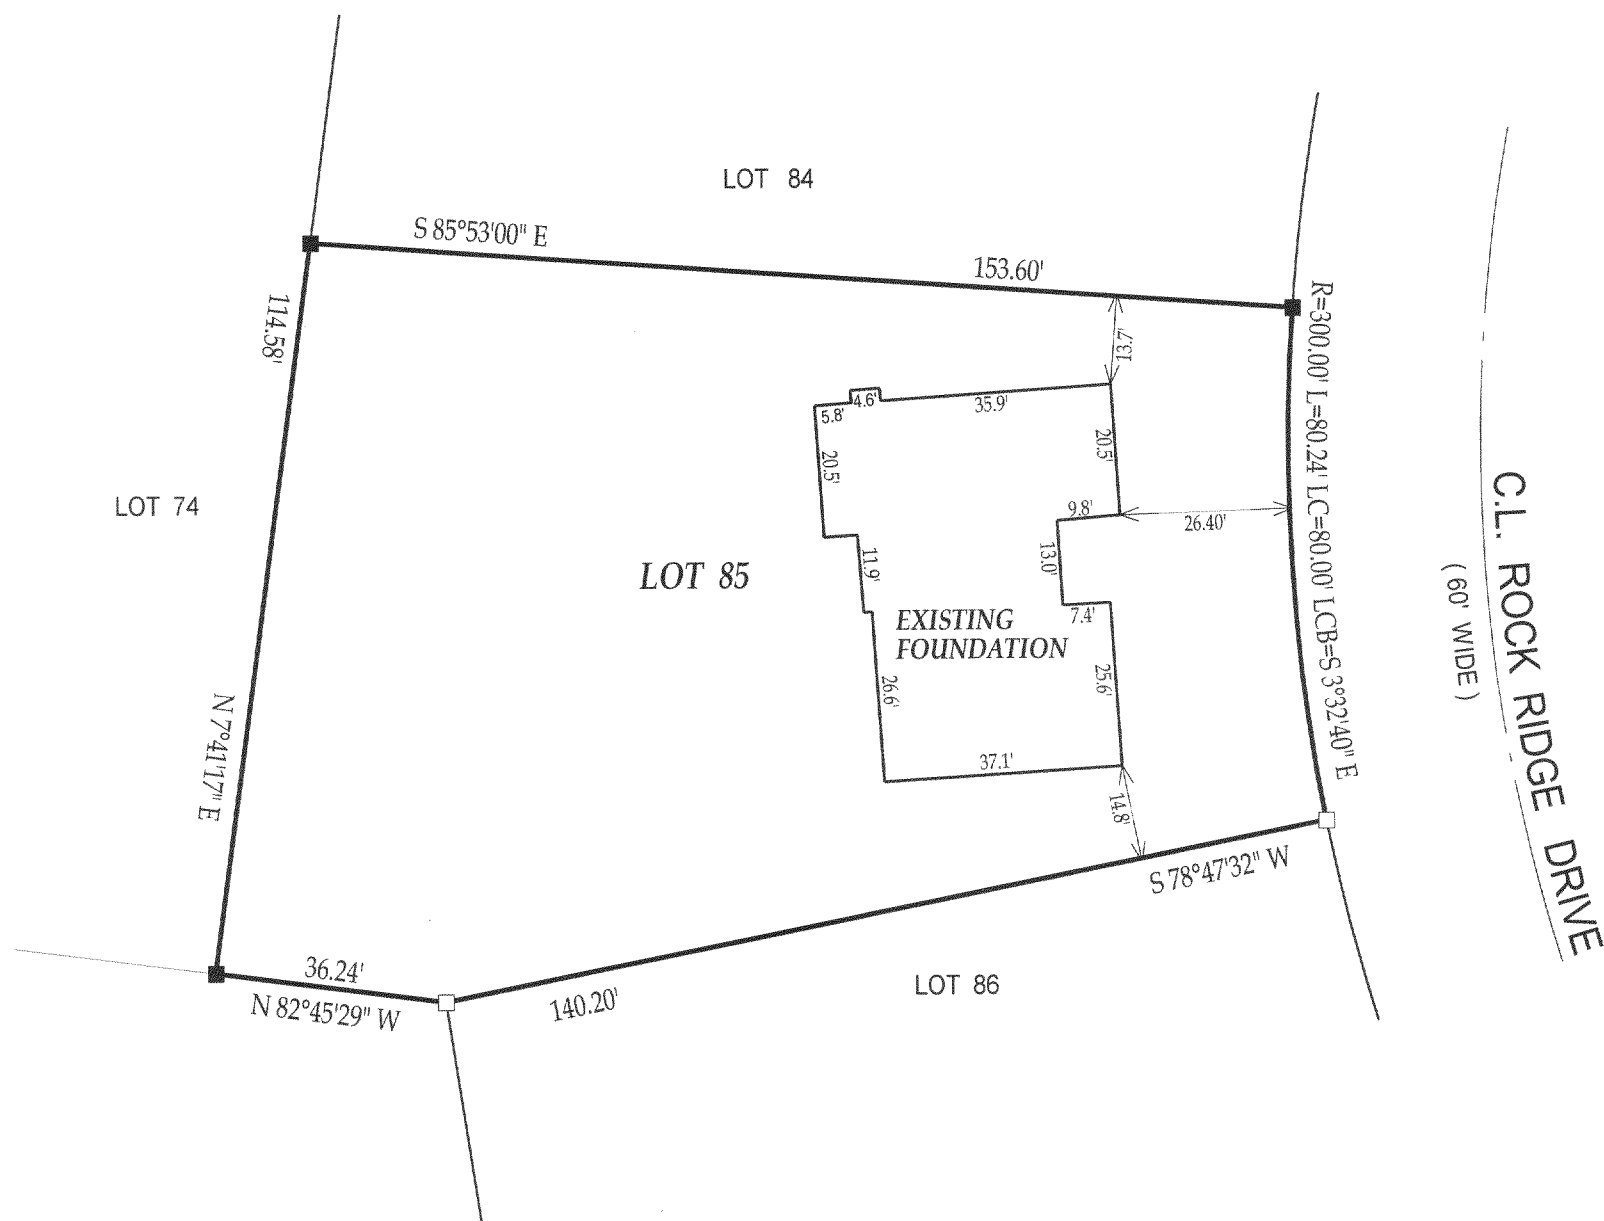

LEGEND

- () = recorded as
- = found iron bar
- = found iron pipe
- = set iron pipe
- = set iron bar

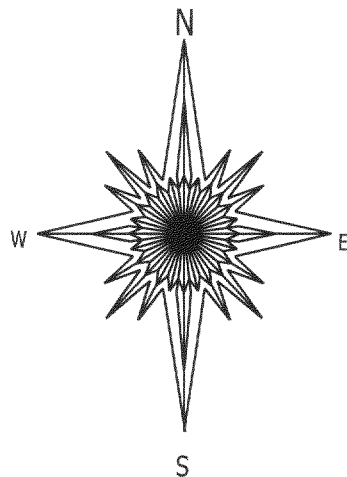

SCALE 1" = 30'

JOB # 05-631


TAX ID #

"I hereby certify that I have surveyed the above described property and that the above map is a true representation thereof and shows the size and location of all visible structures, apparent easements and encroachments if any."

This survey is made for the present owners of the property, and those who purchase, mortgage, or guarantee the title thereto, within one year from the date hereof.

DATED THIS 28th, DAY OF NOVEMBER, 2005

REVISED 1 / 06 / 2006, FOUNDATION ASBUILT

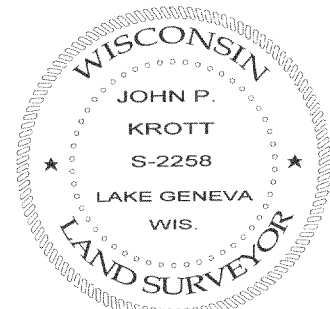

John P. Krott
JOHN KROTT S - 2258
Wisconsin Registered Land Surveyor
(original if signed in red)

ZSR-85

007-2396