


PREPARED FOR : BECKY GERBER GRENWALD
1709 FAIRVIEW DR.
LAKEGENEVA WI. 53147

PLAT OF SURVEY

- OF -

PATHFINDER SURVEYING INC.
N3705 WILLOW BEND LANE
LAKE GENEVA WI. 53147

LOT 8 IN TRACT ONE IN GENEVA BAY ESTATES, LOCATED IN THE NORTHWEST 1/4 OF SECTION 2,
TOWNSHIP 1 NORTH, RANGE 17 EAST, AND THE SOUTHWEST 1/4 OF THE SOUTHEAST 1/4 OF SECTION 35,
TOWNSHIP 2 NORTH, RANGE 17 EAST, CITY OF LAKE GENEVA; THE SOUTHEAST 1/4 OF THE SOUTHWEST
1/4 OF SECTION 35, TOWNSHIP 2 NORTH, RANGE 17 EAST, SAID LAND BEING IN THE CITY OF LAKE GENEVA
WALWORTH COUNTY, WISCONSIN.

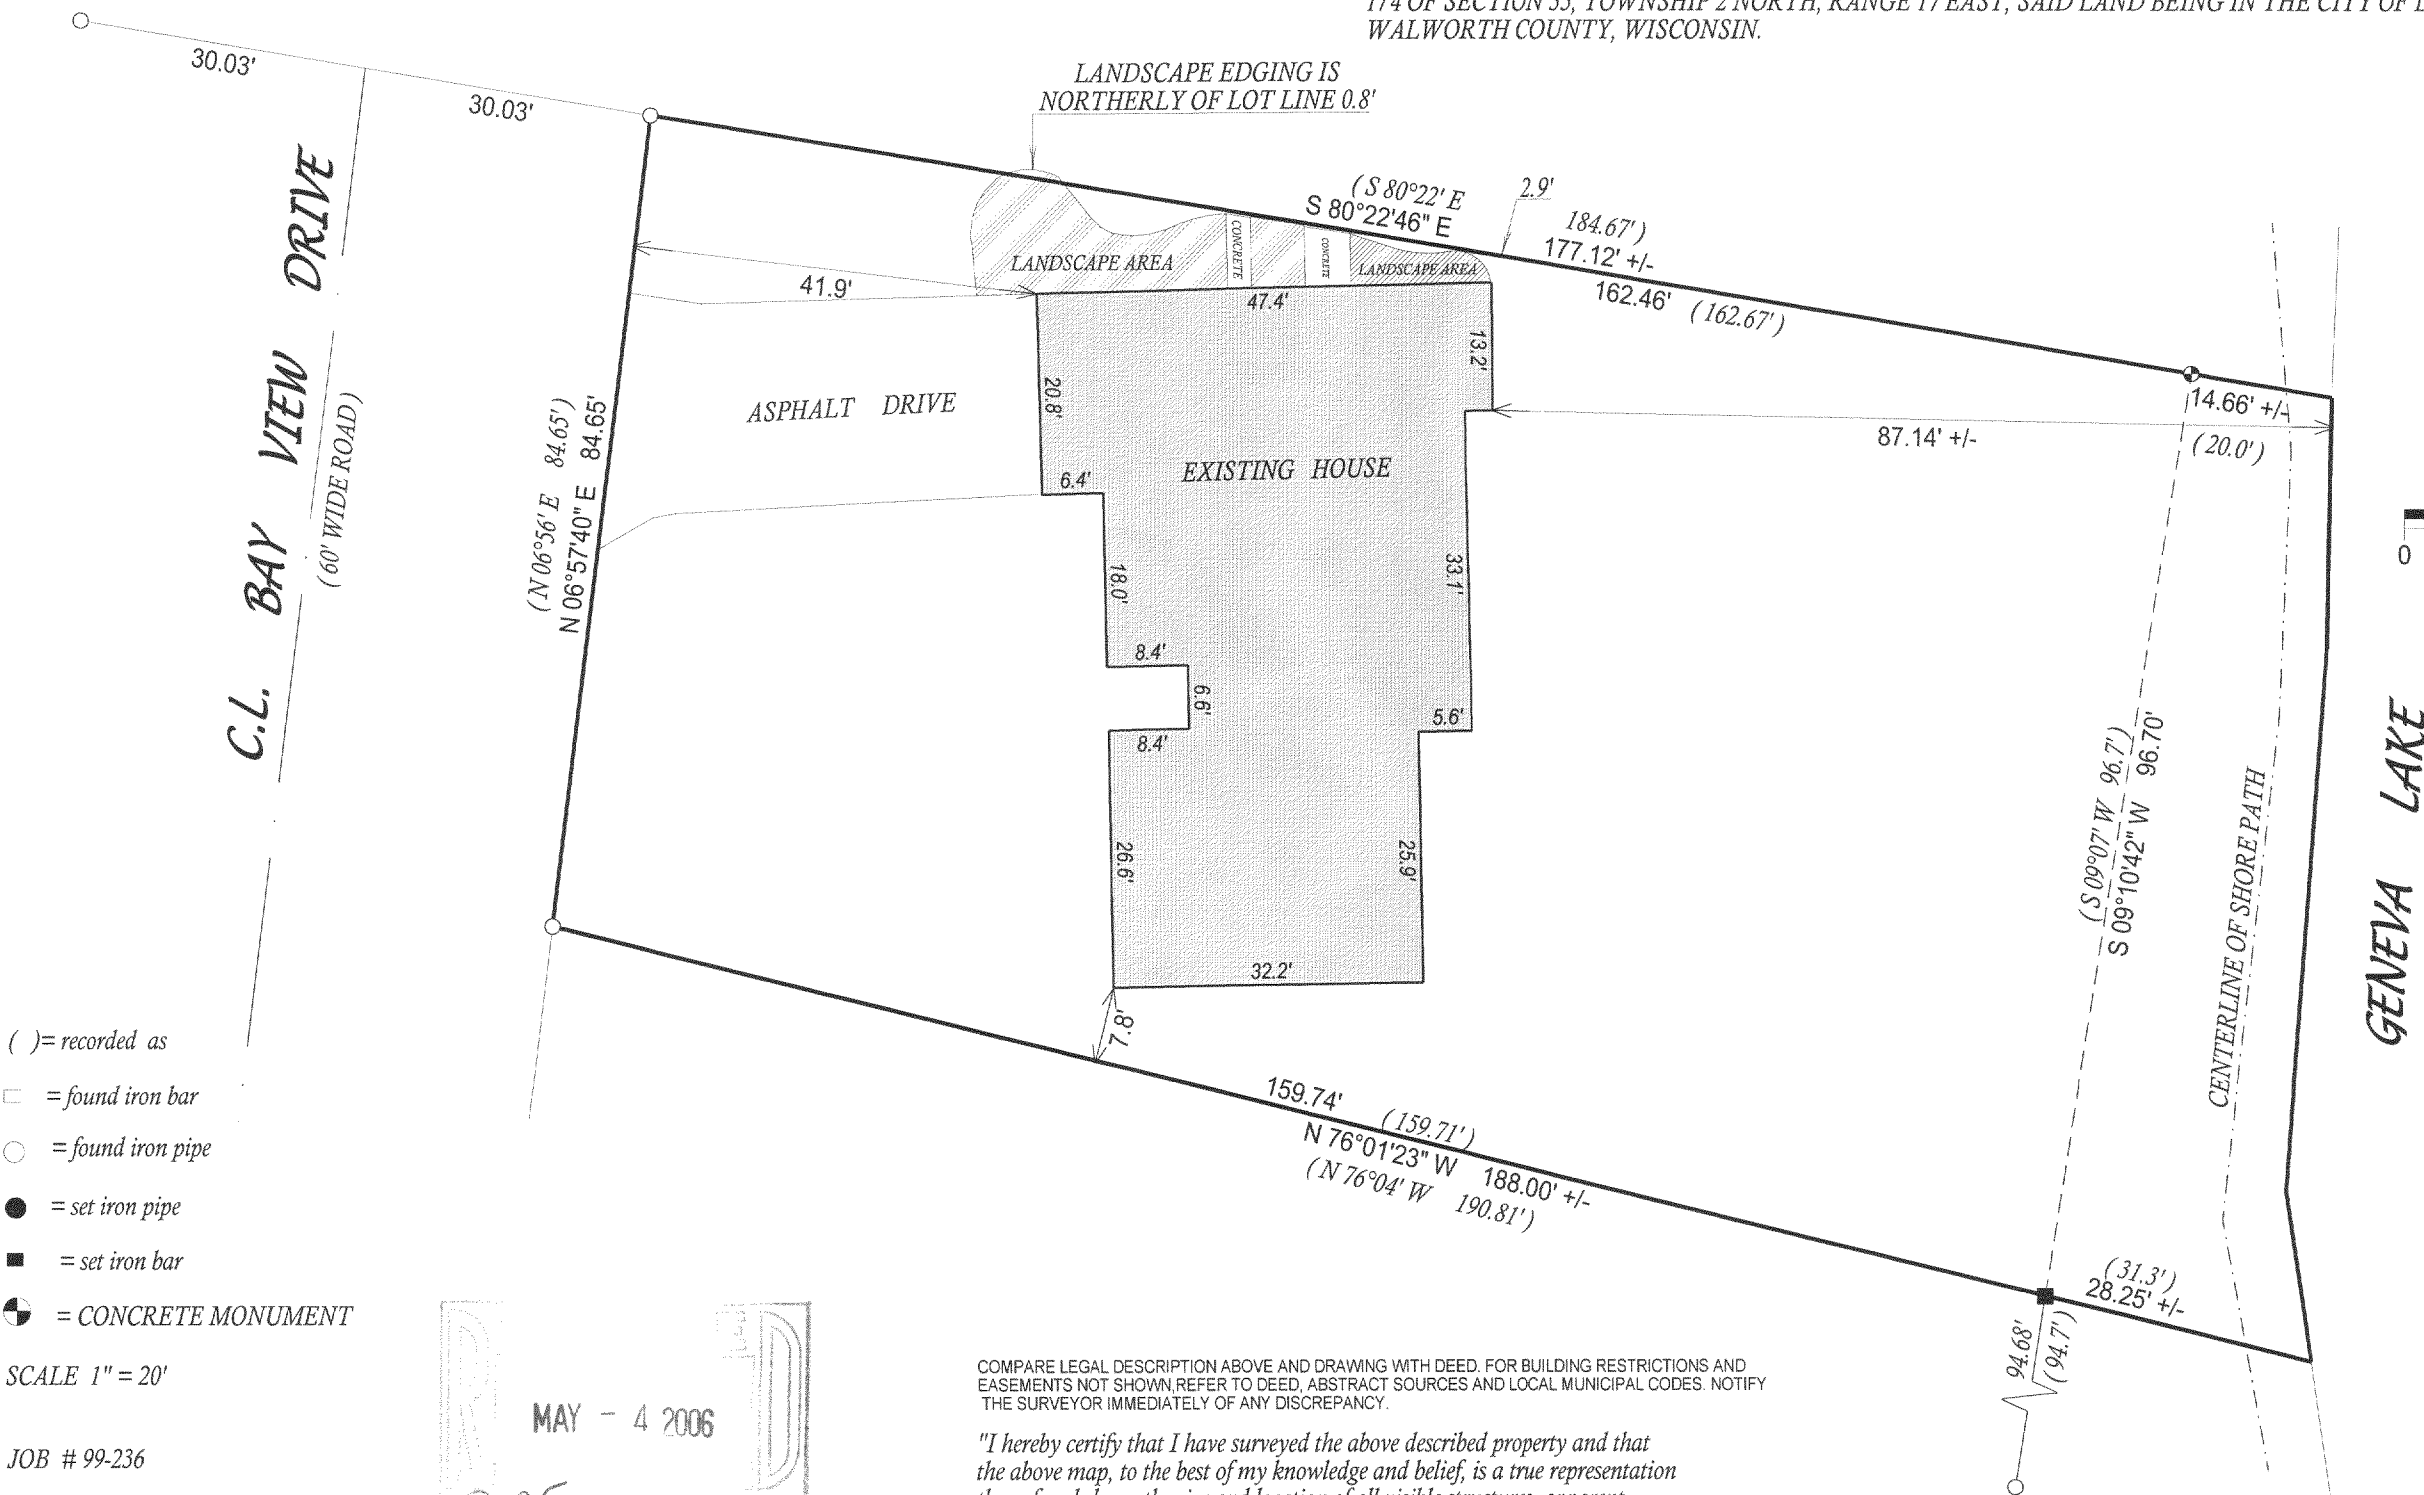

- () = recorded as
- = found iron bar
- = found iron pipe
- = set iron pipe
- = set iron bar
- ⊙ = CONCRETE MONUMENT

SCALE 1" = 20'


JOB # 99-236

TAX ID # ZGB00008

MAY - 4 2006
Zmf

COMPARE LEGAL DESCRIPTION ABOVE AND DRAWING WITH DEED. FOR BUILDING RESTRICTIONS AND EASEMENTS NOT SHOWN, REFER TO DEED, ABSTRACT SOURCES AND LOCAL MUNICIPAL CODES. NOTIFY THE SURVEYOR IMMEDIATELY OF ANY DISCREPANCY.

"I hereby certify that I have surveyed the above described property and that the above map, to the best of my knowledge and belief, is a true representation thereof and shows the size and location of all visible structures, apparent easements and encroachments if any."
This survey is made for the present owners of the property, and those who purchase, mortgage, or guarantee the title thereto, within one year from the date hereof.

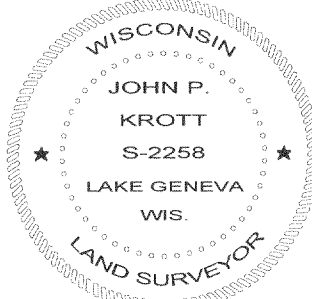

JOHN KROTT S - 2258
Wisconsin Registered Land Surveyor
(original if signed in red)

DATED THIS THE 4th DAY OF APRIL 2006.

ZGB-8

007- 2399