

14'02 #7 BLK. 1 Original Geneva

May 11-09

John Cleary

1 On line A-B find the 100, 300, marked
by 2 x 4 stake set by N. 10.33' E and
0.25' S of S. E corner of front
lot 410, 3426, 100' x 100'.

2 And 1/2 mile N. of Jones L. into Edge
Pt and 10' S. of the line set by former
survey. After 8' from these corners
the public boundary shall be in E. 1/2 Sec
1/2 of 1st Twp. 12 N. and 1' 1/2 and
then shall run to the fence of Edge Pt
7 1/2' S. of set corner of 1st.

3. Volume C-D obtained 8, on next
line from the line.

0453.7" is ctr of fence post

2710	Head of Cement Mark
------	---------------------


1-66.9	Redwood			
--------	---------	--	--	--

071 R. G. L. Assoc on Lot " 6

1+70 put 2 pipe static 1 ft from
wash for 20 min.

2730 put in 2

val. for lot in vicinity of 1/2
Mun. building - lot.

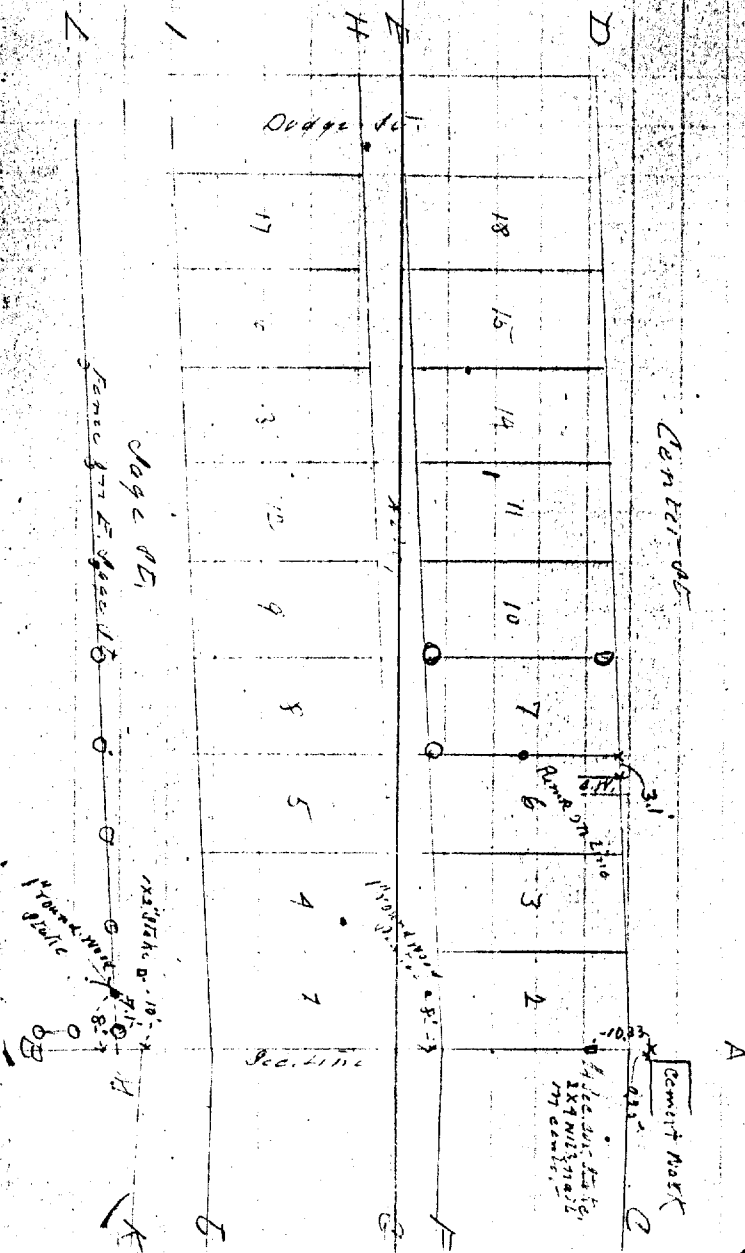

45

4 On line F-E charmed S on all
line of Old fence.

1+105 is N edge of Barn on lot #6.

1+120 put 1" pine stake for lot line
on E edge of 5" cedar fence post .15' N

of center of barn.

2+36 put 1" round stake on E edge of
5" cedar fence post .20' N of also of same.

On line of lot #7 put stake
for line and end of line on
front well to be on lot line.

46