


PLAT OF SURVEY

7006

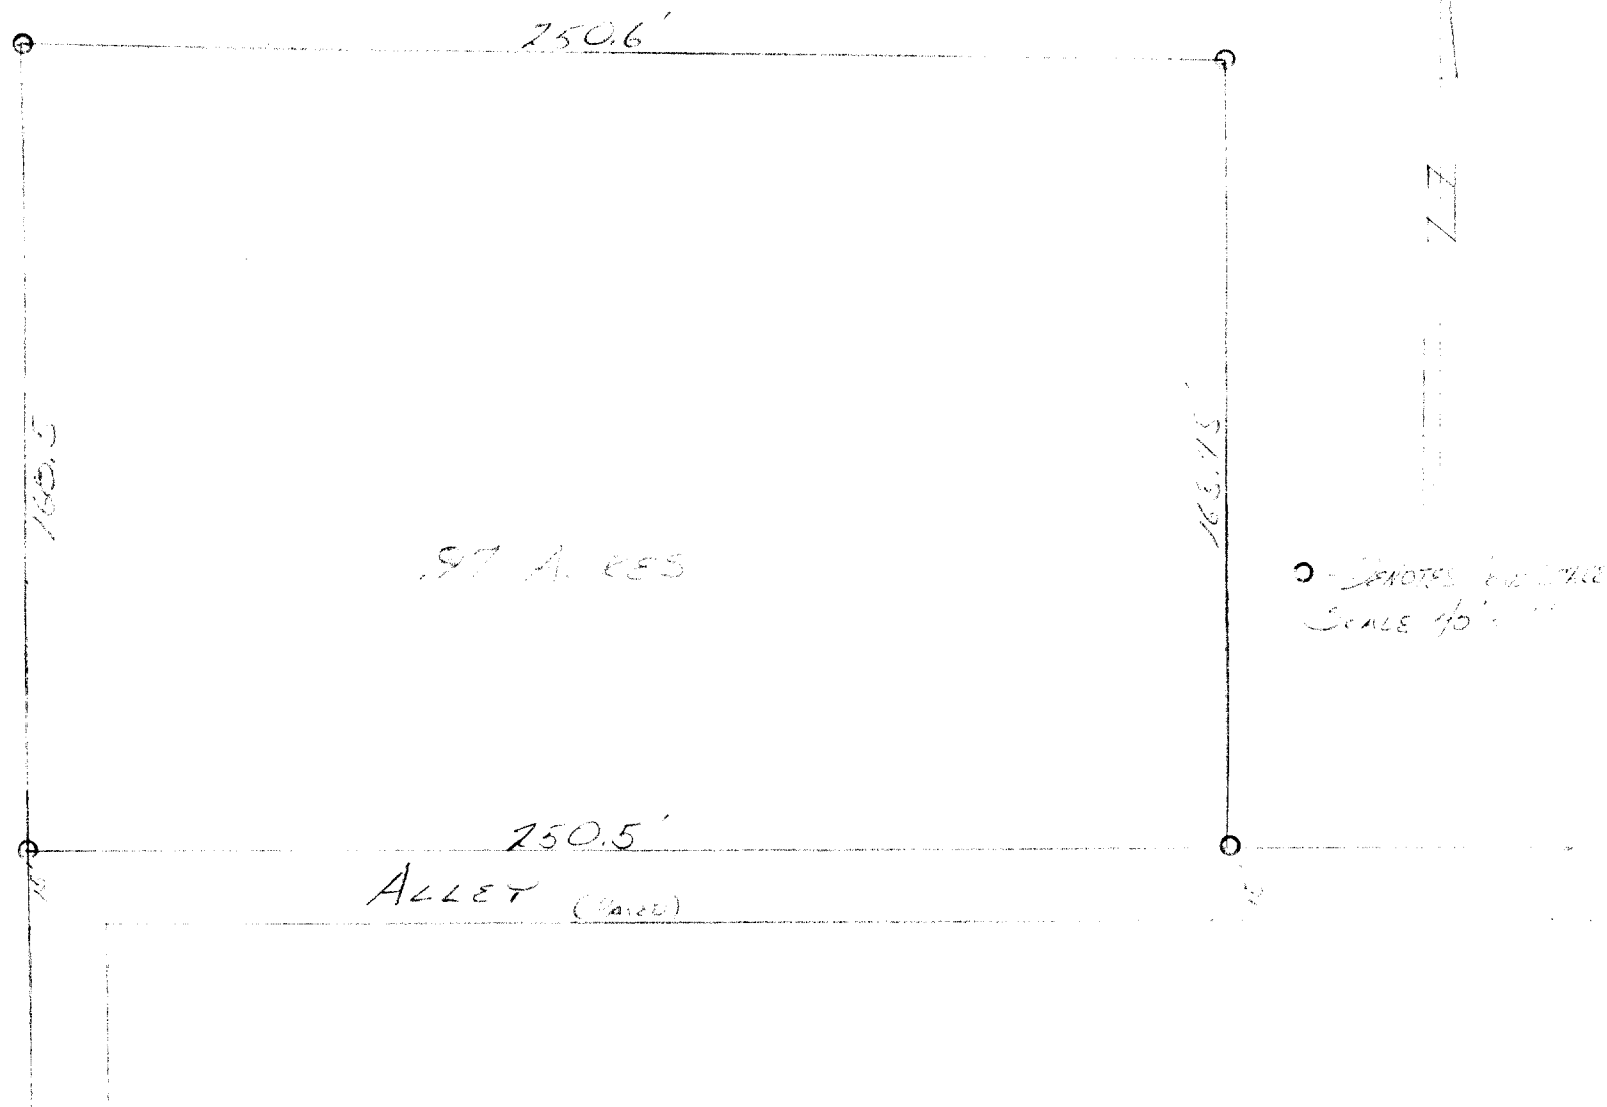

DESCRIPTION: The West $\frac{1}{2}$ of Lot 11 in Columbian Second Subdivision in the City of Lake Geneva, Walworth County, Wisconsin.

CERTIFICATE: I hereby certify that I have on this the 19th day of July 1956 surveyed the above described property and that no encroachments exist.

SIGNED AND SEALED ON THIS THE 20TH DAY OF JULY, 1956

James F. Bings
Reg. Land Surveyor 272