


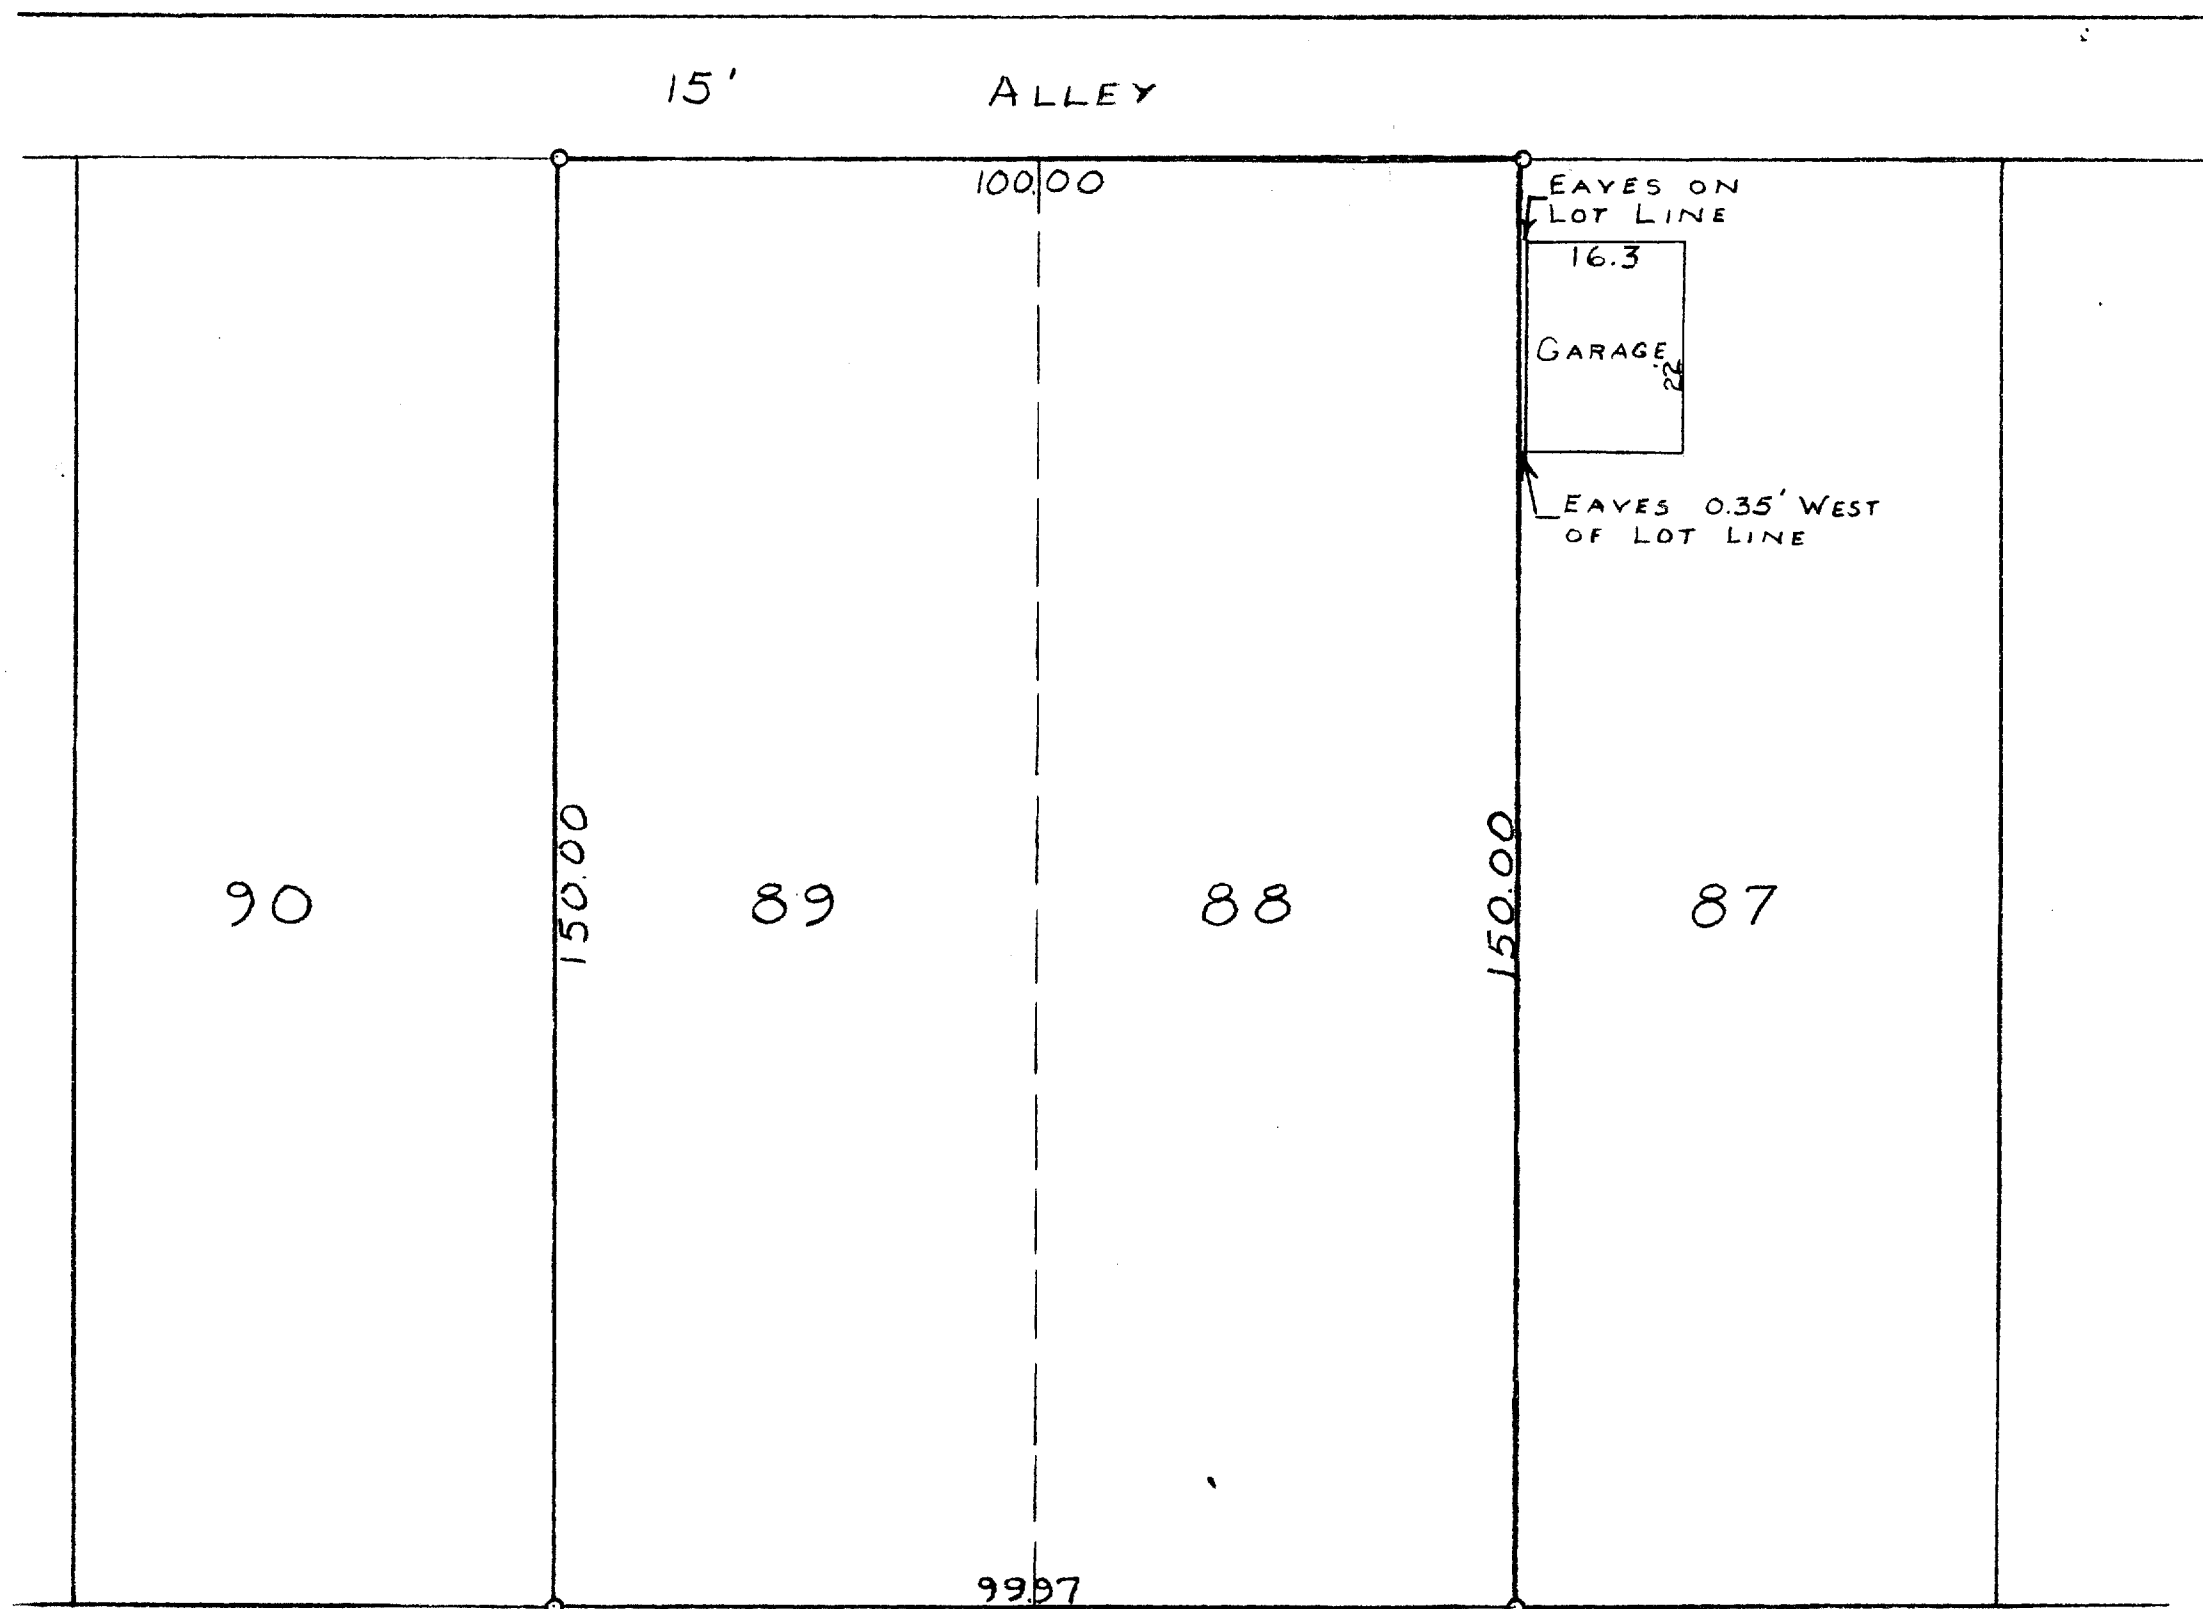

N

SCALE - 1" = 20'

0 = IRON PIPE

PARK

Row

PLAT OF SURVEY OF LOTS 88 AND 89 OF COLUMBIAN SUBDIVISION
 LOCATED IN THE CITY OF LAKE GENEVA, WALWORTH COUNTY,
 WISCONSIN.
 MARCH 10, 1955

George T. Dunham
 GEORGE T. DUNHAM, SURVEYOR
 DELAVAN, WISCONSIN

CL-746

7-24