

PREPARED FOR:
COLDWELL BANKERS PRIMUS
c/o LINDA TRESTER
226 BROAD STREET
LAKE GENEVA WI
53147

PLAT OF SURVEY

LOT 19 EXCEPTING THE SOUTH 10 FEET OF LOT 19 PEARSON'S SUBDIVISION
IN THE CITY OF LAKE GENEVA, WALWORTH COUNTY, WISCONSIN.

PATHFINDER SURVEYING INC.
W2888 KRUEGER RD. UNIT "D"
LAKE GENEVA WI. 53147
(262) 248-3697

LOT 8

FENCE CORNER
IS 0.8' EAST OF LINE.


(S 88°09'00" E 117.06')
S 88°06'15" E 117.30'

LOT 20

SHED
10.1'
8.2'

OVERHANG

(N 00°00'00" W 70.00')
N 00°00'00" W 69.88'

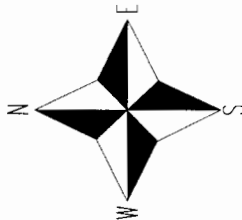

- () = recorded as
- = found iron bar
- = found iron pipe
- = set iron pipe
- = set iron bar

SCALE 1" = 20'

JOB # 06-261

TAX KEY # ZP00019


C.L. PEARSON DRIVE

(50' WIDE ROAD)

S 00°00'21" W 70.35'
(S 00°00'00" W 70.00')

JUL 28 2006

JMK

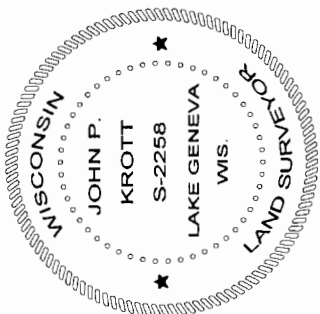

John P. Krott

JOHN KROTT S - 2258
Wisconsin Registered Land Surveyor
(original if signed in red)

DATED THIS THE 31st DAY OF MAY 2006.

LOT 18

N 87°52'27" W 117.13'
(N 88°09'00" W 117.06')

LOT 19

LOT 10

COMPARE LEGAL DESCRIPTION ABOVE AND DRAWING WITH DEED. FOR BUILDING RESTRICTIONS AND EASEMENTS NOT SHOWN REFER TO DEED, ABSTRACT SOURCES AND LOCAL MUNICIPAL CODES. NOTIFY THE SURVEYOR IMMEDIATELY OF ANY DISCREPANCY.

"I hereby certify that I have surveyed the above described property and that the above map, to the best of my knowledge and belief, is a true representation thereof and shows the size and location of all visible structures, apparent easements and encroachments if any."

This survey is made for the present owners of the property, and those who purchase, mortgage, or guarantee the title thereto, within one year from the date hereof.

007-2450