




PREPARED FOR
 RE/MAX GENEVA REALTY, LTD
 C/O SHERRY ENGLISH
 101 BROAD ST. SUITE 102
 LAKE GENEVA WI. 53147

PLAT OF SURVEY

- OF -

LOT 9 OF BADGER SUBDIVISION, LOCATED IN THE
 SOUTHWEST 1/4 OF THE NORTHWEST 1/4 OF
 SECTION 6, TOWN 1 NORTH, RANGE 18 EAST, CITY
 OF LAKE GENEVA, WALWORTH COUNTY, WISCONSIN.

PATHFINDER SURVEYING INC.
 W2888 KRUEGER RD. UNIT "D"
 LAKE GENEVA WI. 53147
 (262) 248-3697

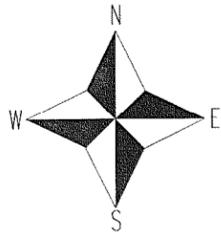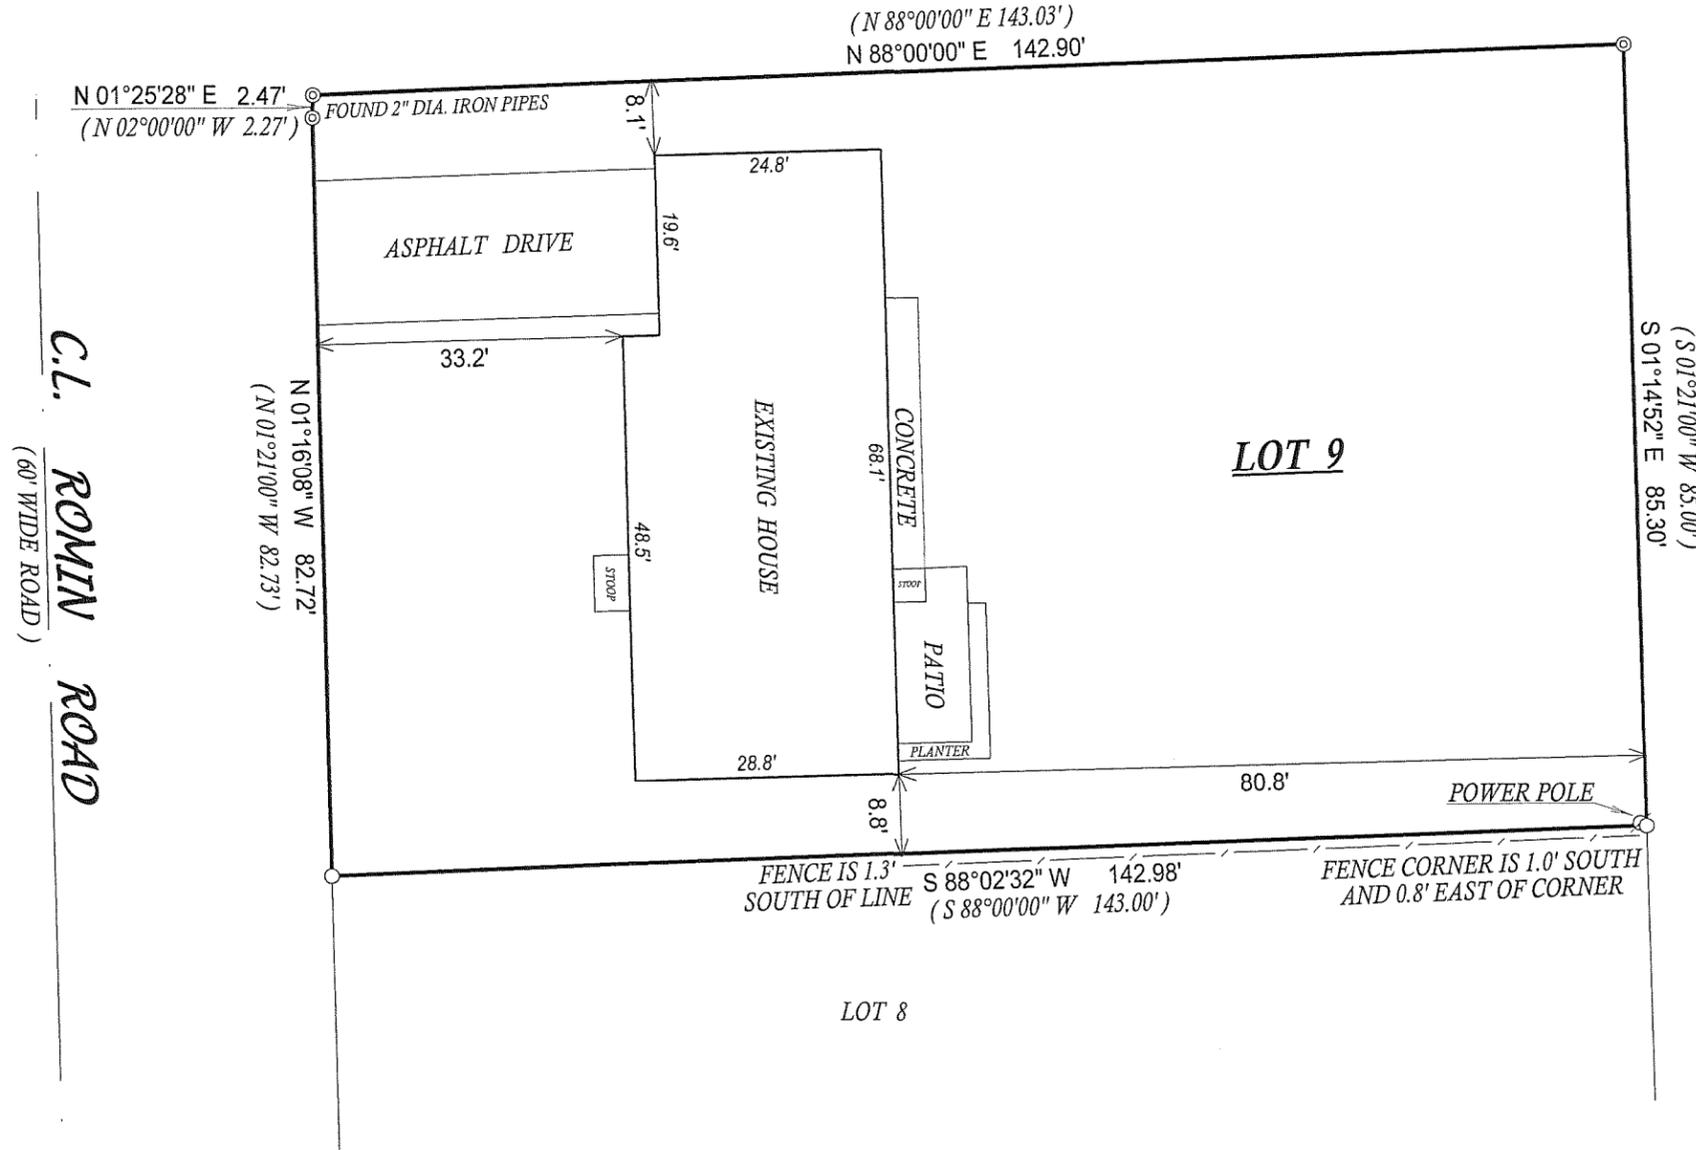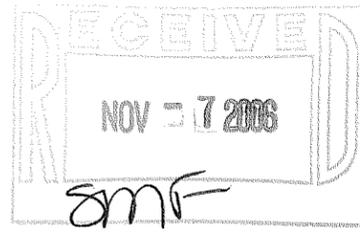

- () = recorded as
- = found iron bar
- = found iron pipe
- = set iron pipe
- = set iron bar

SCALE 1" = 20'

JOB # 06-404

TAX ID # ZB00009

COMPARE LEGAL DESCRIPTION ABOVE AND DRAWING WITH DEED. FOR BUILDING RESTRICTIONS AND EASEMENTS NOT SHOWN, REFER TO DEED, ABSTRACT SOURCES AND LOCAL MUNICIPAL CODES. NOTIFY THE SURVEYOR IMMEDIATELY OF ANY DISCREPANCY.

"I hereby certify that I have surveyed the above described property and that the above map, to the best of my knowledge and belief, is a true representation thereof and shows the size and location of all visible structures, apparent easements and encroachments if any."

This survey is made for the present owners of the property, and those who purchase, mortgage, or guarantee the title thereto, within one year from the date hereof.



John P. Krott

JOHN KROTT S - 2258
 Wisconsin Registered Land Surveyor
 (original if signed in red)

DATED THIS THE 10th DAY OF AUGUST 2006.

007-2479