

ROGERS


COURT

STREET

CENTER

N

SCALE-1"=20'
0=IRON PIPE

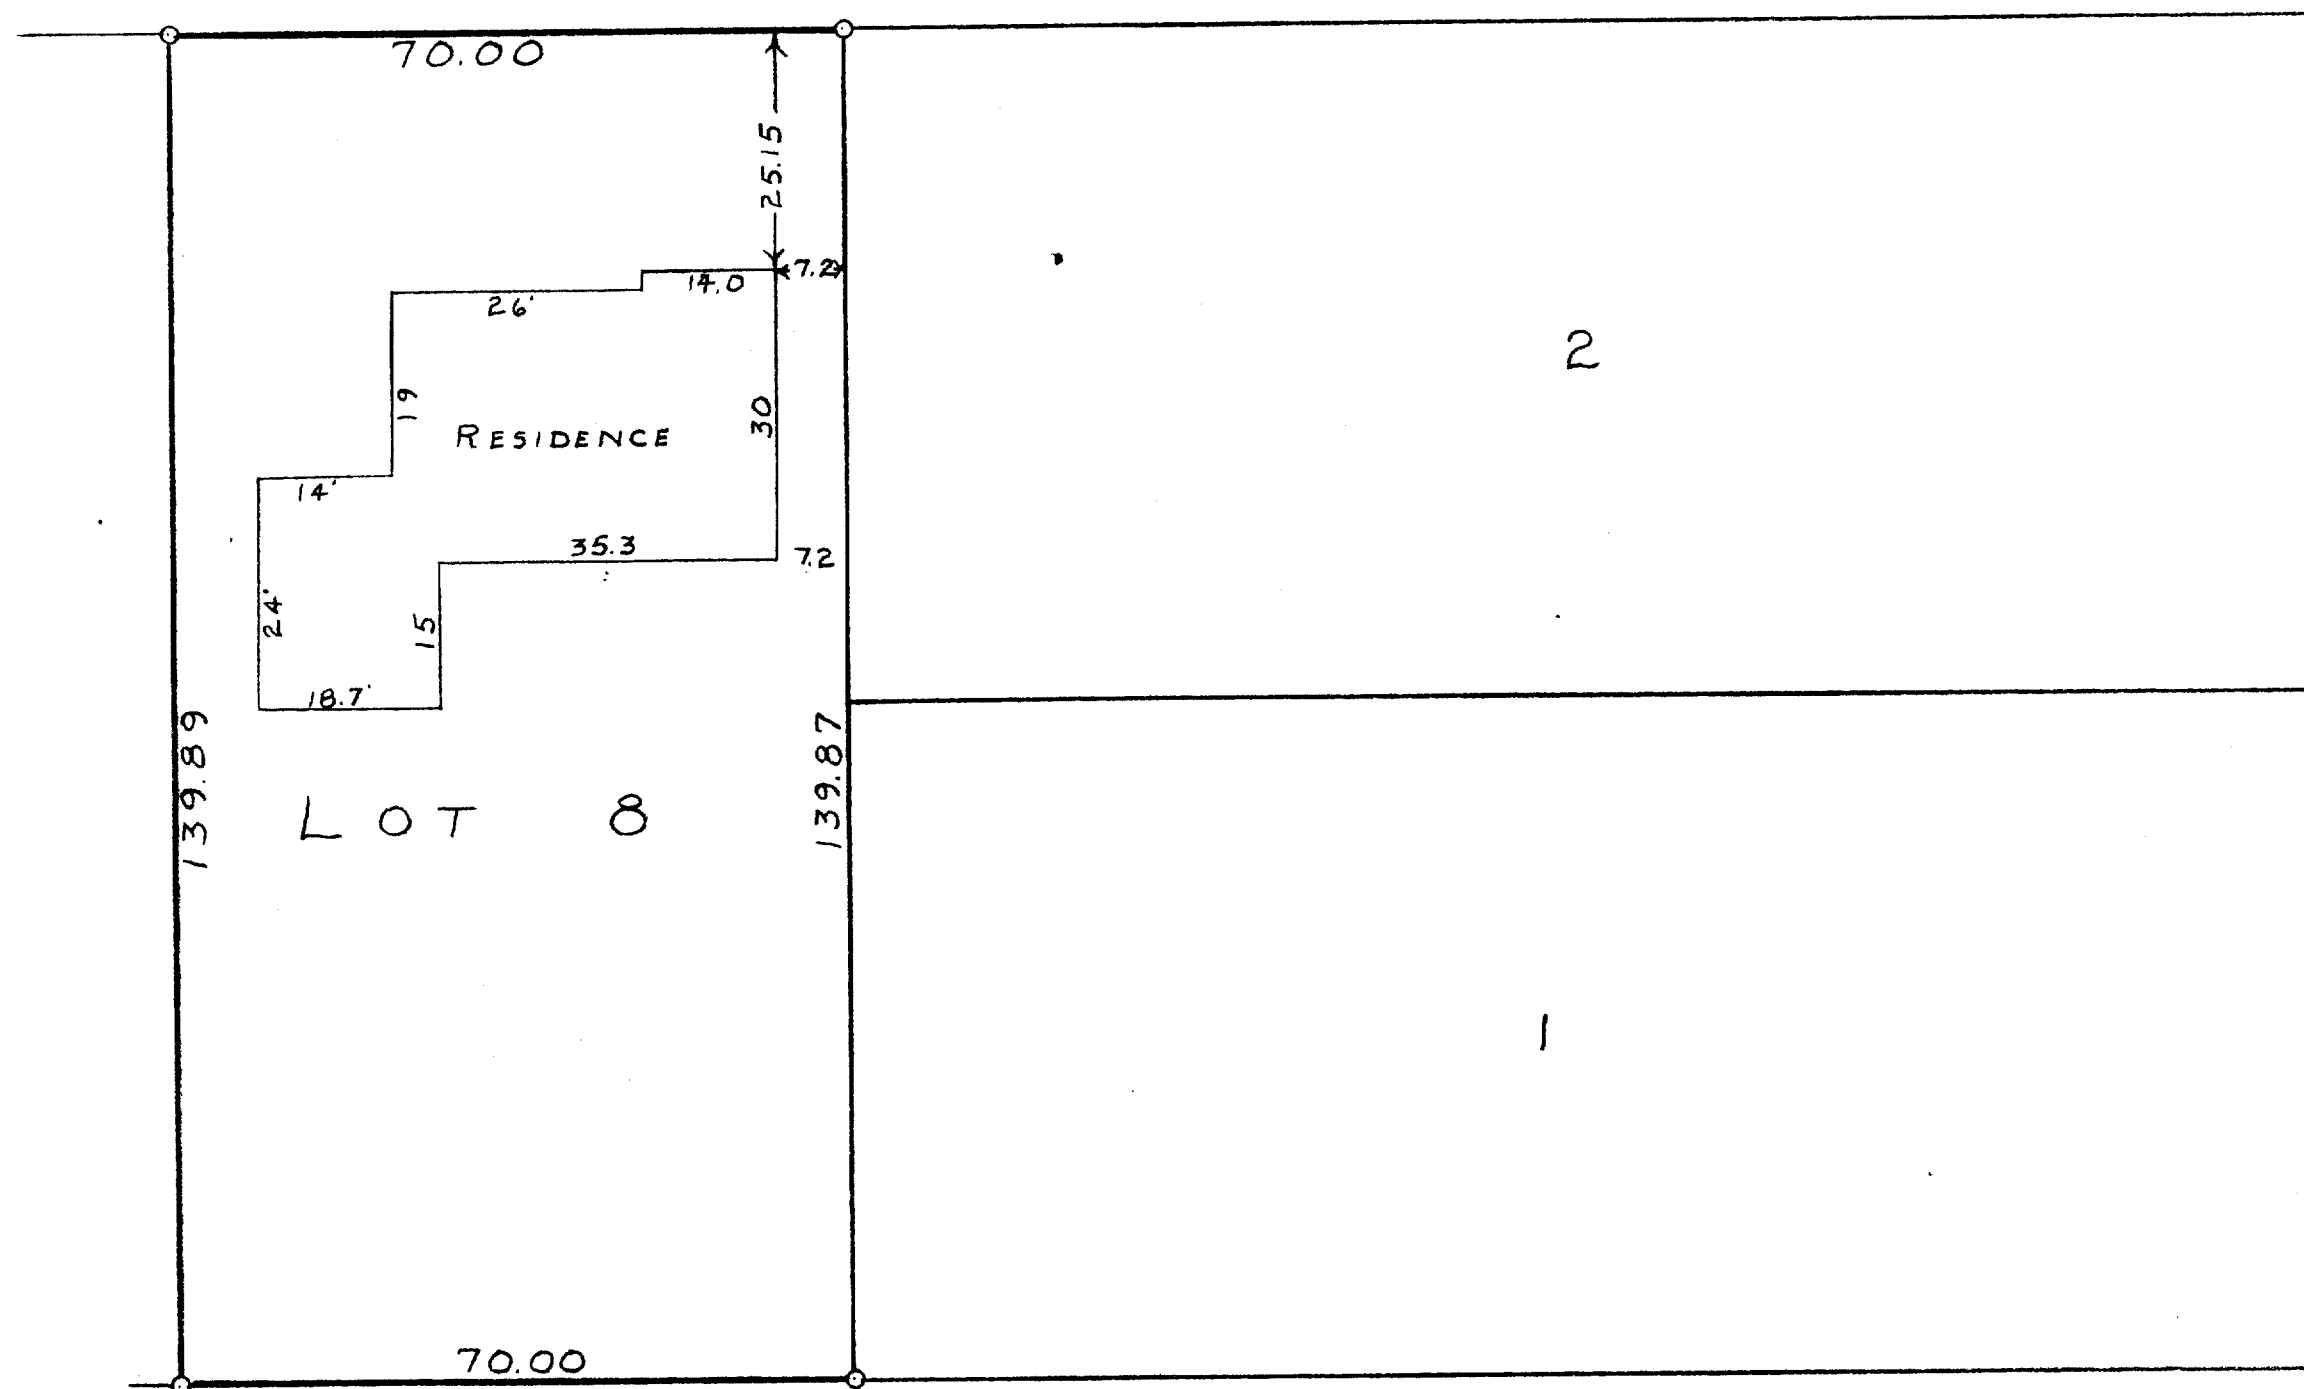

STATE OF WISCONSIN)
COUNTY OF WALWORTH)

I, GEORGE T. DUNHAM, DO HEREBY CERTIFY THAT I HAVE SURVEYED THE
PROPERTY, DESCRIBED AS FOLLOWS:

LOT 8, KOHN'S 2ND SUBDIVISION LOCATED IN THE CITY OF LAKE
GENEVA, WALWORTH COUNTY, WISCONSIN.

AND THAT THE PLAT SHOWN ABOVE IS A CORRECT REPRESENTATION OF THE
PROPERTY LINES.
APRIL 19, 1955

George T. Dunham
GEORGE T. DUNHAM, SURVEYOR
DELAVER, WISCONSIN

7-25

ZK26