


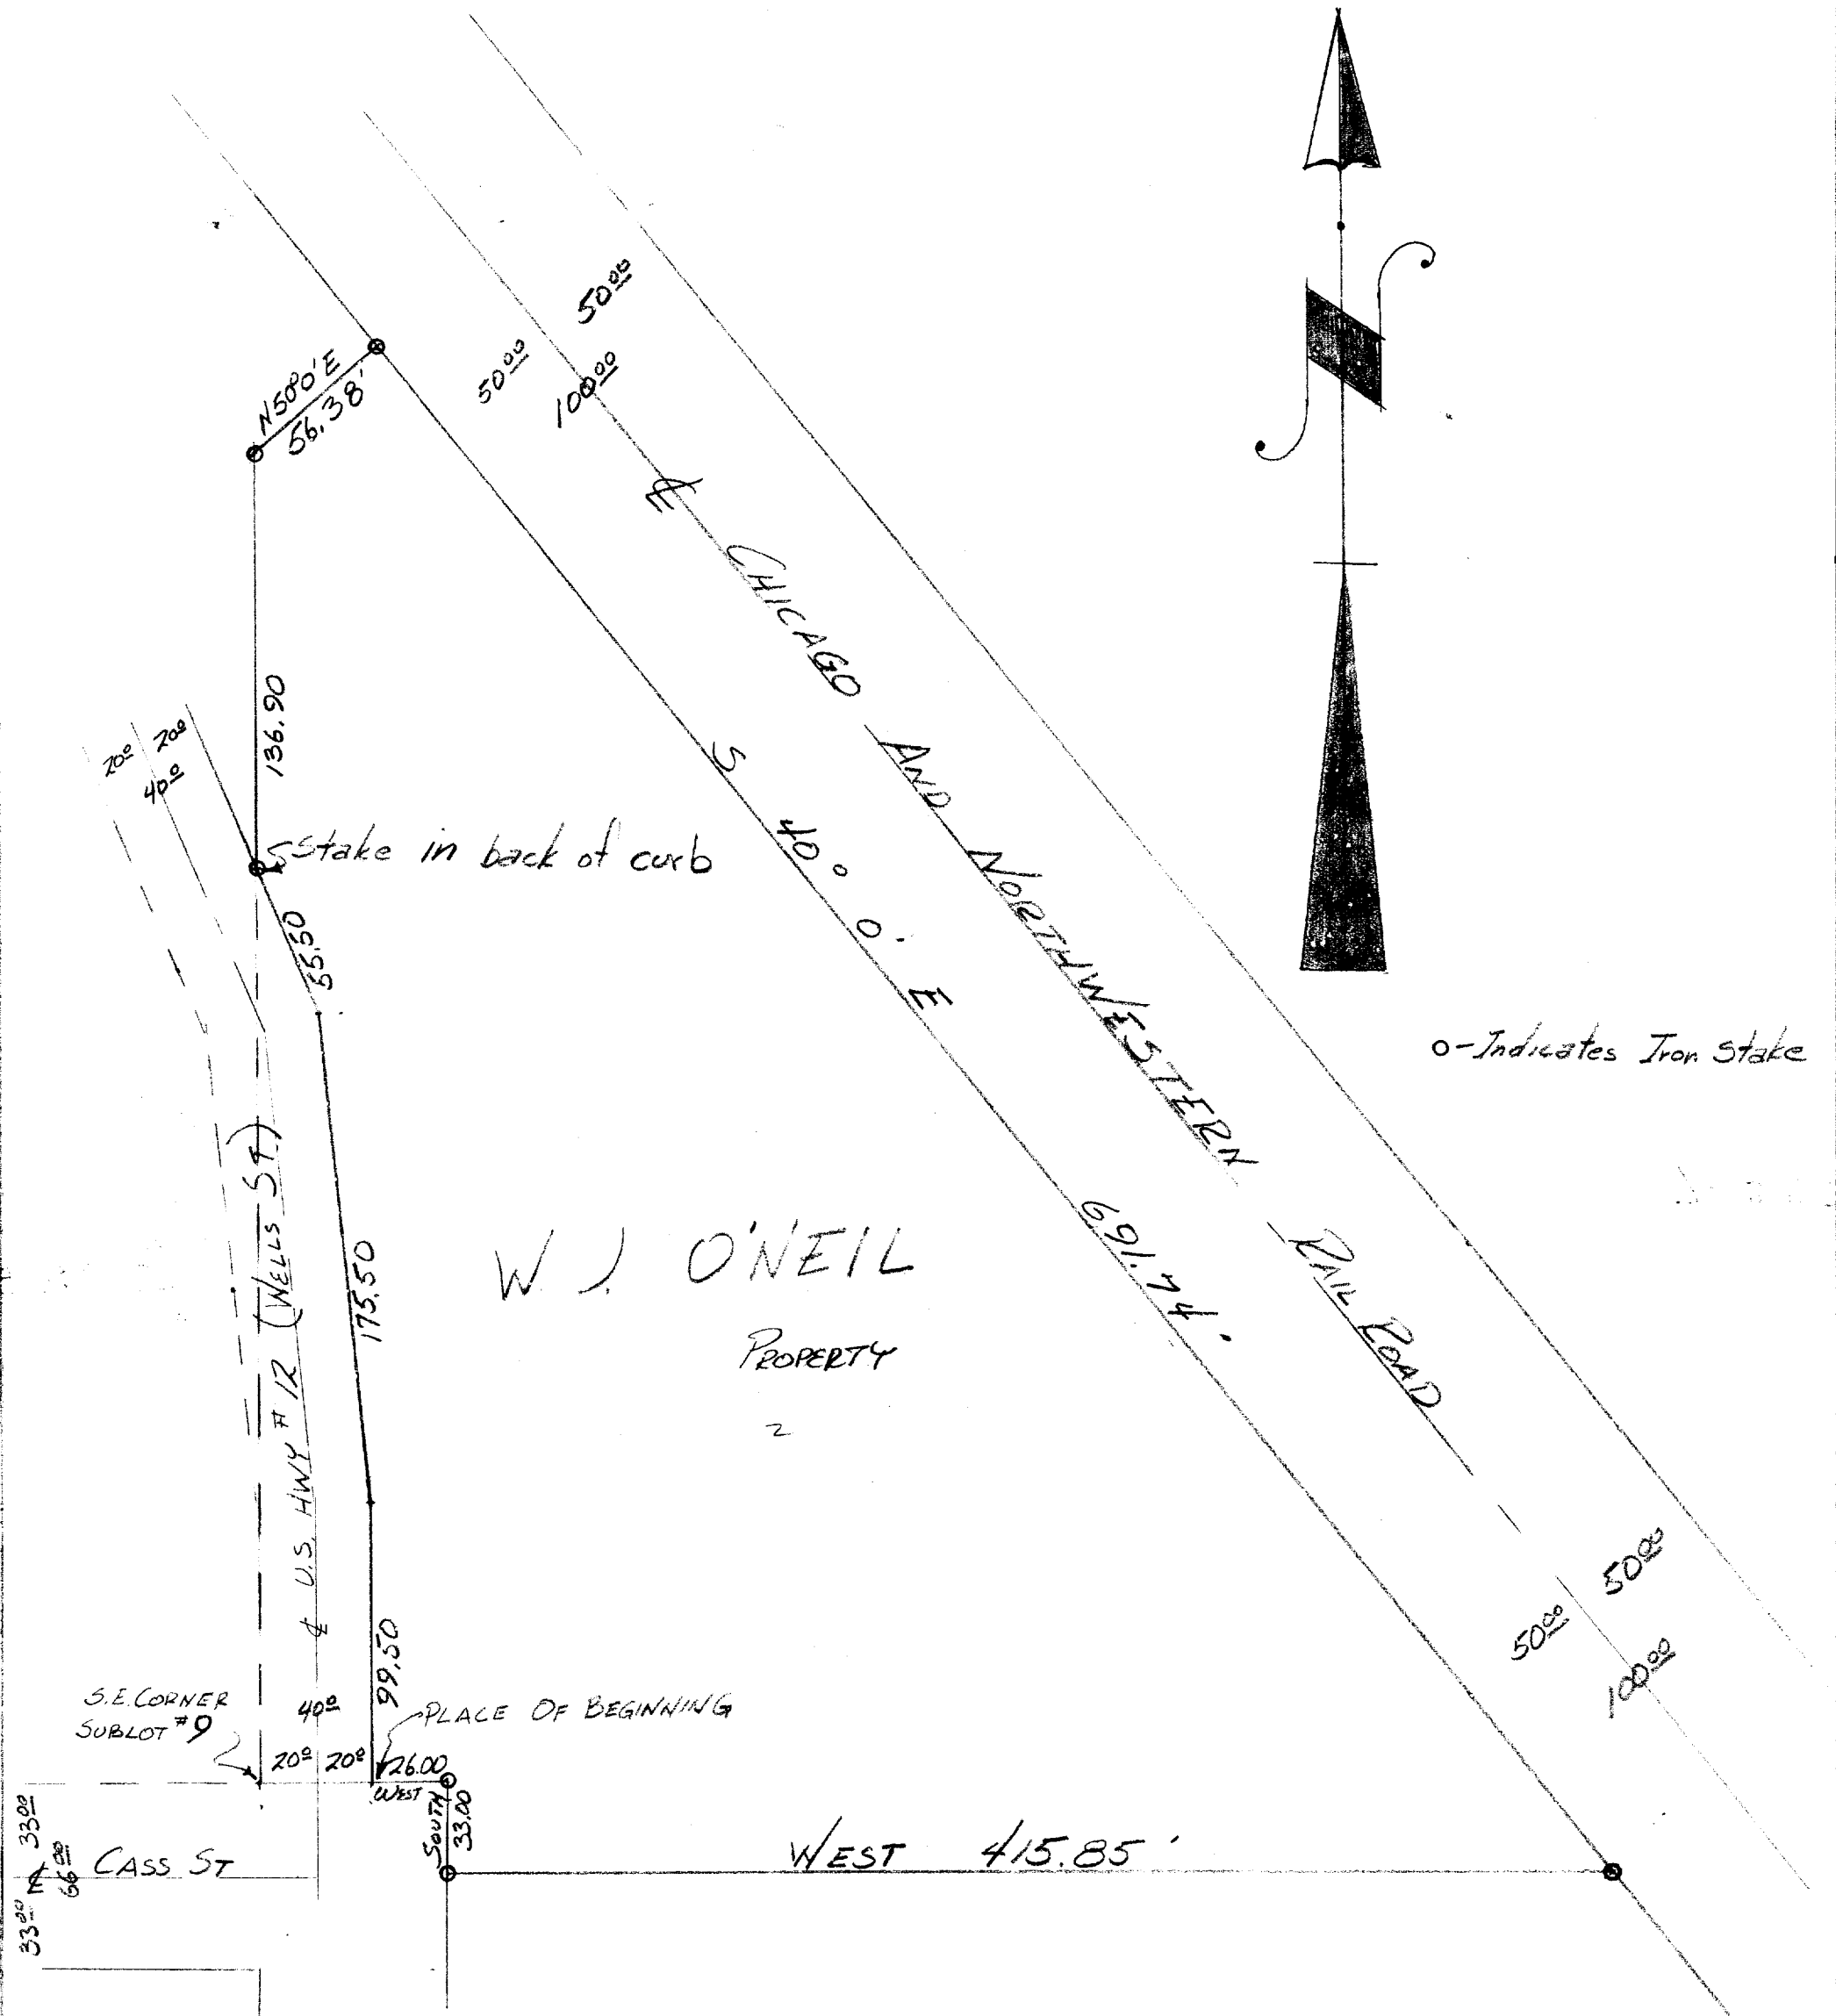

DESCRIPTION: Commencing at a point in the North line of Cass Street that is 26.00 feet West of the East end of said street as established by the original plat of the City of Lake Geneva, Walworth County, Wisconsin; thence North 99.50 feet to a point, thence Northwesterly along the arc of a 8.52° curve 175.50 feet to a point, thence Northwesterly along a 6.88° curve 55.50 feet to an iron stake, thence North 136.90 feet to an iron stake, thence N. $50^\circ 0' E$. 56.38 feet to an iron stake on the Westerly line of the Chicago and Northwestern Railroad right of way, thence S $40^\circ 0' E$ 691.74 feet to an iron stake in the Westerly line of said right of way, thence West 415.85 feet to an iron stake at the East end of the center line of Cass Street, thence North 33.00 feet to an iron stake in the East end of the North line of Cass Street, thence West along the North line of Cass Street 26.00 feet to the place of beginning, containing 3.03 acres more or less.

CERTIFICATE: I hereby certify that I have on this 15th day of November, surveyed the above described property, and that the measurements and bearings of the boundary lines coincide with the measurements and bearings shown on the drawing.

SIGNED AND SEALED 15 NOVEMBER, 1958

