

DEGEN - FOAT SURVEYING, INC.

071033
071033S1.DWG


100 SOUTH SECOND STREET
WATERFORD, WISCONSIN 53185
(262)534-5404 (FAX)534-2022

PLAT OF SURVEY

THE NORTH 52 FEET OF LOT 12 IN BLOCK 9 OF THE ORIGINAL PLAT OF THE CITY OF LAKE GENEVA, ACCORDING TO THE RECORDED PLAT THEREOF, WALWORTH COUNTY, WISCONSIN.

* REFER TO A CURRENT TITLE REPORT FOR EASEMENTS, RESTRICTIONS OR COVENANTS OF RECORD THAT MAY AFFECT THIS LAND. *



SURVEY PREPARED FOR: ADVANTAGE TITLE
P.O. BOX 217
320 E. MAIN STREET
TWIN LAKES, WI 53181

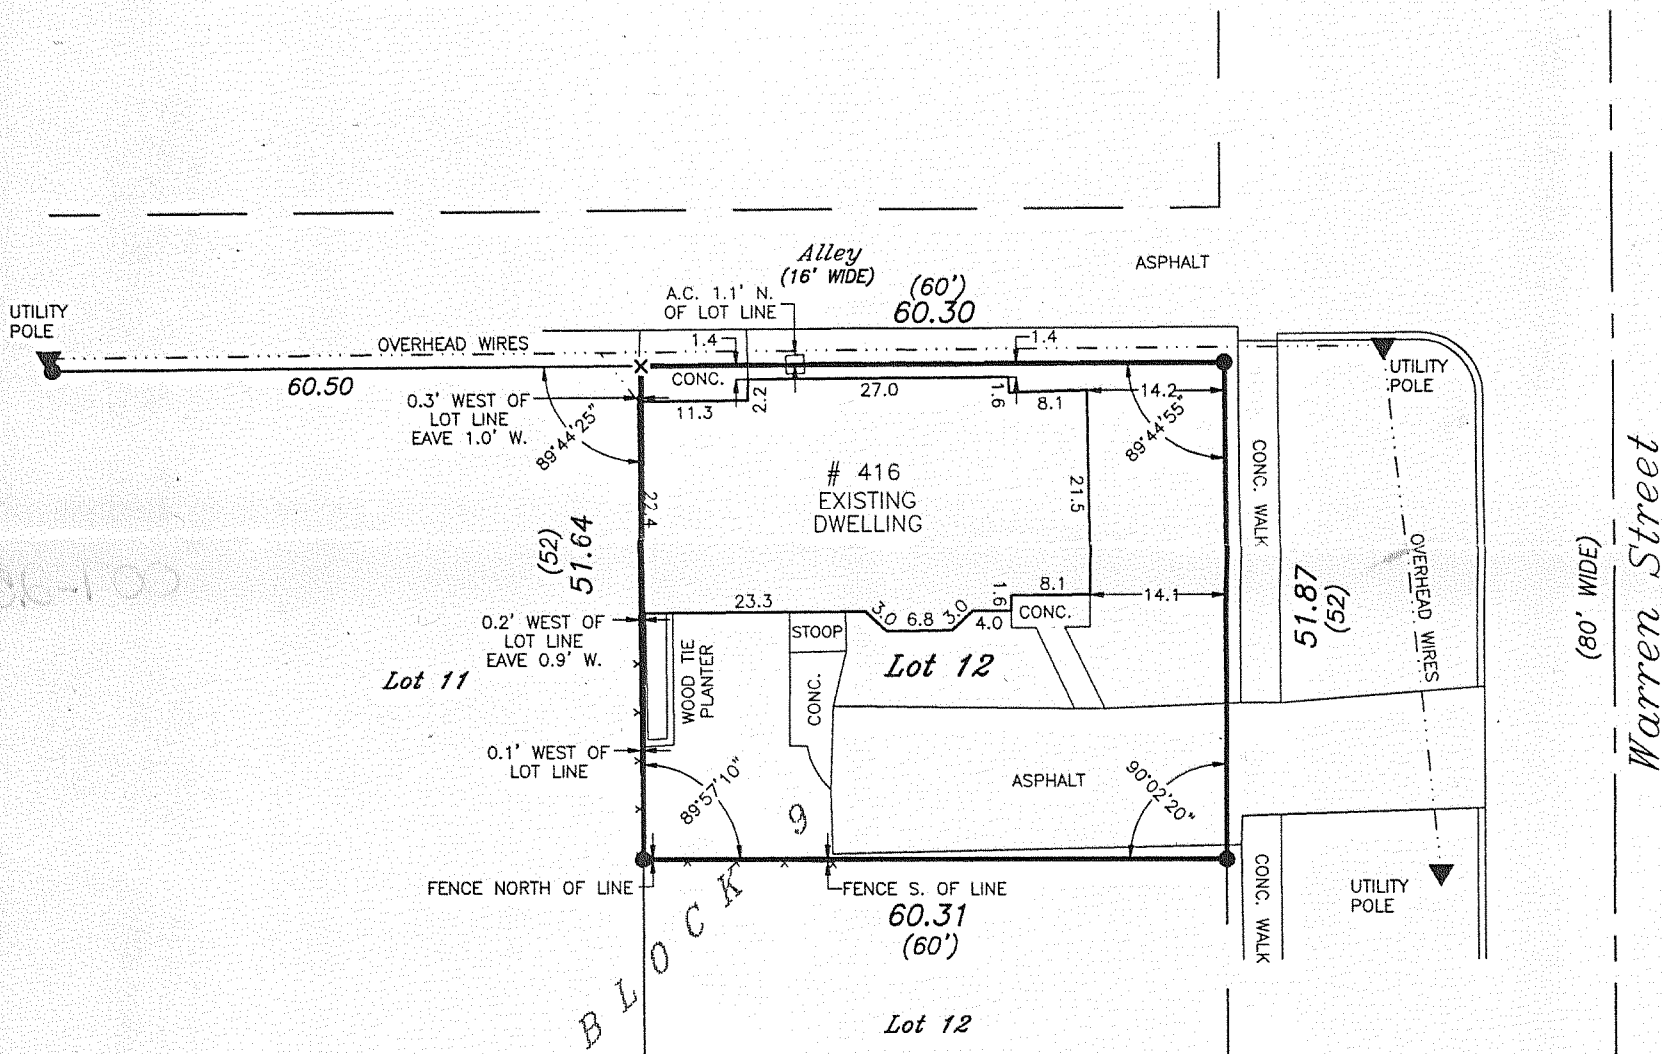

SCALE: 1" = 20'

LEGEND

- - FOUND IRON PIPE
- x - CUT CROSS IN CONC.
- - - FENCE
- () - RECORDED AS

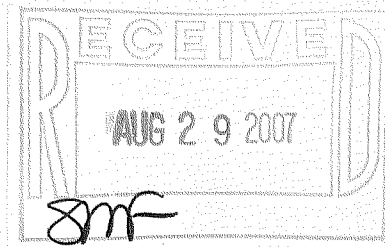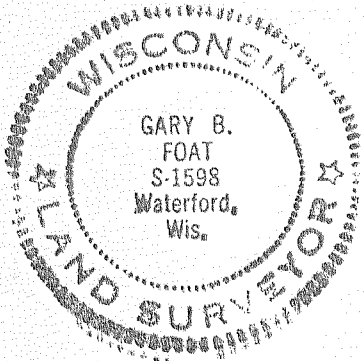

I HEREBY CERTIFY THAT I HAVE SURVEYED THE ABOVE DESCRIBED PROPERTY AND THE ABOVE MAP IS A TRUE REPRESENTATION THEREOF AND SHOWS THE SIZE AND LOCATION OF THE PROPERTY, THE LOCATION OF ALL VISIBLE STRUCTURES AND DIMENSIONS OF ALL PRINCIPAL BUILDINGS THEREON, BOUNDARY FENCES, APPARENT EASEMENTS, ROADWAY AND VISIBLE ENCROACHMENTS, IF ANY.

THIS SURVEY IS MADE FOR THE PRESENT OWNERS OF THE PROPERTY, AND ALSO THOSE WHO PURCHASE, OR GUARANTEE THE TITLE THERETO WITHIN (1) YEAR FROM THE DATE HEREOF.

DATED AT WATERFORD, WI THIS 2nd DAY OF MARCH 2007

RECERTIFIED _____ *Gary B. Foat*

ZOP - 70A

007 - 2540