


HAROLD N. KOLB

REGISTERED PROFESSIONAL LAND SURVEYOR
LAKE GENEVA, WISCONSIN

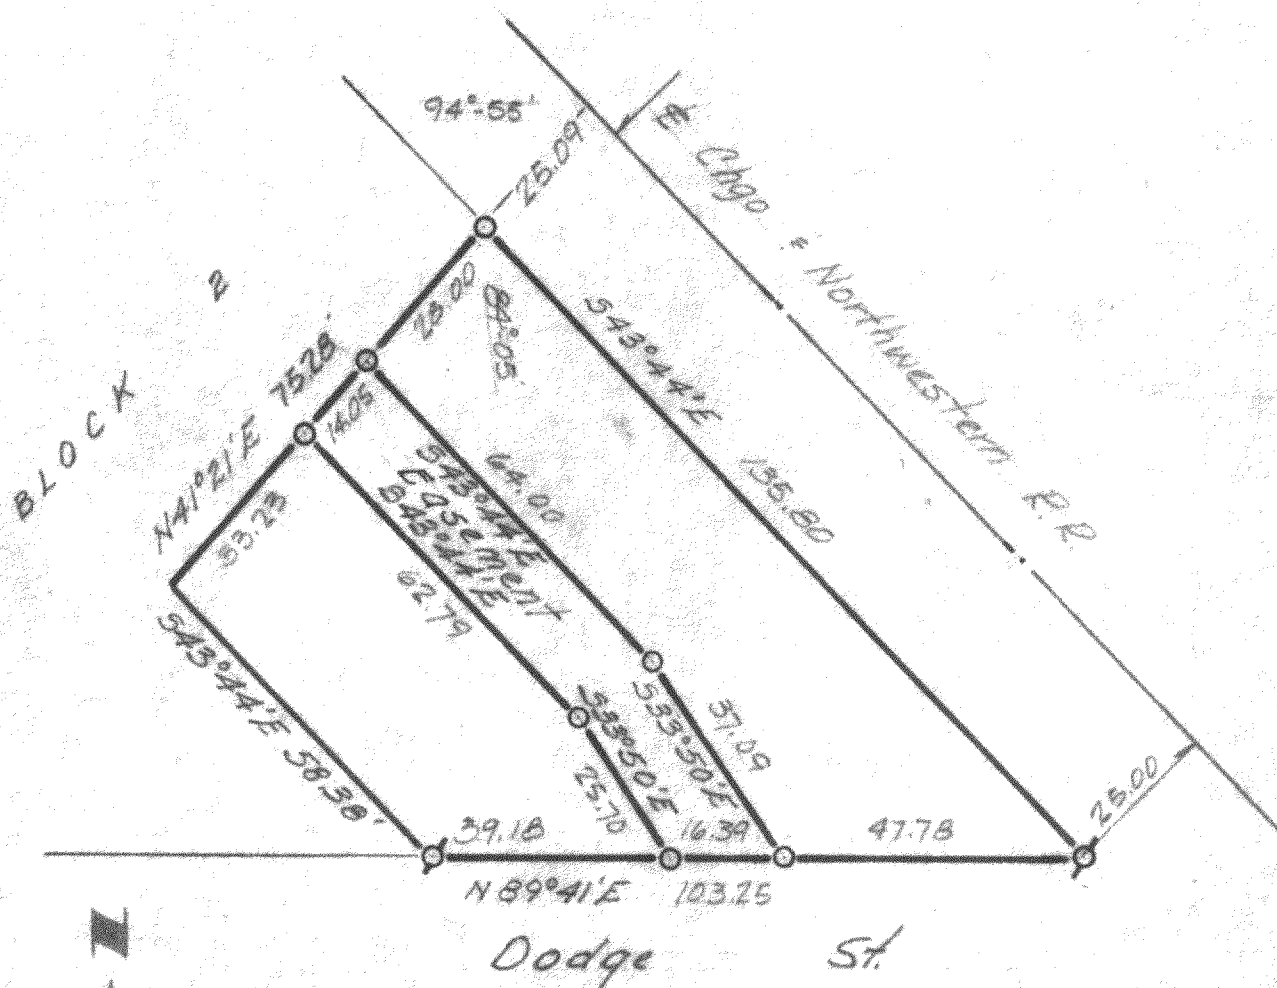

SCALE 1"=30'
LEGEND

♂ - IRON PIPE FOUND
 ○ - IRON PIPE PLACED
 ● - CONCRETE MONUMENT
 X - SPIKE

I, HAROLD H. KOLB, DO HEREBY CERTIFY THAT I HAVE SURVEYED THE PROPERTY HEREON DESCRIBED ACCORDING TO THE OFFICIAL RECORDS, AND THAT THE PLAT HEREON IS A CORRECT REPRESENTATION OF THE LOT LINES.

Harold H. Kolb
HAROLD H. KOLB
WISCONSIN REGISTERED LAND SURVEYOR, S-187
DATE May 31, 1967

7-255

LG-234

OP-32

1 of 2 sheets

HAROLD H. KOLB

REGISTERED PROFESSIONAL LAND SURVEYOR
LAKE GENEVA, WISCONSIN

PLAT OF SURVEY OF

A parcel of land located in Block 2, Village, now City, of Lake Geneva, Walworth County, Wisconsin and described as follows; to-wit: Beginning at the intersection of the South line of said Block 2 and the Southwesterly Right-of-Way line of the Chicago and Northwestern Railroad; thence S 89°41' W 103.25 feet; thence N 43°44' W 58.38 feet; thence N 41°21' E 75.28 feet to said Right-of-Way line; thence S 43°44' E 135.80 feet to the place of beginning.

Subject to an easement to provide ingress and egress and described as follows; to-wit: commencing at the intersection of the South line of said Block 2 and the Southwesterly Right-of-Way line of the Chicago and Northwestern Railroad; thence S 89°41' W 47.78 feet to the place of beginning; thence continue S 89°41' W 16.39 feet; thence N 33°50' W 25.70 feet; thence N 43°44' W 62.79 feet; thence N 41°21' E 14.05 feet; thence S 43°44' E 64.00 feet; thence S 33°50' E 37.09 feet to the place of beginning.

LEGEND

- ⌘ - IRON PIPE FOUND
- - IRON PIPE PLACED
- - CONCRETE MONUMENT
- X - SPIKE

I, HAROLD H. KOLB, DO HEREBY CERTIFY THAT I HAVE SURVEYED THE PROPERTY HEREON DESCRIBED ACCORDING TO THE OFFICIAL RECORDS, AND THAT THE PLAT HEREON IS A CORRECT REPRESENTATION OF THE LOT LINES.

Harold H. Kolb

HAROLD H. KOLB

WISCONSIN REGISTERED LAND SURVEYOR, S-187

DATE May 31, 1967

7-255

LG-233