

PREPARED FOR
FRED GELDERMANN
REMAX GENEVA REALTY
101 BROAD ST. SUITE 102
LAKE GENEVA WI. 53147

PLAT OF SURVEY

-OF-




LOT 3, BLOCK 3 OF WHEELER'S ADDITION TO THE CITY OF LAKE GENEVA,
LOCATED IN THE SOUTHWEST 1/4 OF SECTION 25, TOWN 2 NORTH, RANGE
17 EAST, CITY OF LAKE GENEVA, WALWORTH COUNTY, WISCONSIN.

KROTT SURVEYING INC.

N3705 WILLOW BEND LANE
LAKE GENEVA WI. 53147
PHONE # (262)248-3697
FAX # (262)249-0639

C.L. GRANT STREET

(60' WIDE)

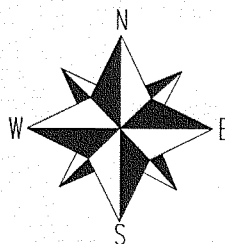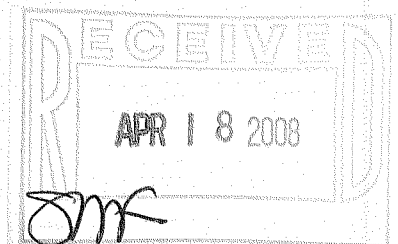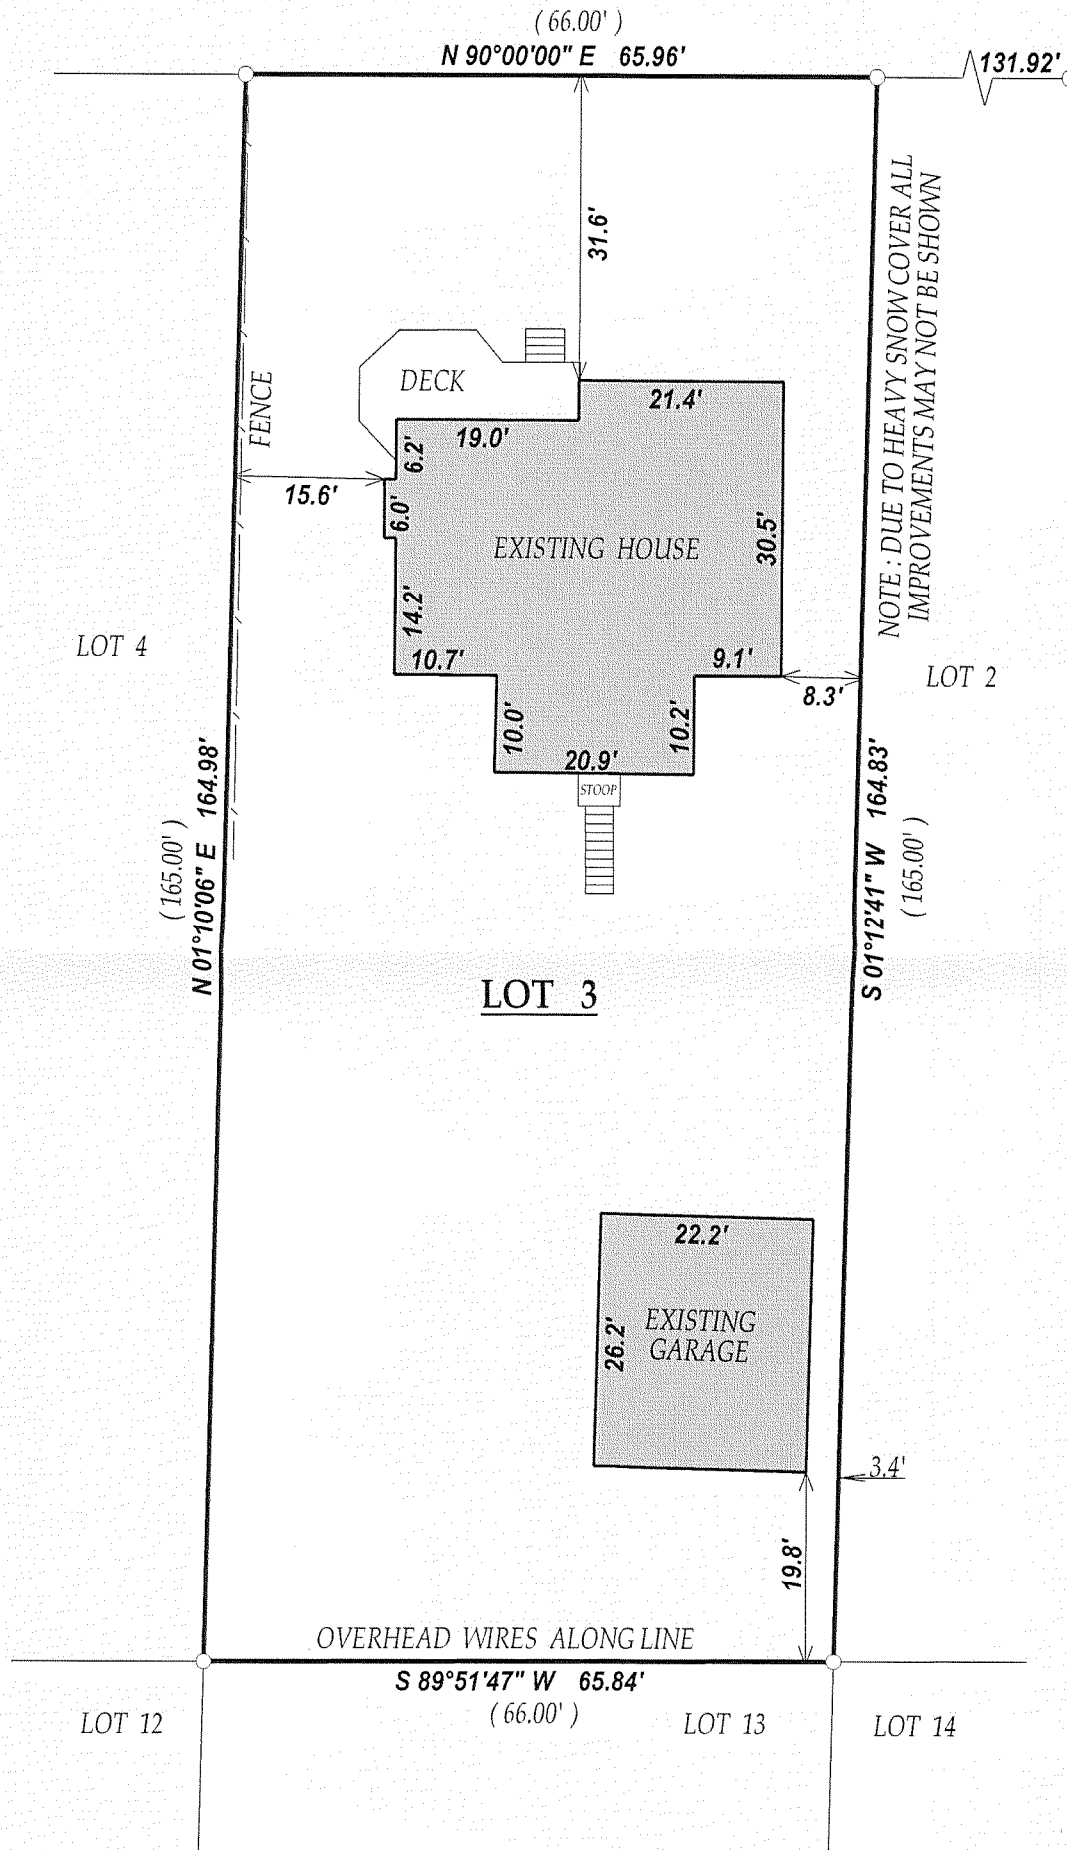

SCALE 1" = 20'


0 20 40 60

LEGEND

○ FOUND IRON PIPE

(XX) RECORDED AS

JOB # 08-018 TAX ID # ZWH00011A
DATED THIS THE 19th DAY OF FEBRUARY 2008.

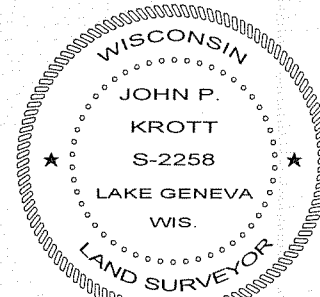

John P. Krott
JOHN KROTT S - 2258
Wisconsin Registered Land Surveyor
(original if signed in red)

ZWH-11A

007-2592