

PREPARED FOR:
JIM McCULLOUGH
694 WELLS ST.
LAKE GENEVA, WI 53147

PLAT OF SURVEY


-OF-

LOT 7 IN BLOCK ONE IN GENEVA BAY ESTATES, LOCATED IN THE NORTHWEST 1/4, NORTHEAST 1/4, OF SECTION 2, TOWNSHIP 1 NORTH, RANGE 17 EAST, AND THE SOUTHWEST 1/4, SOUTHEAST 1/4 OF SECTION 35, TOWNSHIP 2 NORTH, RANGE 17 EAST, CITY OF LAKE GENEVA; THE SOUTHEAST 1/4, THE SOUTHWEST 1/4, OF SECTION 35, TOWNSHIP 2 NORTH, RANGE 17 EAST; AND THE NORTHEAST 1/4, NORTHWEST 1/4, SECTION 2 TOWN 1 NORTH, RANGE 17 EAST, IN THE CITY OF LAKE GENEVA, WALWORTH COUNTY, WISCONSIN.

KROTT SURVEYING INC.

N3705 WILLOW BEND LANE
LAKE GENEVA WI. 53147
PHONE # (262)248-3697
FAX # (262)249-0639

C.L. BAY VIEW DRIVE
(60' WIDE)


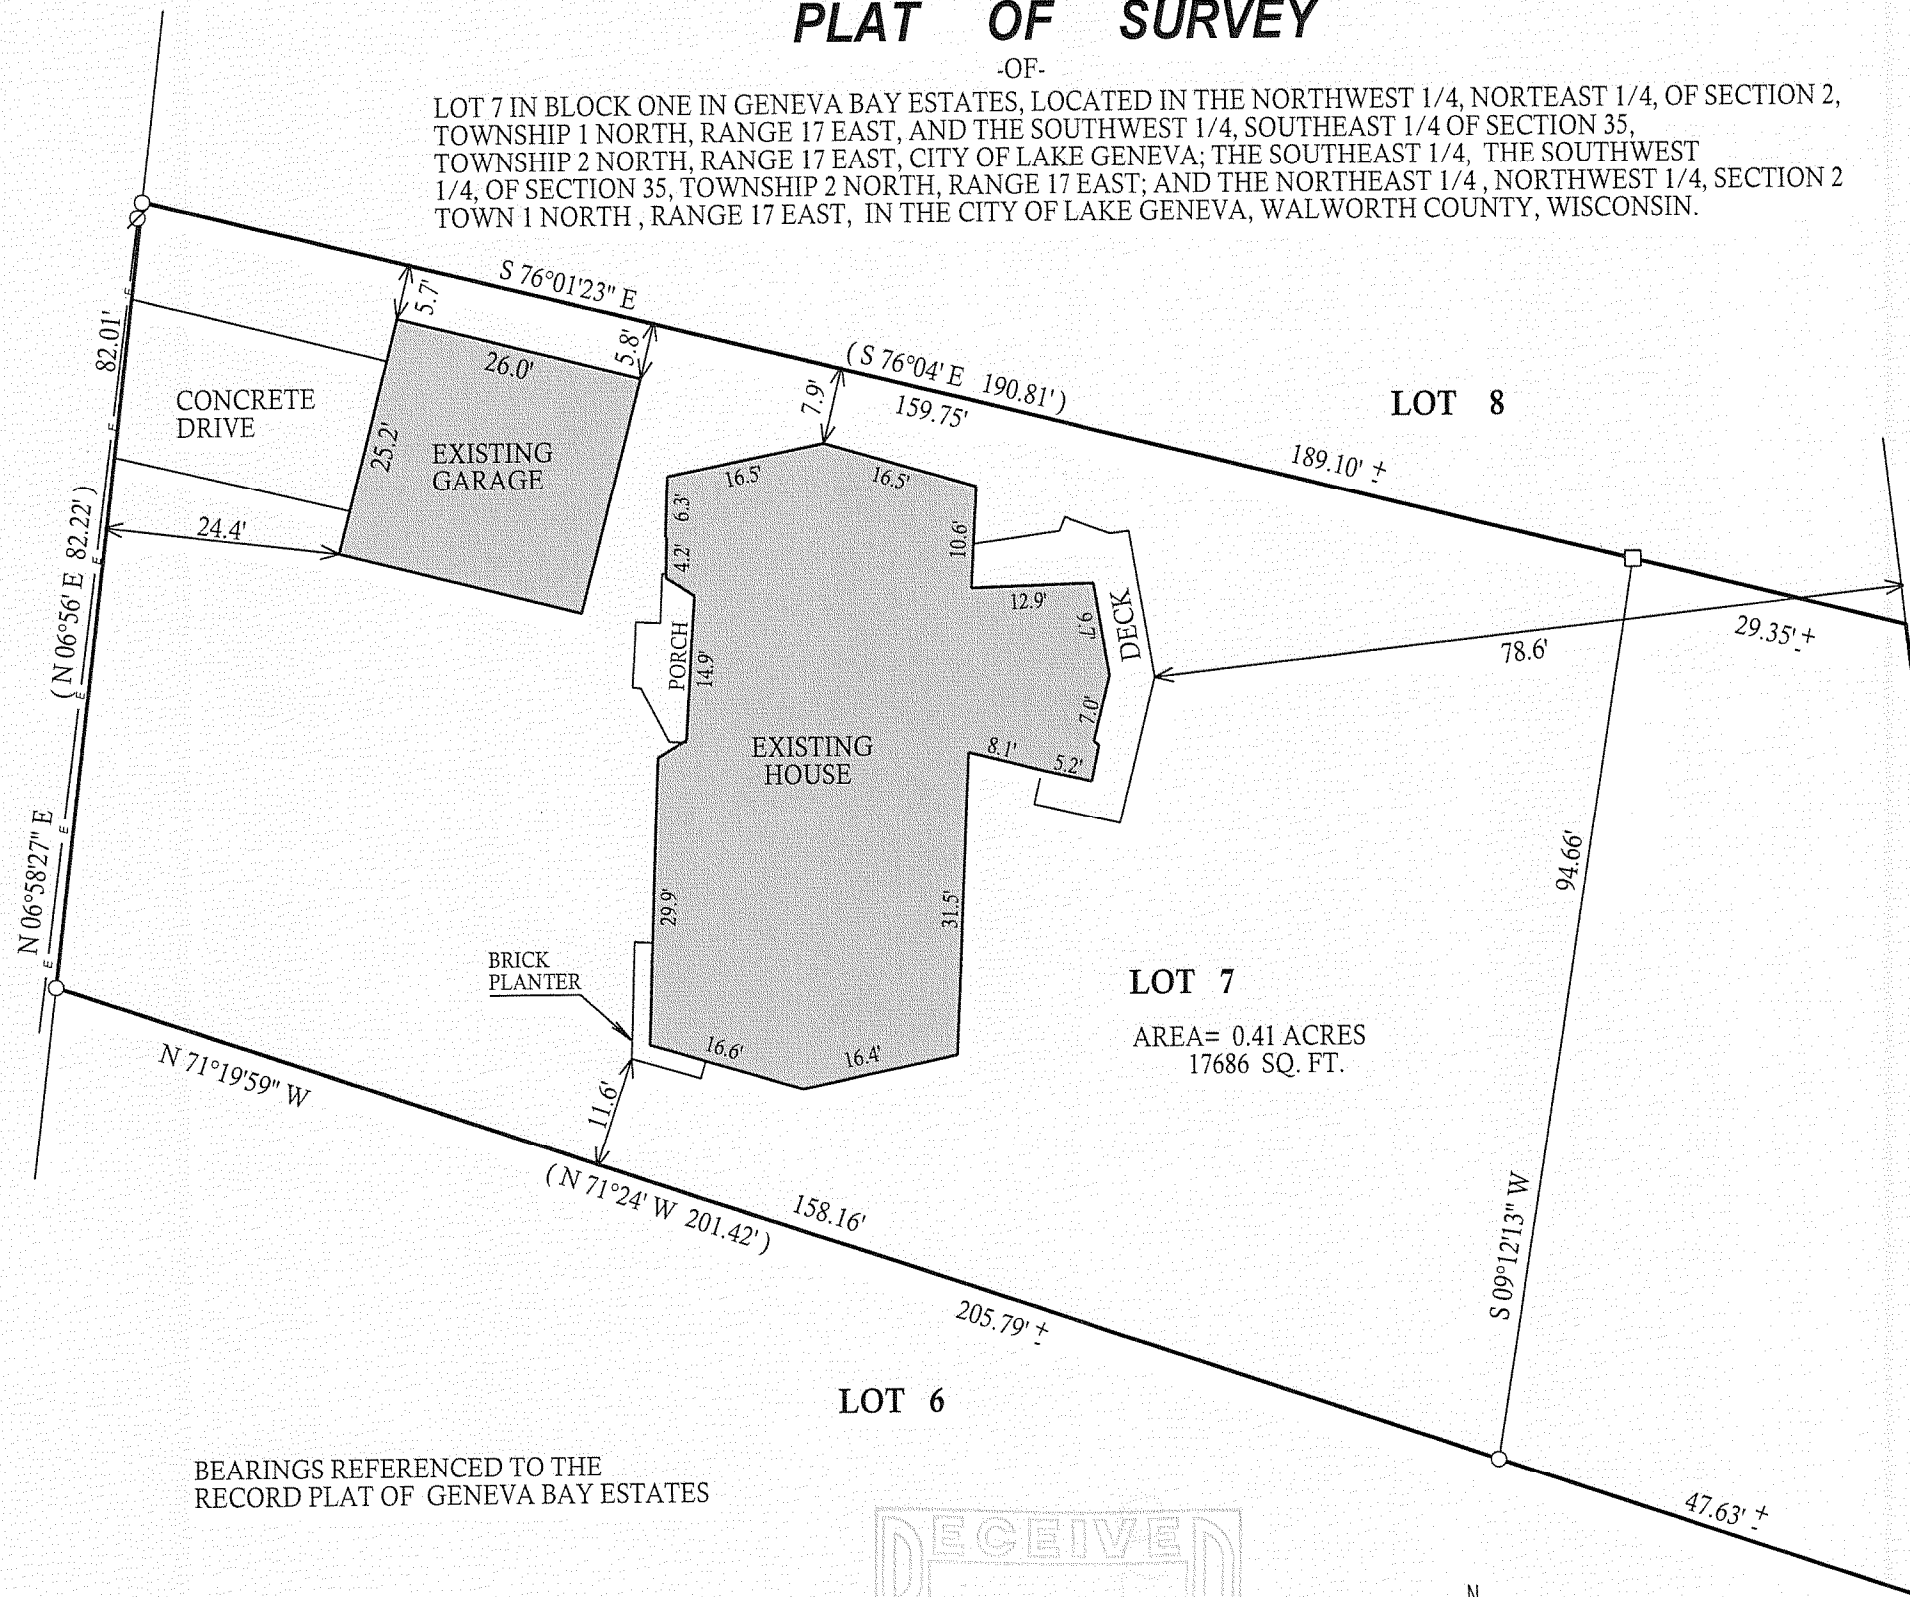


LEGEND


- OVERHEAD UTILITIES
- Ø UTILITY POLE
- FOUND IRON PIPE
- FOUND IRON BAR
- SET IRON BAR
- (xx) RECORDED AS

JOB # 08-034 TAX ID # ZGB00007

"I hereby certify that I have surveyed the above described property and that the above map is a true representation thereof and shows the size and location of all visible structures, apparent easements and encroachments if any."
This survey is made for the present owners of the property, and those who purchase, mortgage, or guarantee the title thereto, within one year from the date hereof.

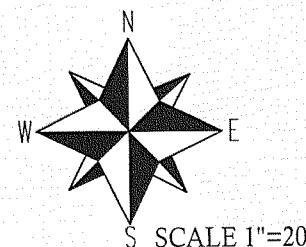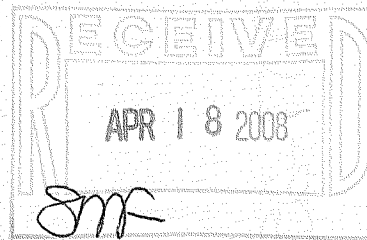

SCALE 1"=20'

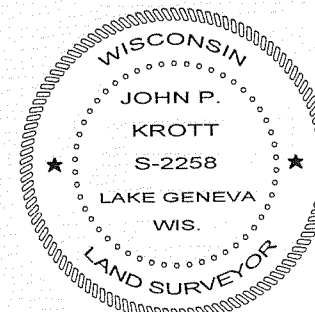

DATED THIS 13th, DAY OF MARCH, 2008

John P. Krott

JOHN KROTT S - 2258
Wisconsin Registered Land Surveyor
(original if signed in red)

007-2595