


ASSIGNED THE EAST LINE OF OUTLOT 1
N 00°13'12" W

PLAT OF SURVEY OUTLOT 1 AND LOT 2 OF CERTIFIED SURVEY MAP NO. 1485

LOCATED IN THE SOUTHWEST 1/4 OF THE SOUTHEAST 1/4 OF SECTION 26, TOWN 2 NORTH,
RANGE 17 EAST, CITY OF LAKE GENEVA, WALWORTH COUNTY, WISCONSIN


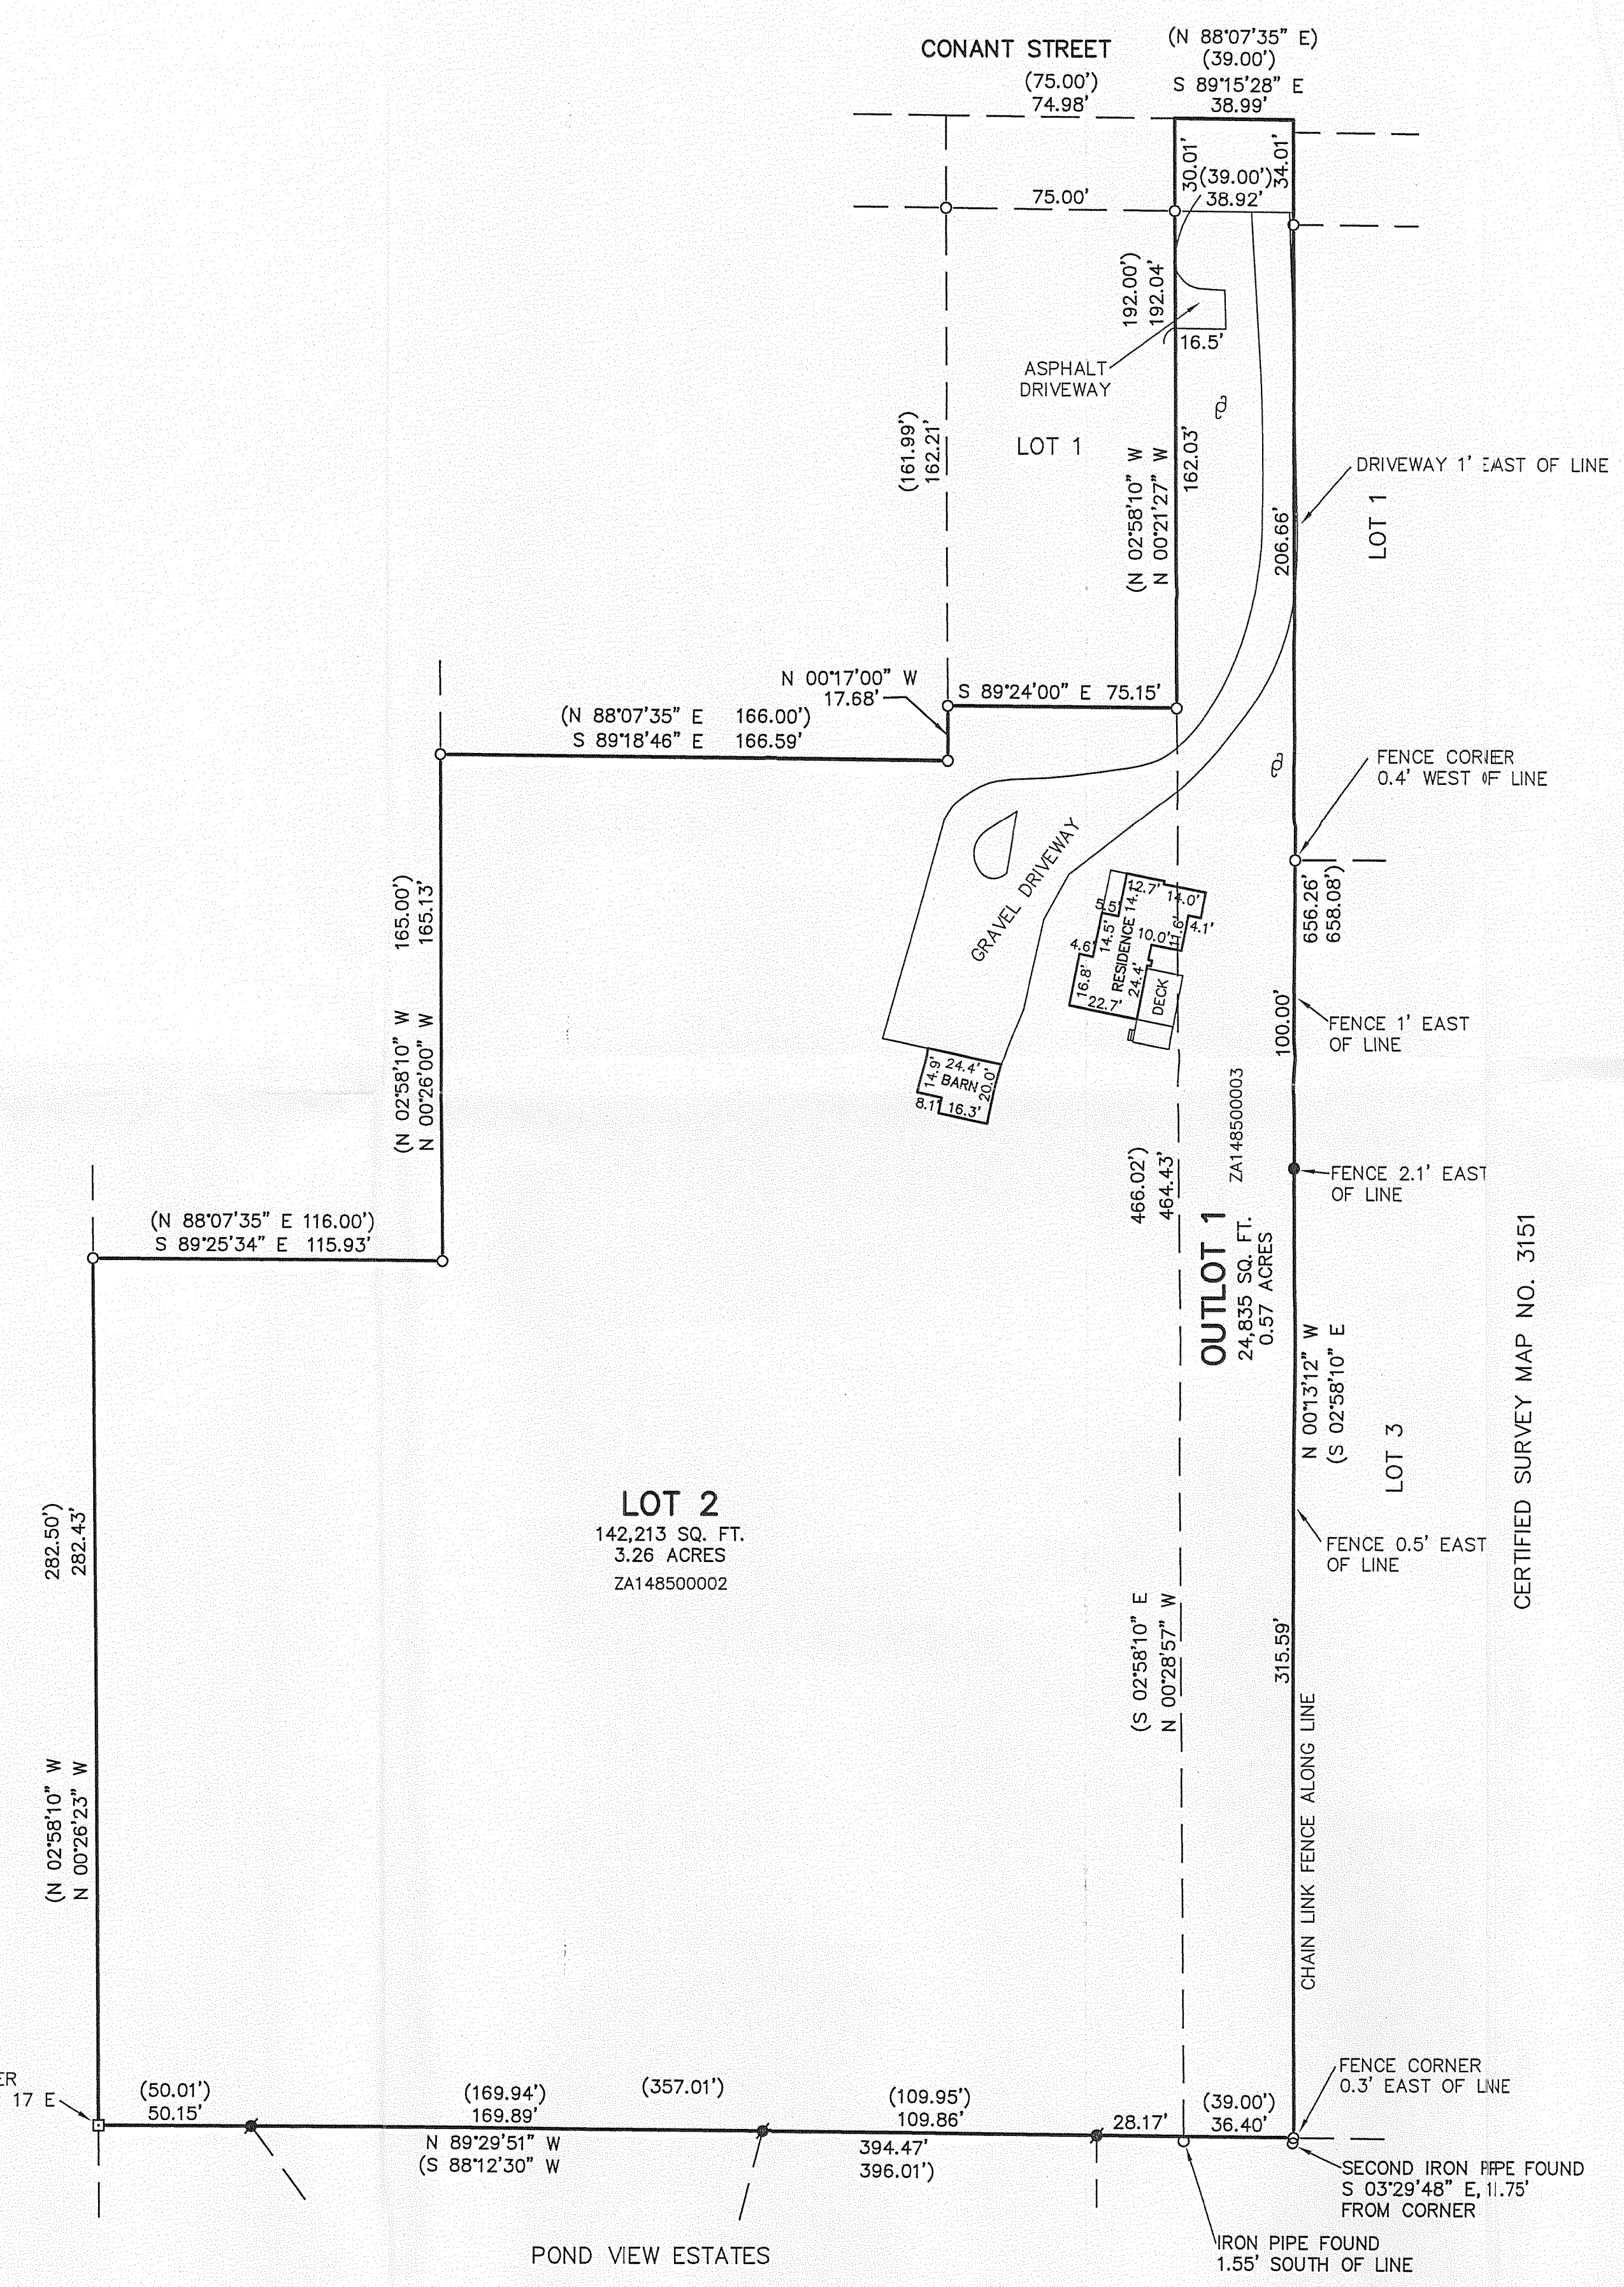


- LEGEND
- - FOUND IRON PIPE STAKE
 - - FOUND IRON REBAR STAKE
 - - FOUND CONCRETE MONUMENT
 - - PLACED IRON REBAR STAKE
 - (XXX) - RECORDED AS
 - - UTILITY POLE

PER RECORD C.S.M.
NOTE: OUTLOT 1 IS RESERVED AS A
PRIVATE ROAD IF LOT 2 IS REDIVIDED.



DATED: 5/28/2008
PETER S. GORDON

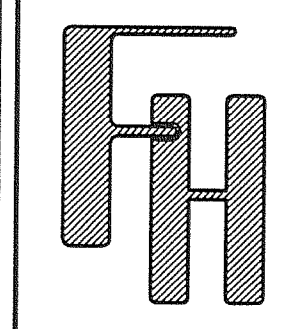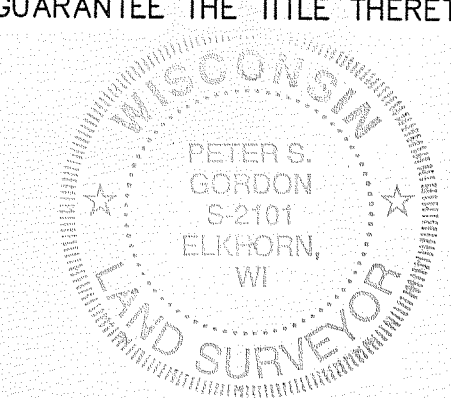

PLAT OF SURVEY

WORK ORDERED BY -
LEONARD JEGERSKI
1804 CONANT STREET
LAKE GENEVA, WI 53147

FARRIS, HANSEN & ASSOCIATES, INC.
ENGINEERING - ARCHITECTURE - SURVEYING
7 RIDGWAY COURT P.O. BOX 437
ELKHORN, WISCONSIN 53121
OFFICE: (262) 723-2098 FAX: (262) 723-5686

REVISIONS

PROJECT NO.
7614
DATE
05/28/2008
SHEET NO.
1 OF 1

ZA1485-2 ZA1485-3

007-2605