

PREPARED FOR:
JULIE SARTON
KEEFE REALESTATE, INC.
751 GENEVA PARKWAY
LAKE GENEVA, WI 53147

PLAT OF SURVEY


-OF-

LOT 1 CERTIFIED SURVEY MAP NO. 1454, BEING PART OF
LOTS 6 AND 7, BLOCK 17 OF GENEVA LAKE CRAWFORD
MANUFACTURING COMPANY SUBDIVISION, LOCATED IN
T.2.N., R.17.E., CITY OF LAKE GENEVA, WALWORTH COUNTY,
WISCONSIN.

KROTT SURVEYING INC.

N3705 WILLOW BEND LANE
LAKE GENEVA WI. 53147
PHONE # (262)248-3697
FAX # (262)249-0639

CENTER STREET

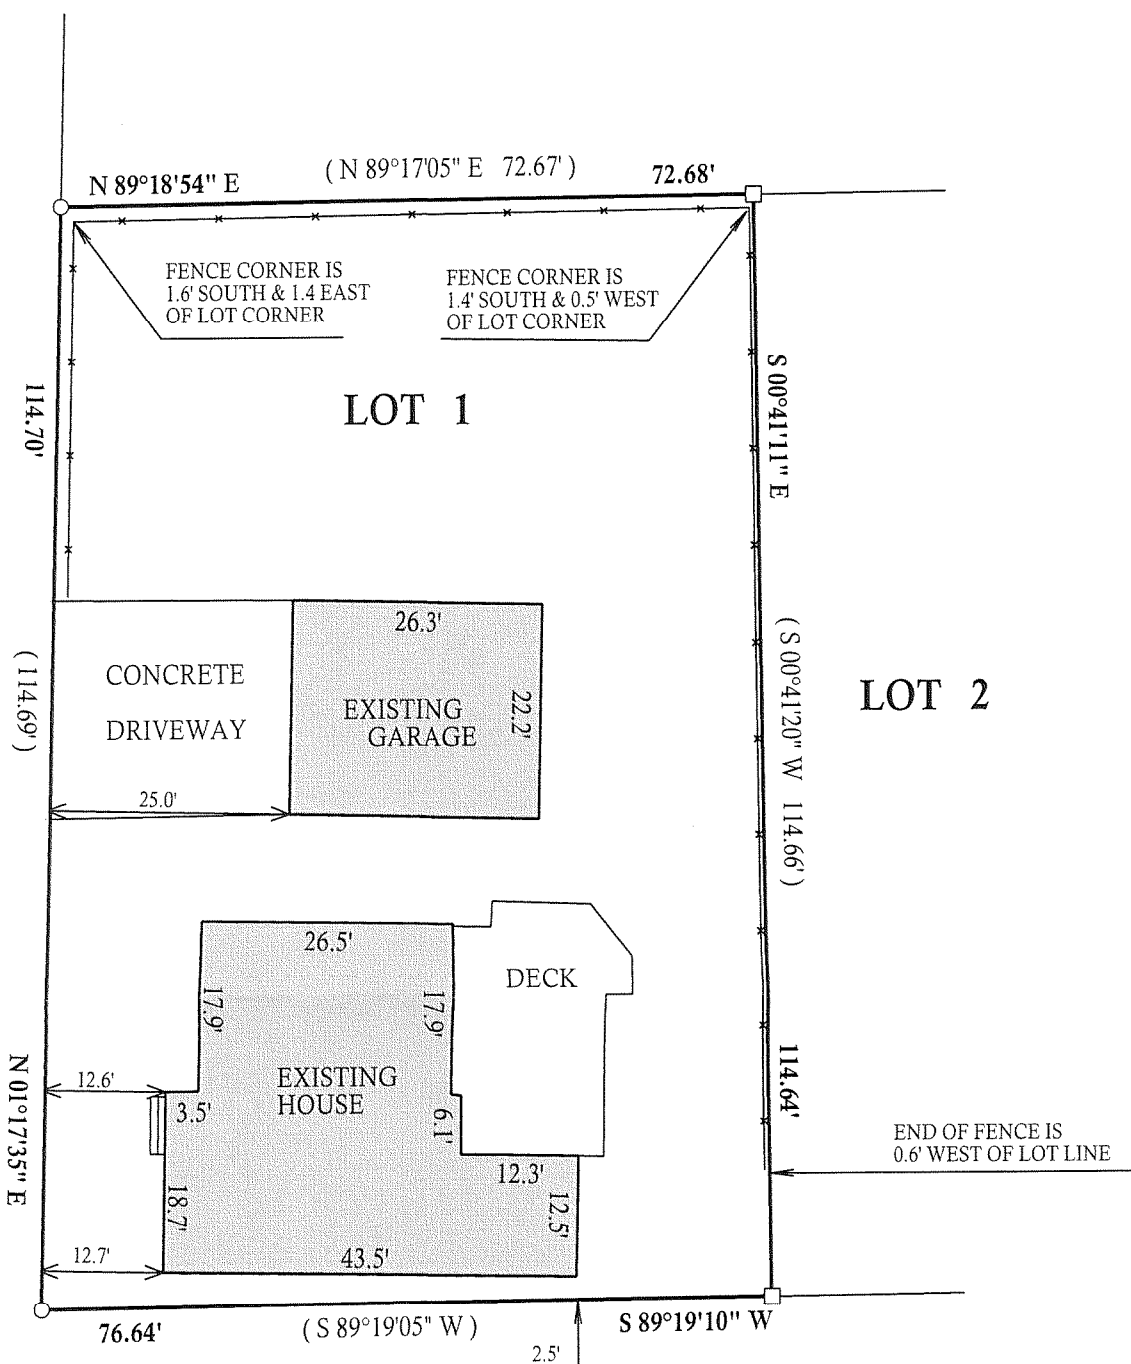


LEGEND

- FOUND IRON PIPE
- FOUND IRON BAR
- (XX) RECORDED AS
- x— WOOD FENCE

JOB # 08-192


TAX ID # ZA145400001

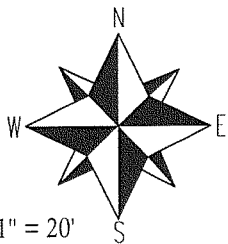

SCALE 1" = 20'

"I hereby certify that I have surveyed the above described property and that the above map is a true representation thereof and shows the size and location of all visible structures, apparent easements and encroachments if any."
This survey is made for the present owners of the property, and those who purchase, mortgage, or guarantee the title thereto, within one year from the date hereof.

INTERVIEW
DEC - 1 2008
SMC

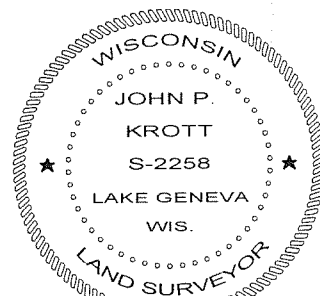

DATED THIS 2nd, DAY OF SEPTEMBER, 2008

John P. Krott

JOHN KROTT S - 2258
Wisconsin Registered Land Surveyor
(original if signed in red)

007-2637