

PREPARED FOR
MARK LARKEN
COLDWELL BANKER PRIMUS
226 BROAD ST.
LAKE GENEVA WI. 53147

PLAT OF SURVEY

-OF-




KROTT SURVEYING INC.

N3705 WILLOW BEND LANE
LAKE GENEVA WI. 53147
PHONE # (262)248-3697
FAX # (262)249-0639


LOT 1 TOWNLINE TRAILS SUBDIVISION LOCATED IN PART OF THE
NORTHEAST 1/4 OF THE NORTHWEST 1/4 AND THE SOUTHEAST 1/4
OF THE NORTHWEST 1/4 OF SECTION 6, ALL IN TOWN 1 NORTH,
RANGE 18 EAST, CITY OF LAKE GENEVA, WALWORTH COUNTY, WISCONSIN.

C.L. TOWNLINE ROAD

(93' WIDE)

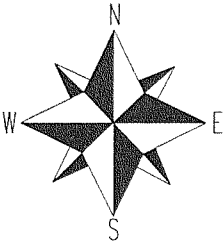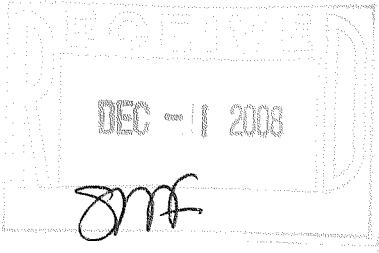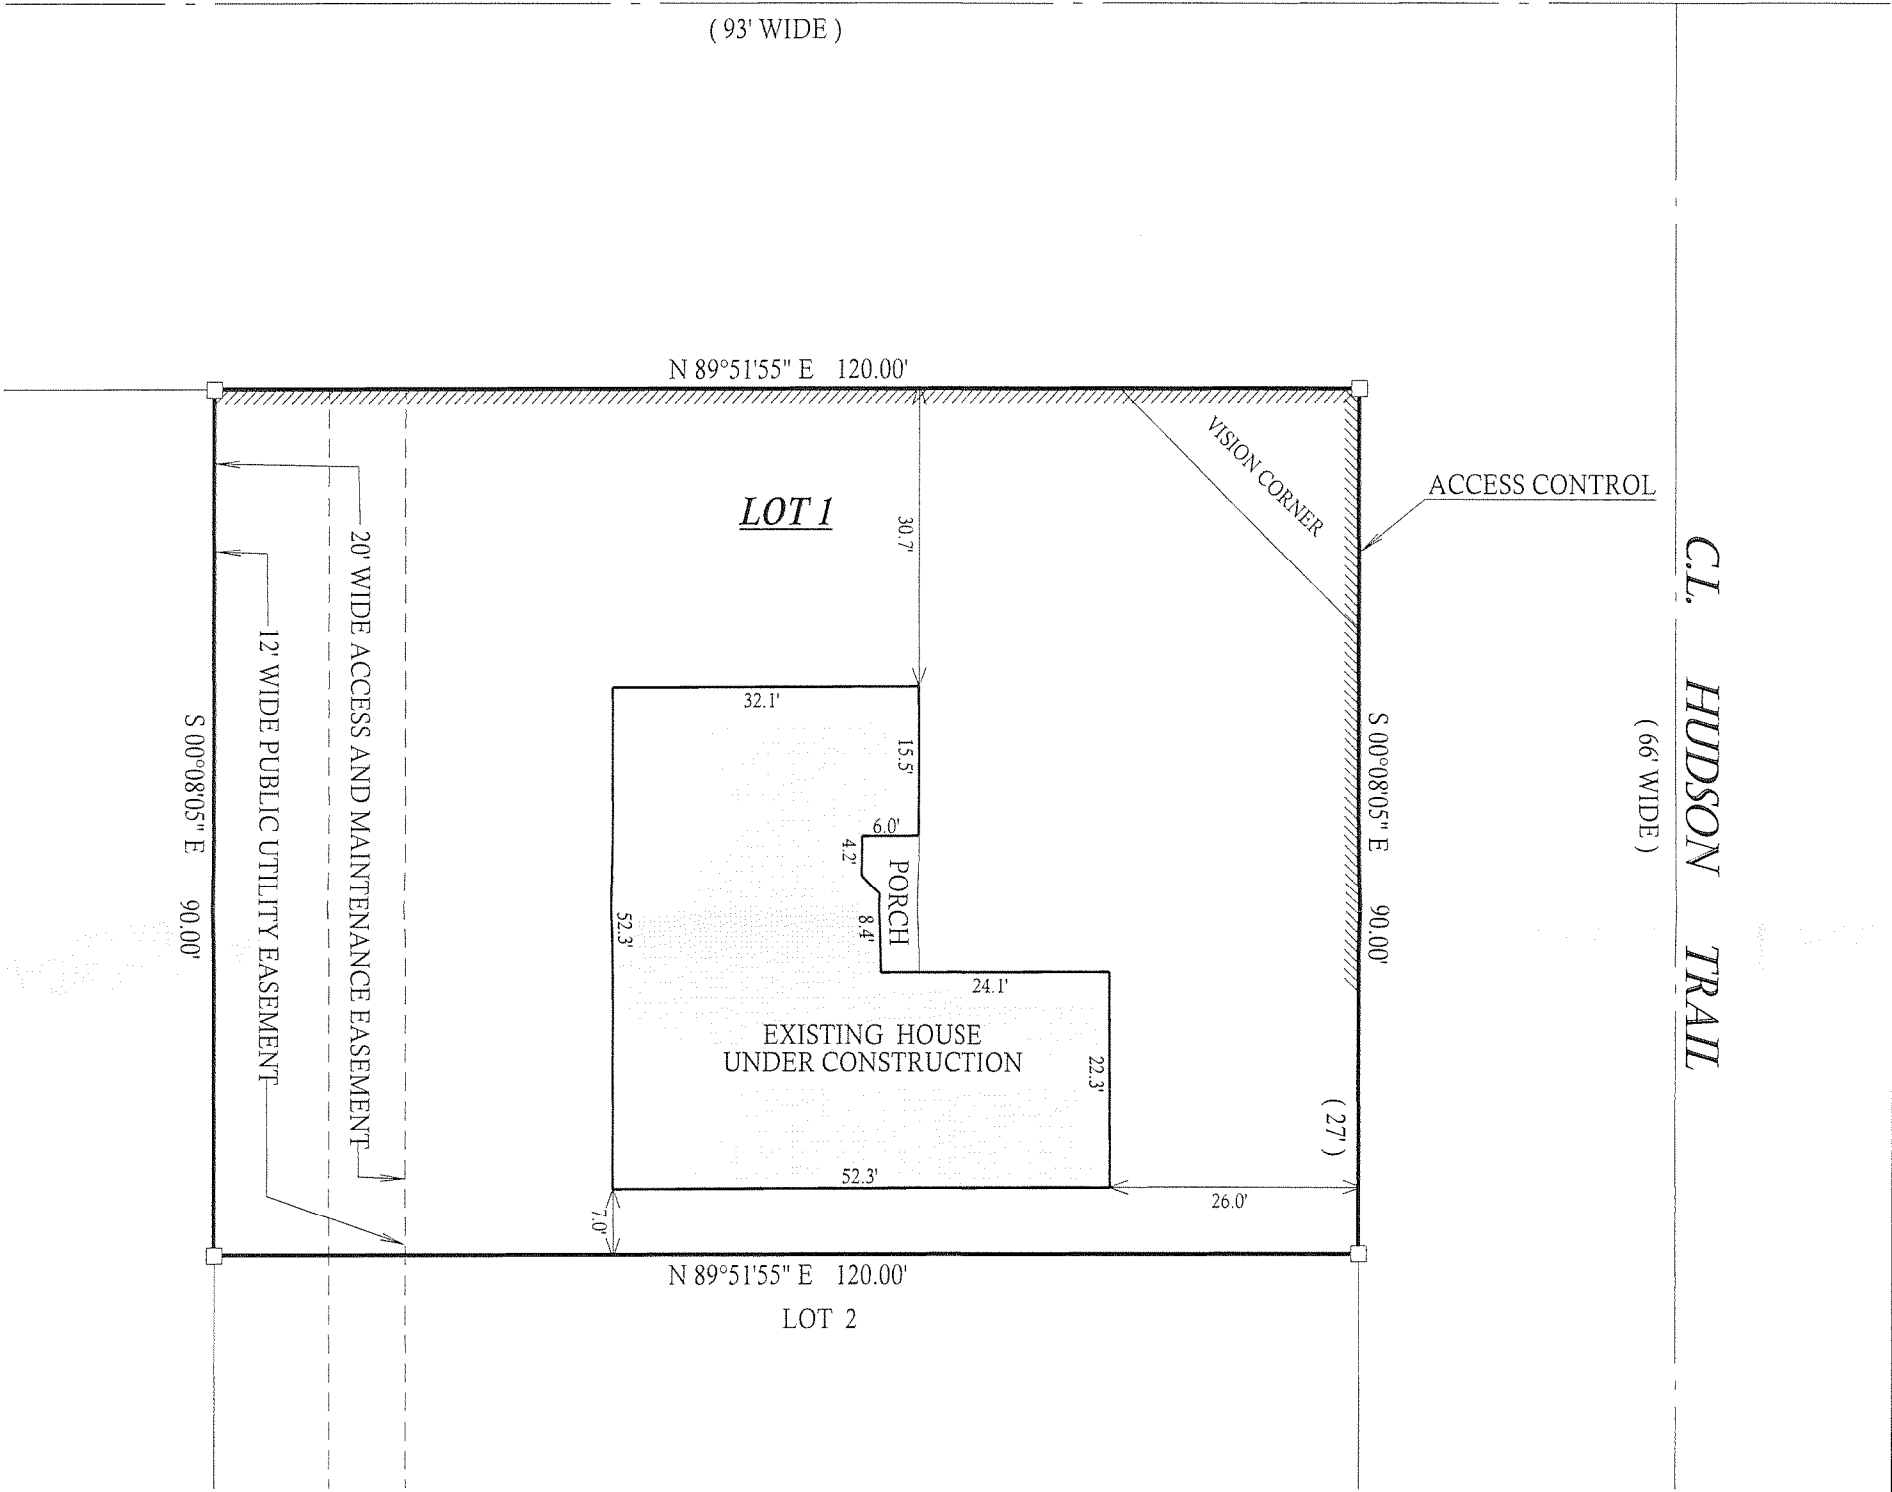


SCALE 1" = 30'

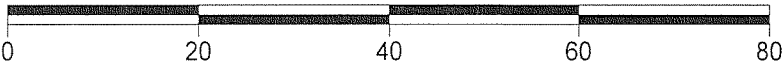

COMPARE LEGAL DESCRIPTION ABOVE AND DRAWING WITH DEED.
FOR BUILDING RESTRICTIONS AND EASEMENTS NOT SHOWN, REFER
TO DEED, ABSTRACT SOURCES AND LOCAL MUNICIPAL CODES. NOTIFY
THE SURVEYOR IMMEDIATELY OF ANY DISCREPANCY.

"I hereby certify that I have surveyed the above described property and that
the above map is a true representation thereof and shows the size and
location of all visible structures, apparent easements and encroachments
if any."

This survey is made for the present owners of the property, and those who
purchase, mortgage, or guarantee the title thereto, within one year from
the date hereof.

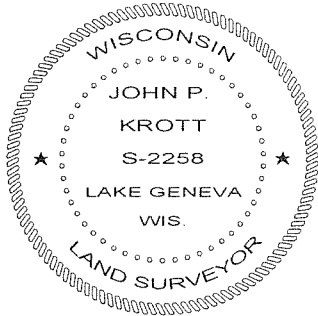

DATE OF LAST REVISION 10-16-2008.

John P. Krott

JOHN KROTT S - 2258
Wisconsin Registered Land Surveyor
(original if signed in red)

LEGEND

□ FOUND IRON BAR

JOB # 08-191AB TAX ID # ZTT00001

DATED THIS THE 28th DAY OF AUGUST 2008.

007 - 2640