



PREPARED FOR:
MARI SCHWARZ
622 CENTER ST.
LAKE GENEVA, WI
53147

KROTT SURVEYING INC.
N3705 WILLOW BEND LANE
LAKE GENEVA WI. 53147
PHONE # (262)248-3697
FAX # (262)249-0639

PLAT OF SURVEY

-OF-

THE SOUTH 54 FEET OF THE NORTH 111 FEET, OF THE EAST
130 FEET OF LARGE LOT 48 IN FERGUSON'S ADDITION IN THE
CITY OF LAKE GENEVA, WALWORTH COUNTY, WISCONSIN.

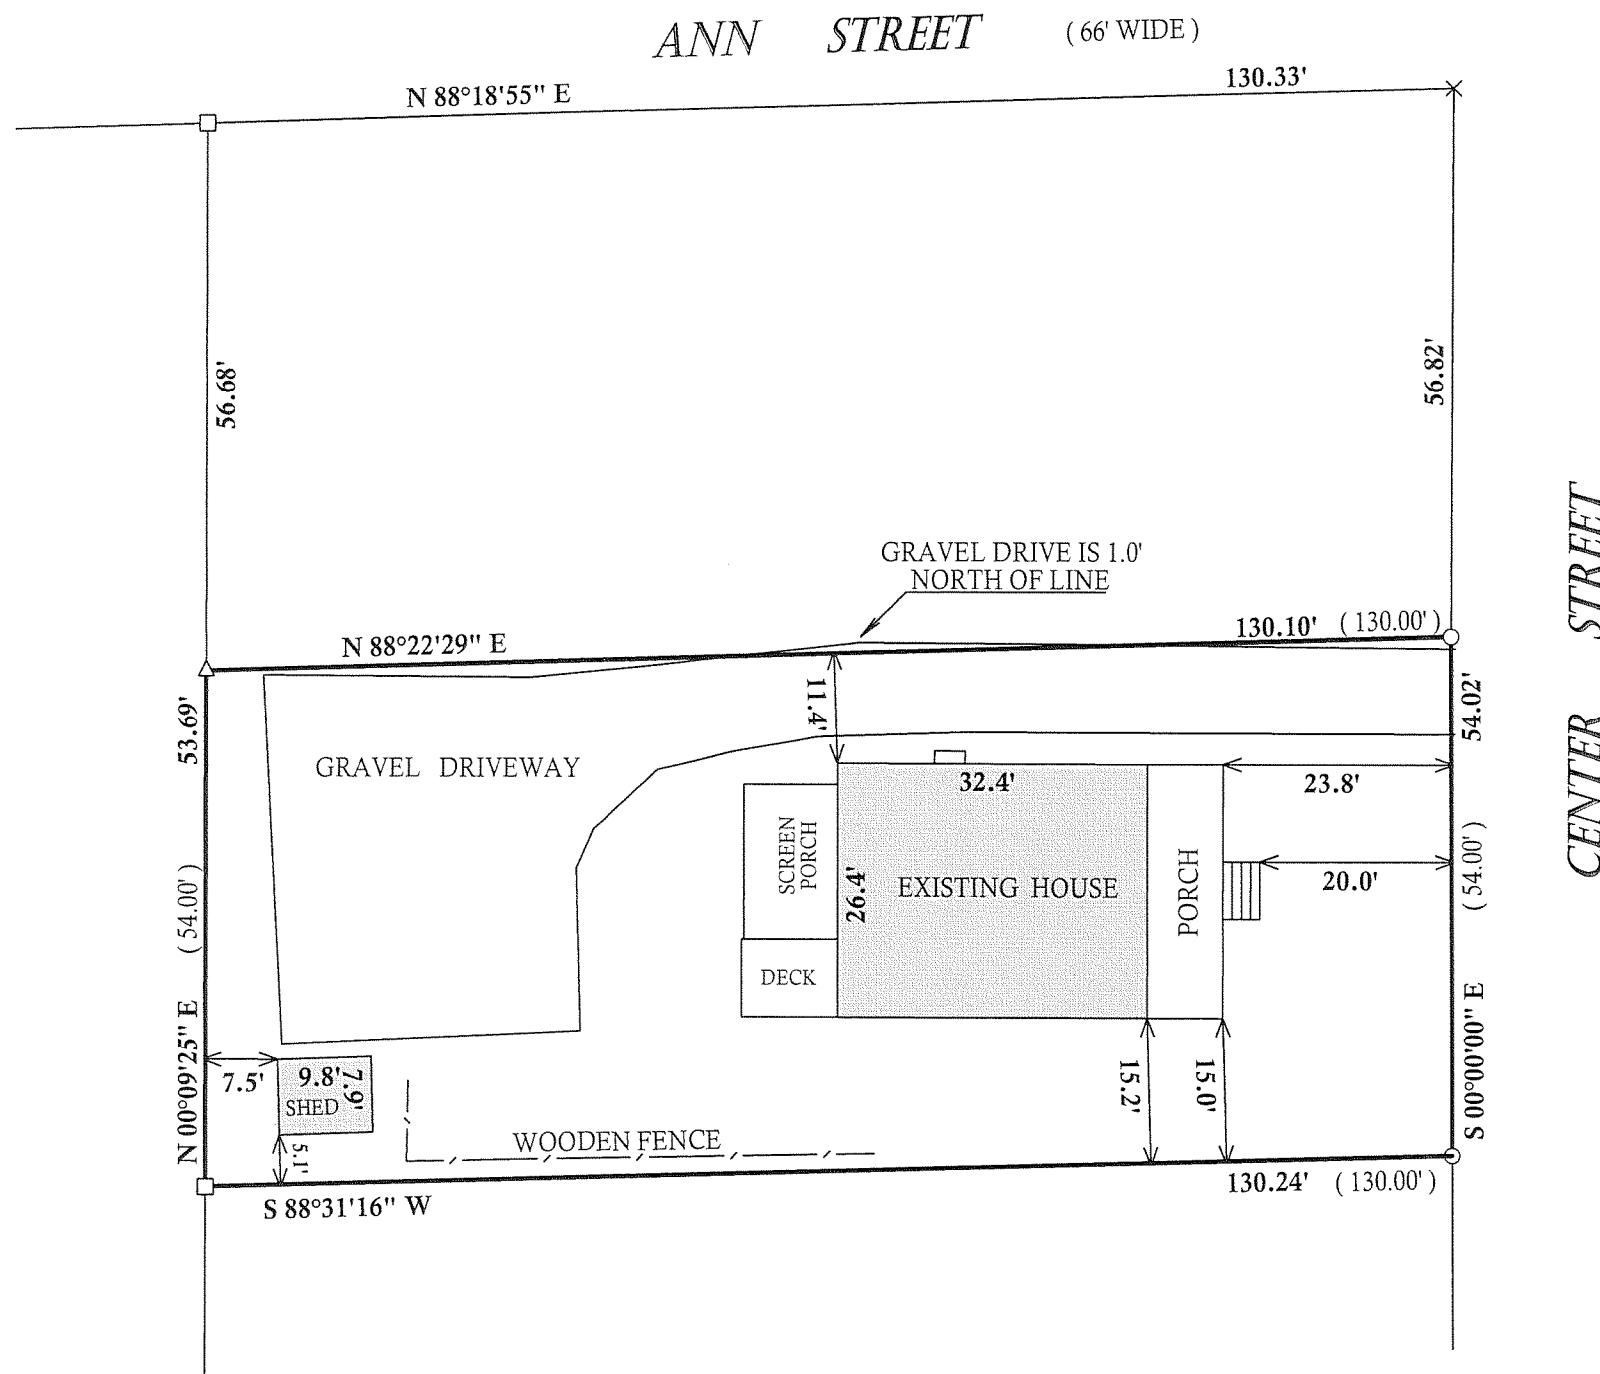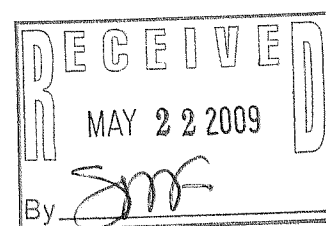

LEGEND


- FOUND IRON PIPE
- FOUND IRON BAR
- × FOUND CUT CROSS IN CONCRETE
- △ SET 8" SPIKE IN BASE OF A 12" DIA. TREE
- (XX) RECORDED AS

JOB # 09-024 TAX ID # ZF00057

COMPARE LEGAL DESCRIPTION ABOVE AND DRAWING WITH DEED.
FOR BUILDING RESTRICTIONS AND EASEMENTS NOT SHOWN. REFER
TO DEED, ABSTRACT SOURCES AND LOCAL MUNICIPAL CODES. NOTIFY
THE SURVEYOR IMMEDIATELY OF ANY DISCREPANCY.



"I hereby certify that I have surveyed the above described property and that
the above map is a true representation thereof and shows the size and
location of all visible structures, apparent easements and encroachments
if any."

This survey is made for the present owners of the property, and those who
purchase, mortgage, or guarantee the title thereto, within one year from
the date hereof.

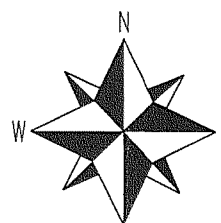

SCALE 1"=20'

BASIS OF BEARING WAS THE RECORD PLAT

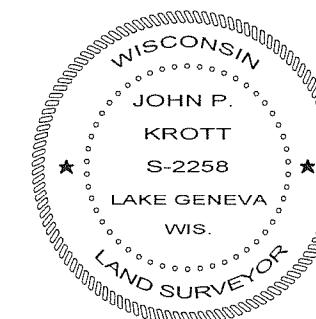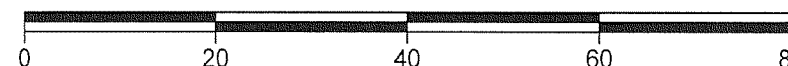

DATED THIS 1st, DAY OF APRIL, 2009

John P. Krott

JOHN KROTT S - 2258
Wisconsin Registered Land Surveyor
(original if signed in red)

007-2654