


23. Jan. 22, 1921

Survey of lands formerly
Dillenbeek. (mill reserva-

Found iron stake under root
lot. Measured S. W. from
"Red Mill lot" 30' and
Then South 15" and
lot. thence S. $29\frac{1}{2}$ ' for S. E.
Cor. Tom Day's lot. (no stake) then
S. $30\frac{1}{2}$ ' to S. E. Cor. S. De Blaze lot
measured E. on N line alley 40. from
W. fence. Peter Gavin lot to E. fence same
lot. (O.K.) Then 33' to E. line of
Dillenbeck lot. Then 40' to S. E.
Cor. S. De Blaze lot & set iron stk
Measured across middle of P. Gavin lot 40' O.K.
Measured 40' + 33' straight E. from N. W. Cor.
P. Gavin lot. and found E fence Dillenbeck
lot on line. sighted thru from N. E. Cor.
S. De Blaze lot to angle in N line Gavin
lot and found old post hole. N. W. Cor. S.
De Blaze lot on line. Measured south 60'

E. of Block 28,

owned by Tom Day. S. DeBlazer. M.E.
tion) for. ~~the~~ Youell.
of maple tree. N.E. cor. Gus DeBlaze
this in direct line to cor. of
found stone set for angle, and
found iron pipe S.E. Cor. S. DeBlaze
and set iron stake for N.W. cor. of Day
lot. ~~no~~ other stakes requested by Youell.

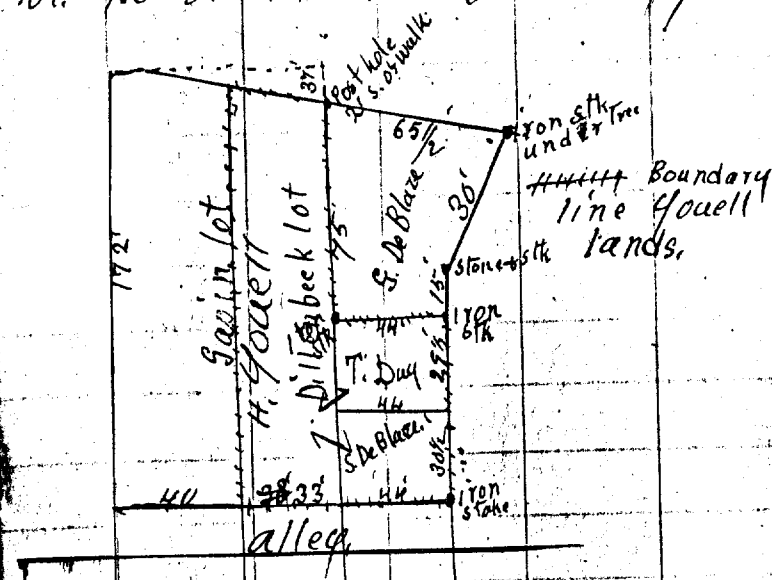

Bessie Palmer, Asst

see plat 121

OP-2924

292 B

293

7-266-Sk