

FARRIS, HANSEN & ASSOCIATES, INC.



ENGINEERING - ARCHITECTURE - SURVEYING
 7 RIDGWAY COURT - P.O. BOX 437 - ELKHORN, WISCONSIN 53121
 PHONE: (262) 723-2098 FAX: (262) 723-5886

- WORK ORDERED BY -
 HOWARD BASSO - BASSO BUILDERS
 405 SKYLINE DRIVE
 LAKE GENEVA, WI 53147



PLAT OF SURVEY

LOT 42 OF MEADOWLAND SUBDIVISION

LOCATED IN SECTION 31,
 TOWN 2 NORTH, RANGE 18 EAST,
 WALWORTH COUNTY, WISCONSIN

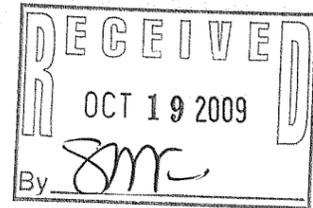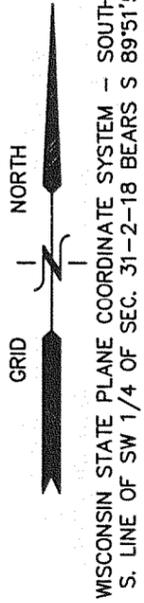

NOTE: SIDE YARD SETBACKS
 ARE TO BE A MINIMUM OF
 6' THAT TOTAL TO 15'

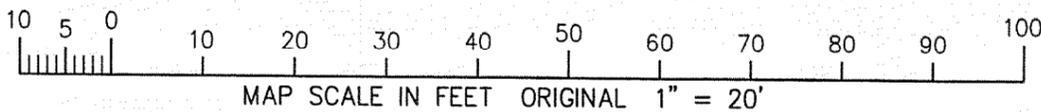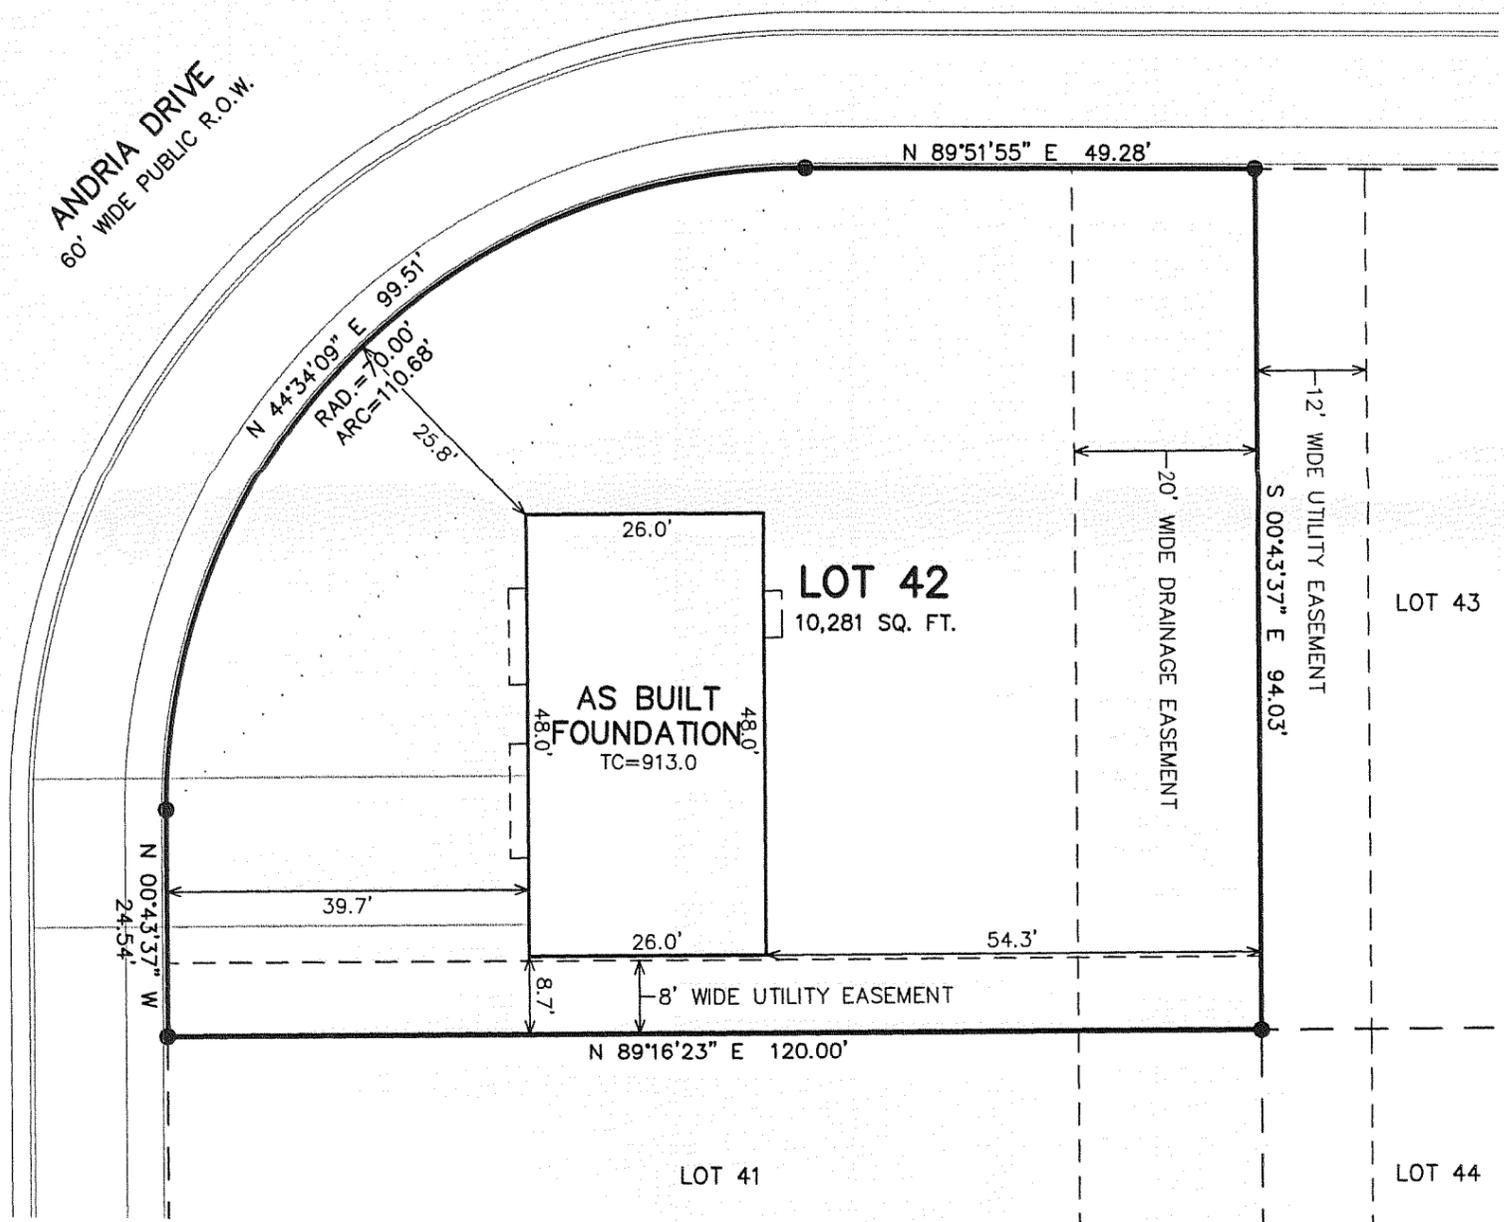

LEGEND

- = FOUND IRON REBAR STAKE
- (XXX) = RECORDED AS

NOTE: COPIES OF THIS MAP TO WHICH THE FOLLOWING CERTIFICATE WILL APPLY SHOW THE SURVEYOR'S ORIGINAL SEAL AND SIGNATURE IN RED INK. COPIES BY ANY OTHER MEANS MAY HAVE ALTERATIONS WHICH DO NOT REPRESENT THE SURVEYOR'S WORK PRODUCT.

I HEREBY CERTIFY THAT THE ABOVE DESCRIBED PROPERTY HAS BEEN SURVEYED UNDER MY DIRECTION AND THAT THE ABOVE MAP IS A TRUE REPRESENTATION THEREOF AND SHOWS THE SIZE AND LOCATION OF THE PROPERTY AND ITS EXTERIOR BOUNDARIES. THIS SURVEY IS MADE FOR THE USE OF THE PRESENT OWNERS OF THE PROPERTY, AND ALSO THOSE WHO PURCHASE, MORTGAGE, OR GUARANTEE THE TITLE THERETO WITHIN ONE YEAR FROM THE DATE HEREOF.

DATED: 6/17/2009

REVISED 08-12-2009
 TO SHOW SIZE & LOCATION OF
 AS BUILT FOUNDATION

Peter S. Gordon
 PETER S. GORDON R.L.S. 2101



PROJECT: 5970.42
 DATE: 06/17/2009
 SHEET 1 OF 1

8/12/2009 X:\Projects\5970\INDIV_LOTS\Lot_42\DCAD\PERMIT

AUG 12 2009 ZMEA-42

007-21075